




273+75

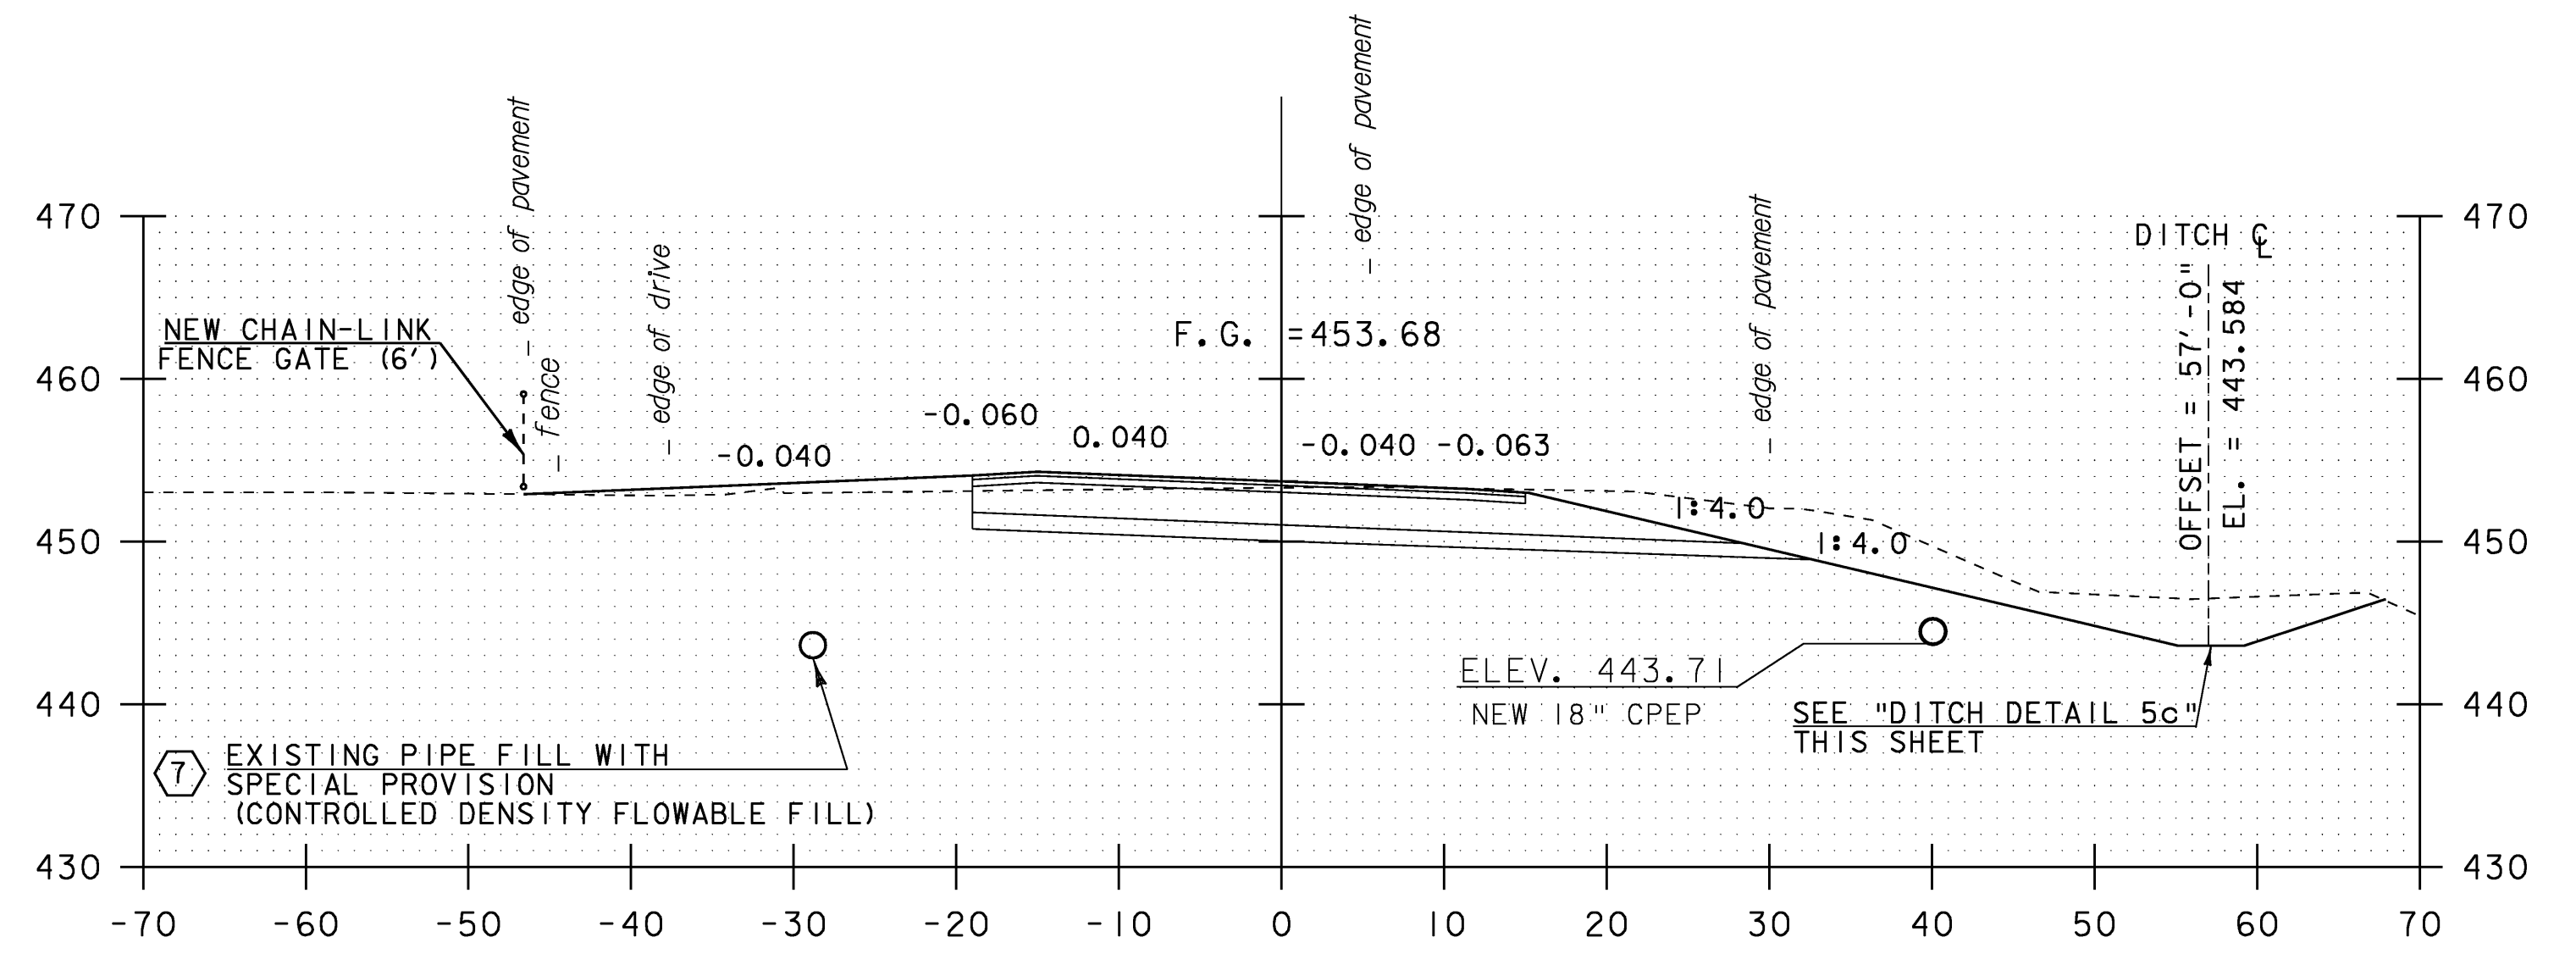

274+00

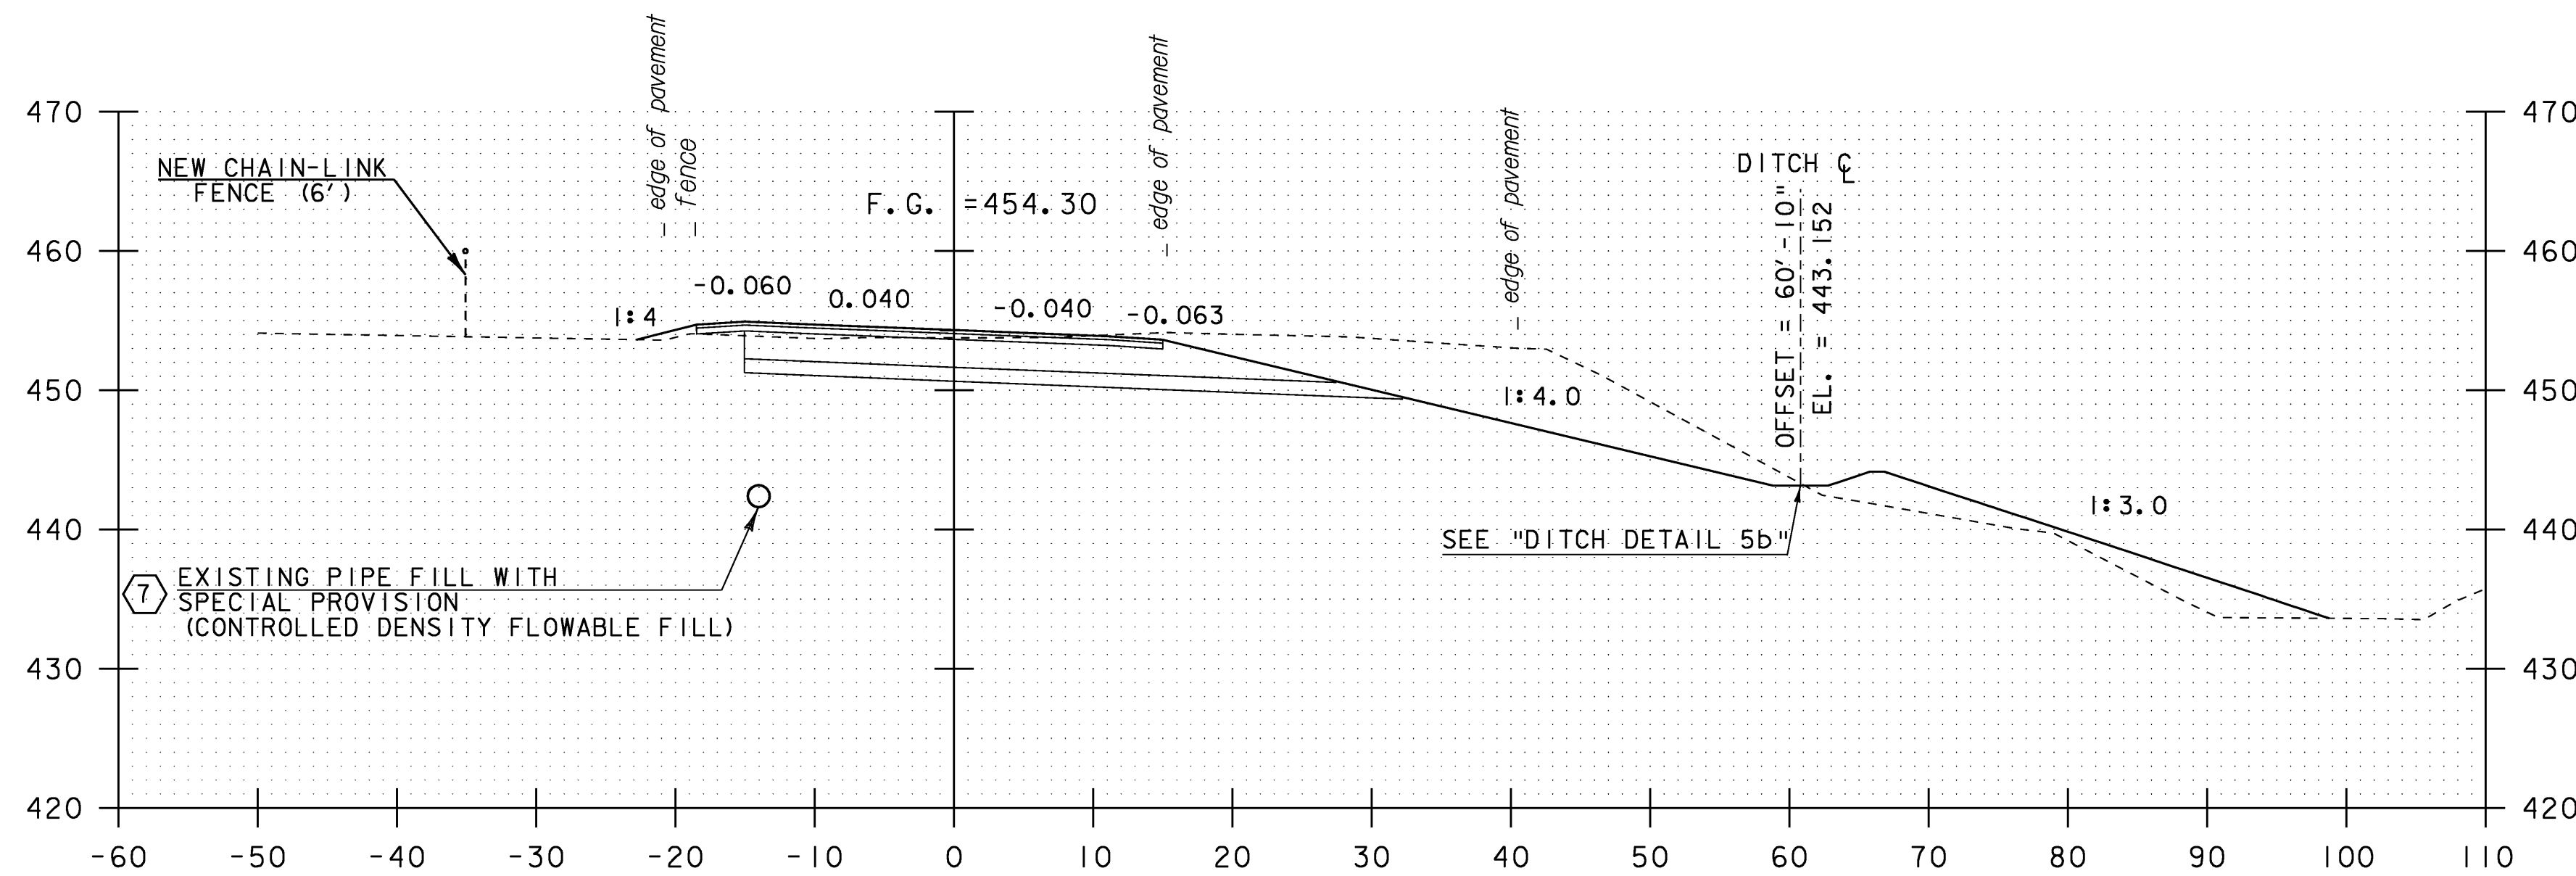


273+50

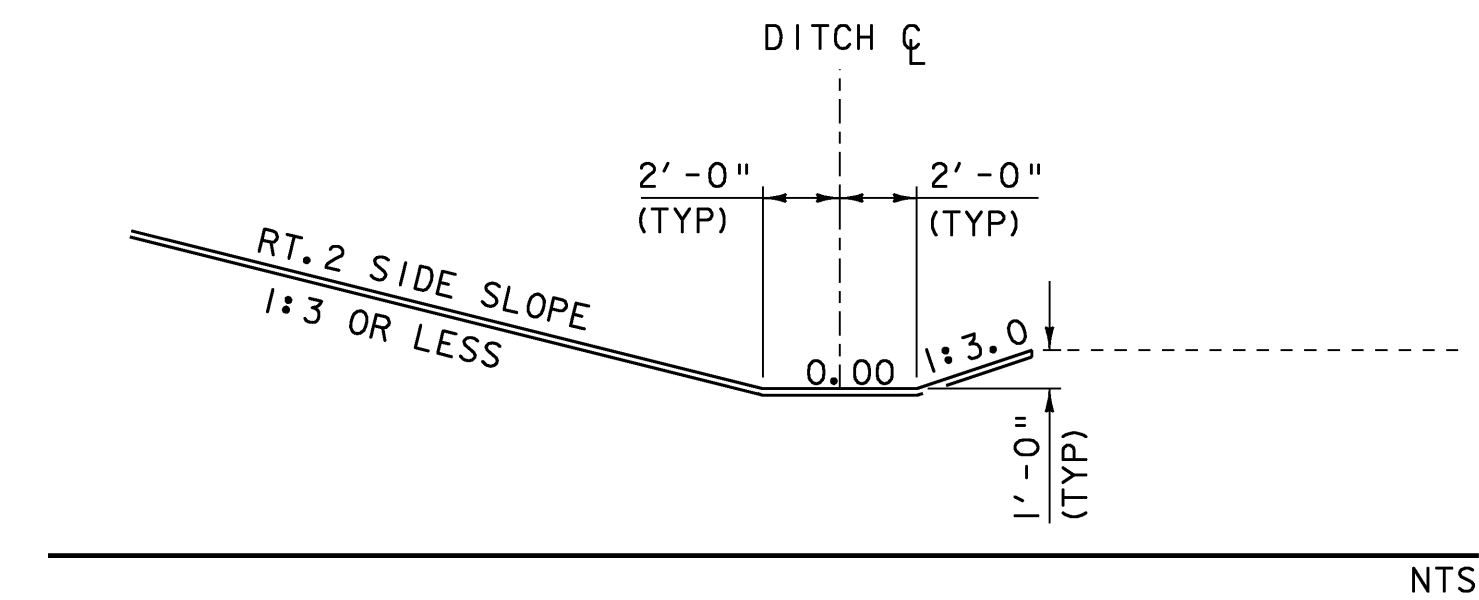

DITCH DETAIL 5c
STA. 273+92.00 RT TO 275+00.00 RT

NOTE: DITCH OFFSET IS MEASURED FROM THE ROADWAY CENTERLINE TO CENTER OF DITCH

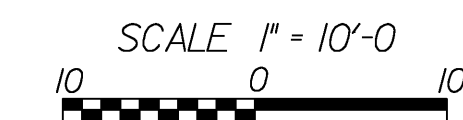

ROADWAY CROSS SECTION SHEET #8

PROJECT NAME: MORETOWN-MIDDLESEX	PLOT DATE: 15-JUN-2009
PROJECT NUMBER: BRS 0284(14)	DRAWN BY: L. DUQUETTE
FILE NAME: 78f219/str/s78f219xs3.dgn	CHECKED BY: S. SCRIBNER
PROJECT LEADER: M. Evans-Mongeon	SHEET 89 OF 103
DESIGNED BY: S. SCRIBNER	
IPARM: s7f219xsl1	

STA. 273+50 TO STA. 274+00