


274+50

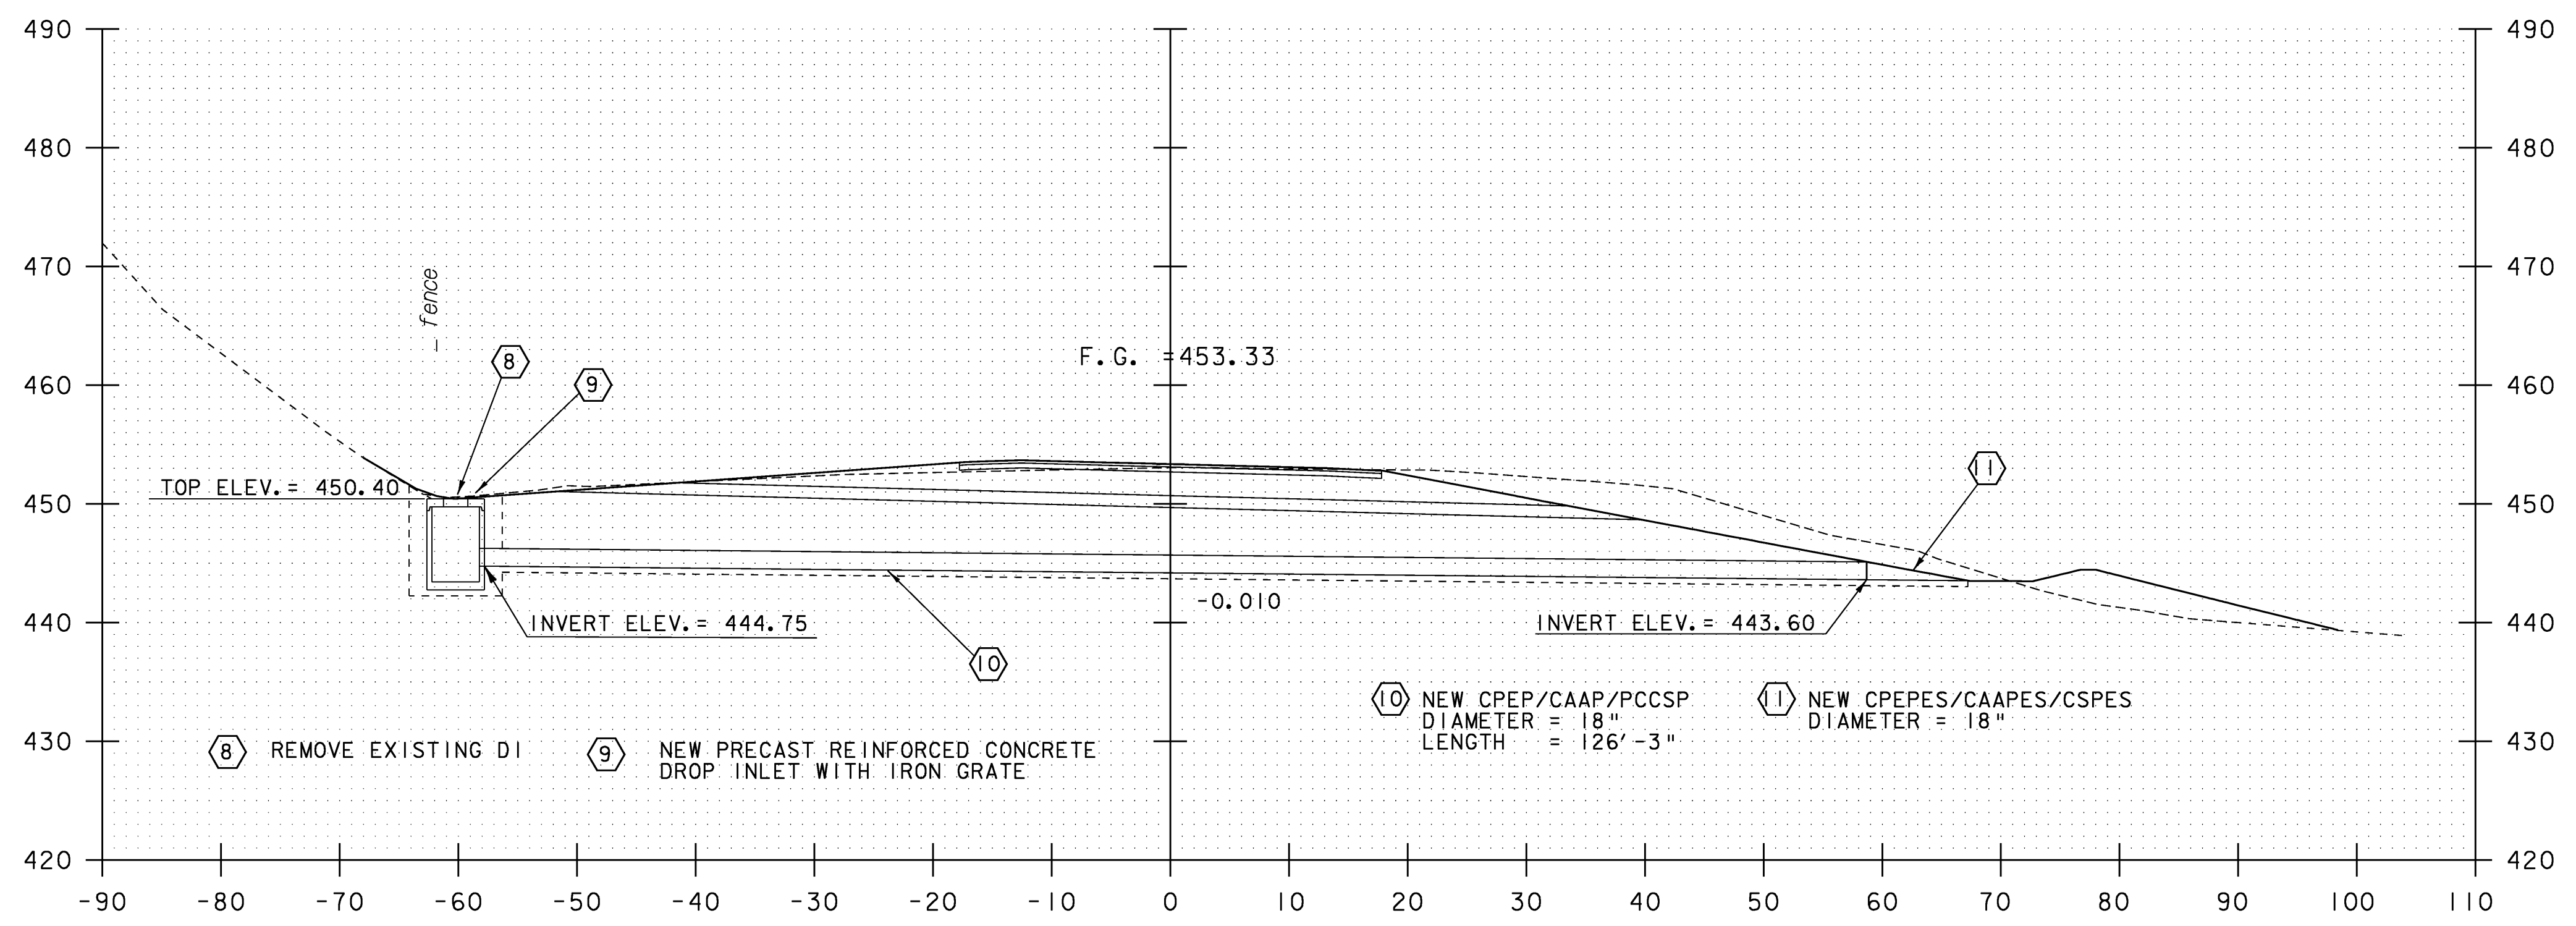

274+27
 SKEWED SECTION FOR DI AT STA. 274+55

NOTE: DITCH OFFSET IS MEASURED FROM THE ROADWAY CENTERLINE TO CENTER OF DITCH

ROADWAY CROSS SECTION SHEET #9

PROJECT NAME: MORETOWN-MIDDLESEX	PLOT DATE: 15-JUN-2009
PROJECT NUMBER: BRS 0284(14)	DRAWN BY: L. DUQUETTE
FILE NAME: 78f219/str/s78f219xs3.dgn	CHECKED BY: S. SCRIBNER
PROJECT LEADER: M. Evans-Mongeon	SHEET 90 OF 103
DESIGNED BY: S. SCRIBNER	
IPARM: s7f219xsl.I	

