




NOTE: DITCH OFFSET IS MEASURED FROM THE ROADWAY CENTERLINE TO CENTER OF DITCH

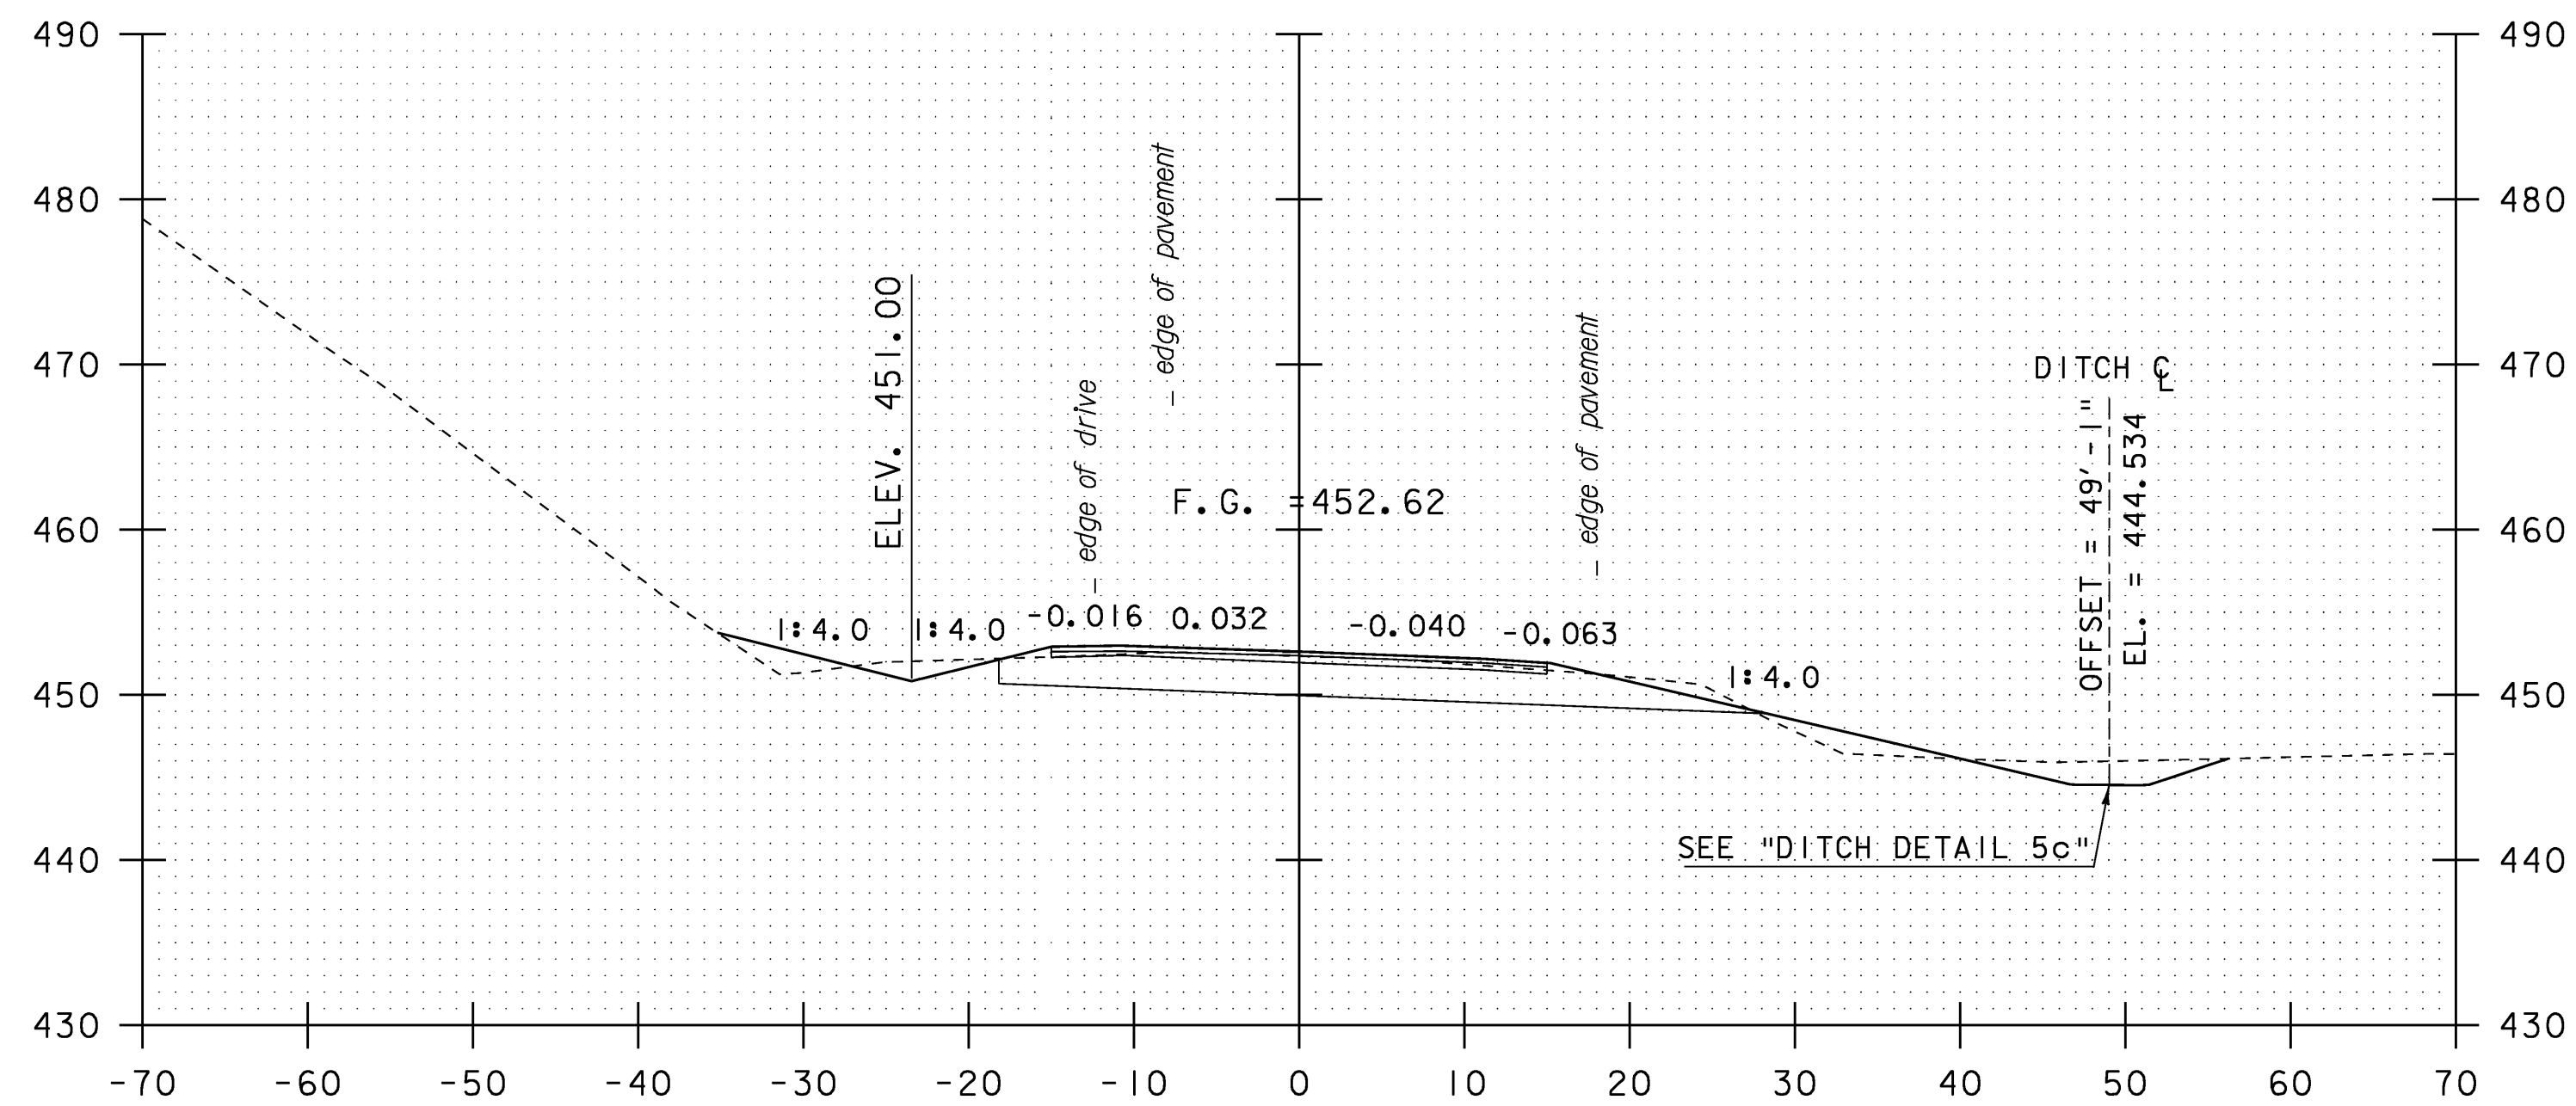


275+00
END PROJECT/BEGIN APPROACH 274+75

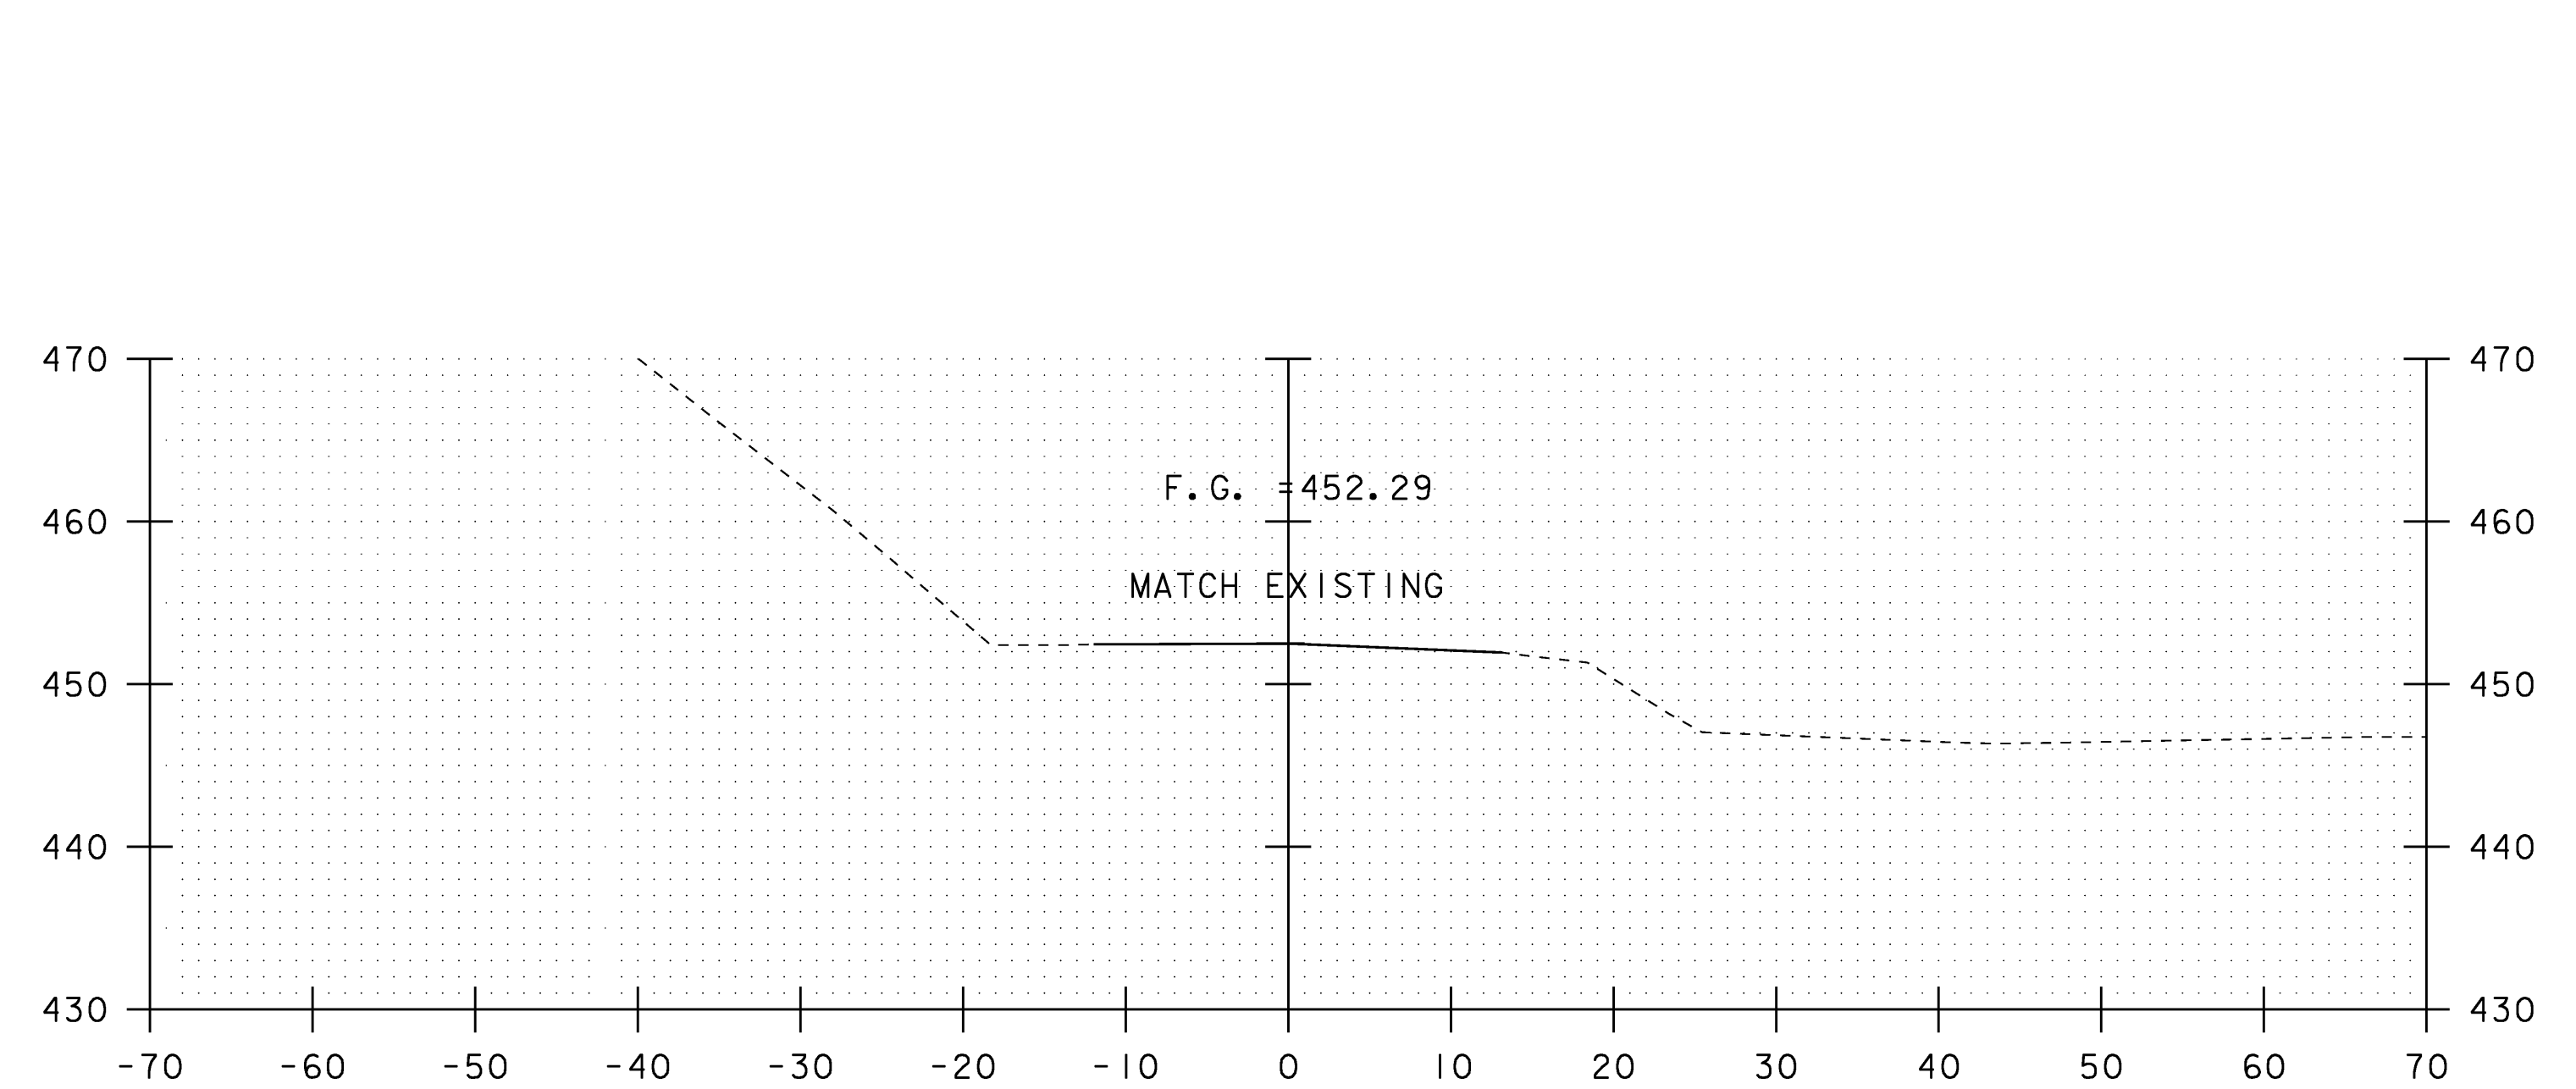


276+00
END APPROACH

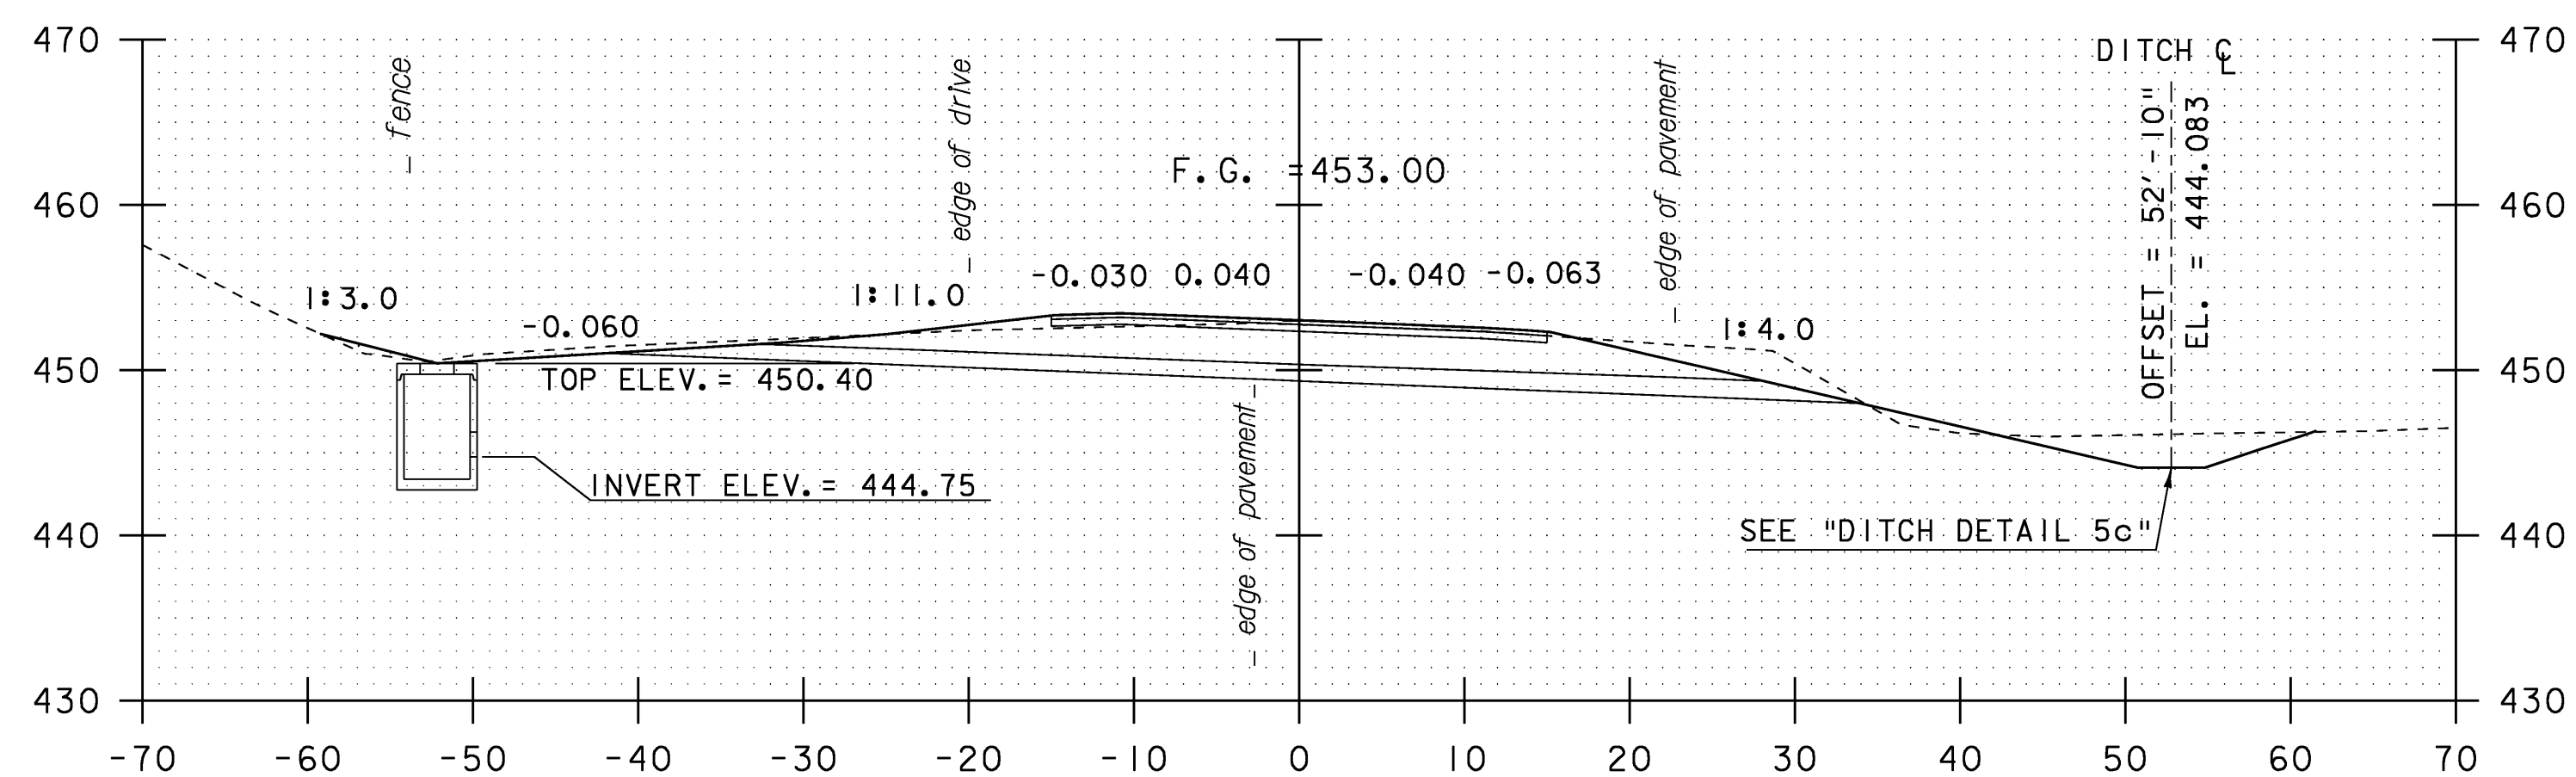


274+55

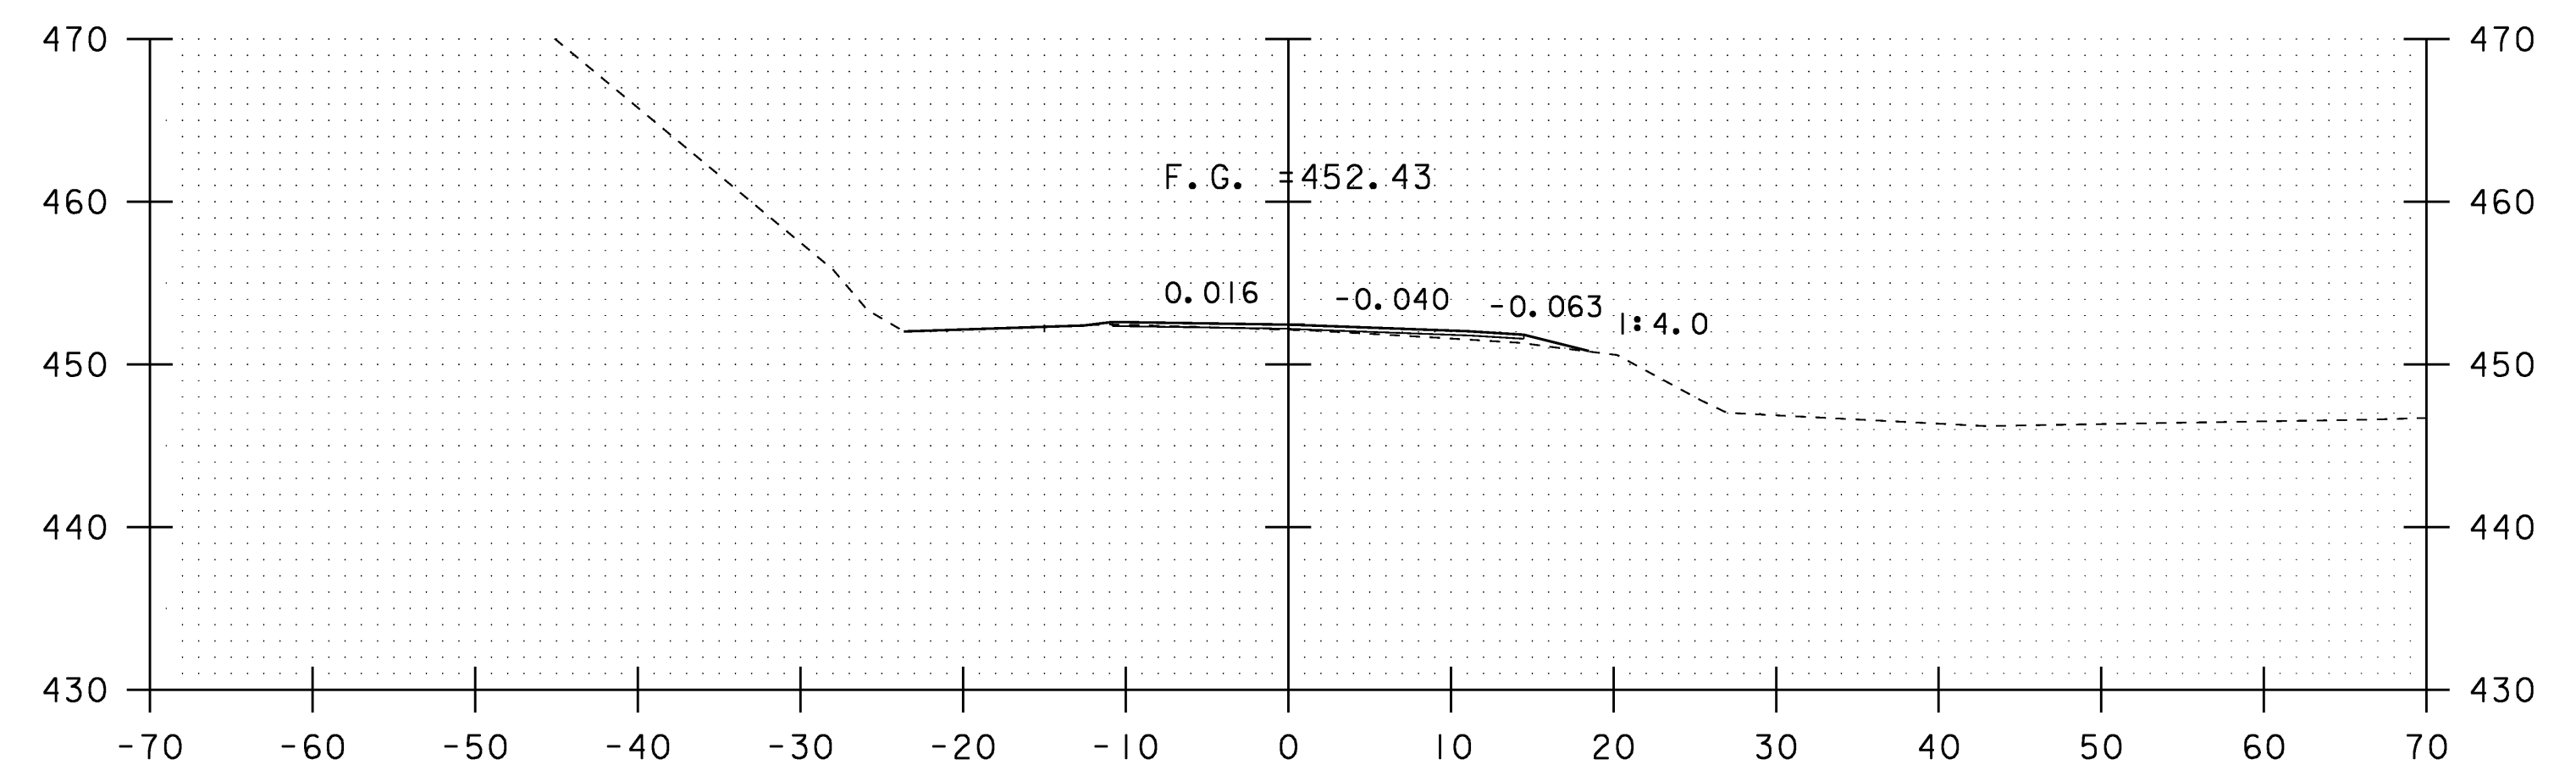


275+50

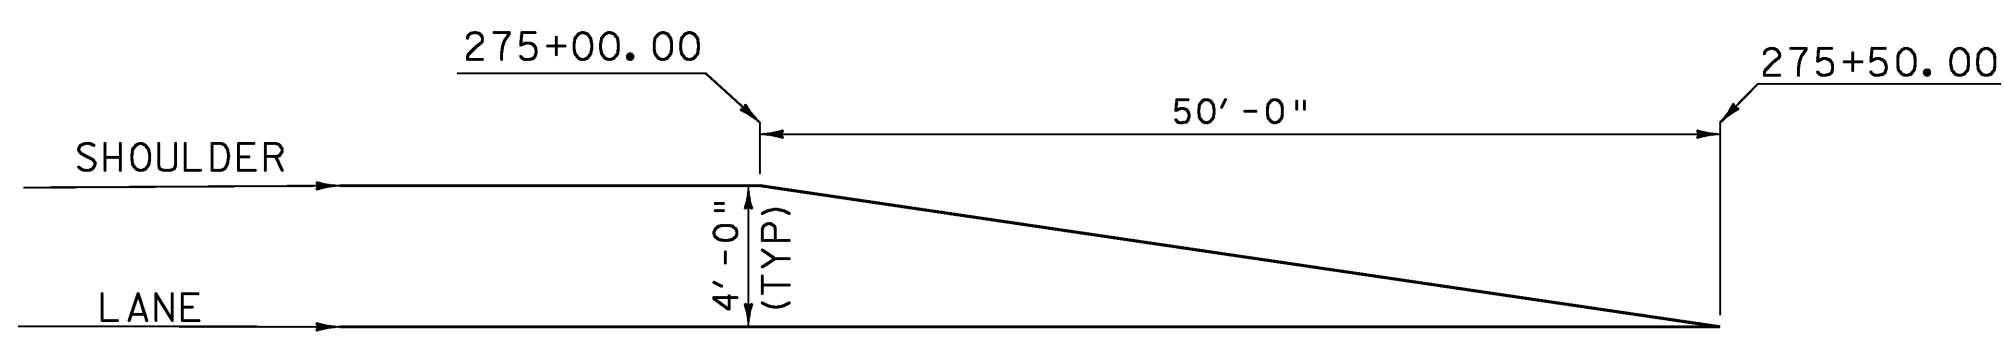

SHOULDER TRANSITION DETAIL 275+00.00 LT
NTS

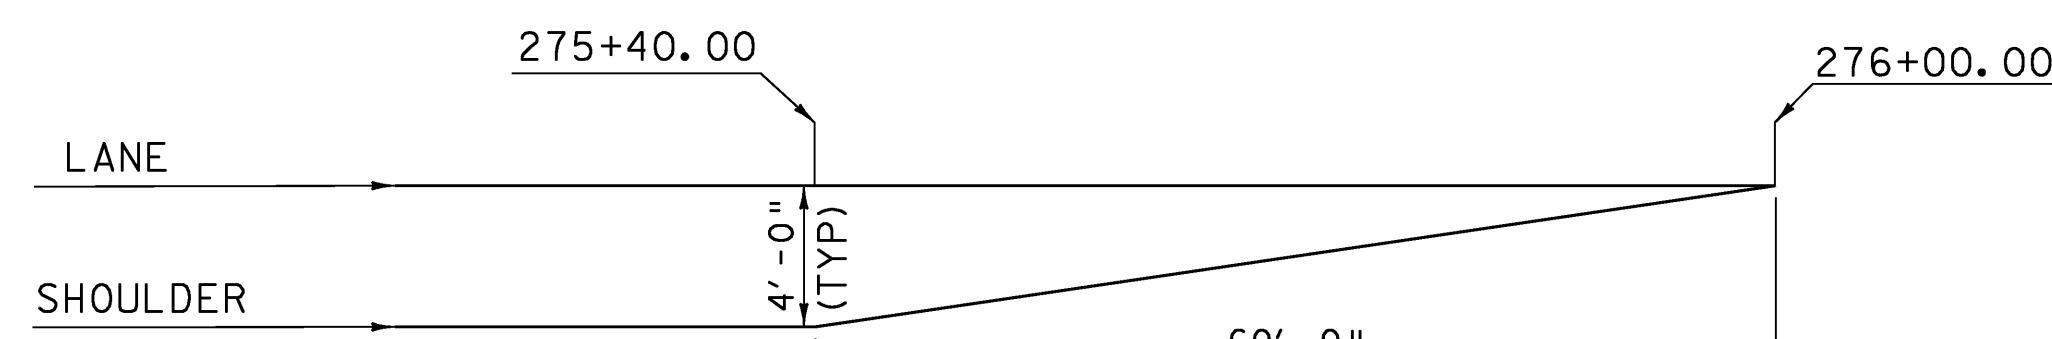

SHOULDER TRANSITION DETAIL 275+40.00 RT
NTS

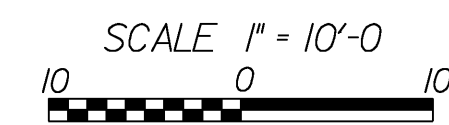

ROADWAY CROSS SECTION SHEET #10

PROJECT NAME: MORETOWN-MIDDLESEX

PROJECT NUMBER: BRS 0284(14)

FILE NAME: 78f219/str/s78f219xs3.dgn

PROJECT LEADER: M. Evans-Mongeon

DESIGNED BY: S. SCRIBNER

IPARM: s7f219xsl

PLOT DATE: 15-JUN-2009

DRAWN BY: L. DUQUETTE

CHECKED BY: S. SCRIBNER

SHEET 91 OF 103