



53+25

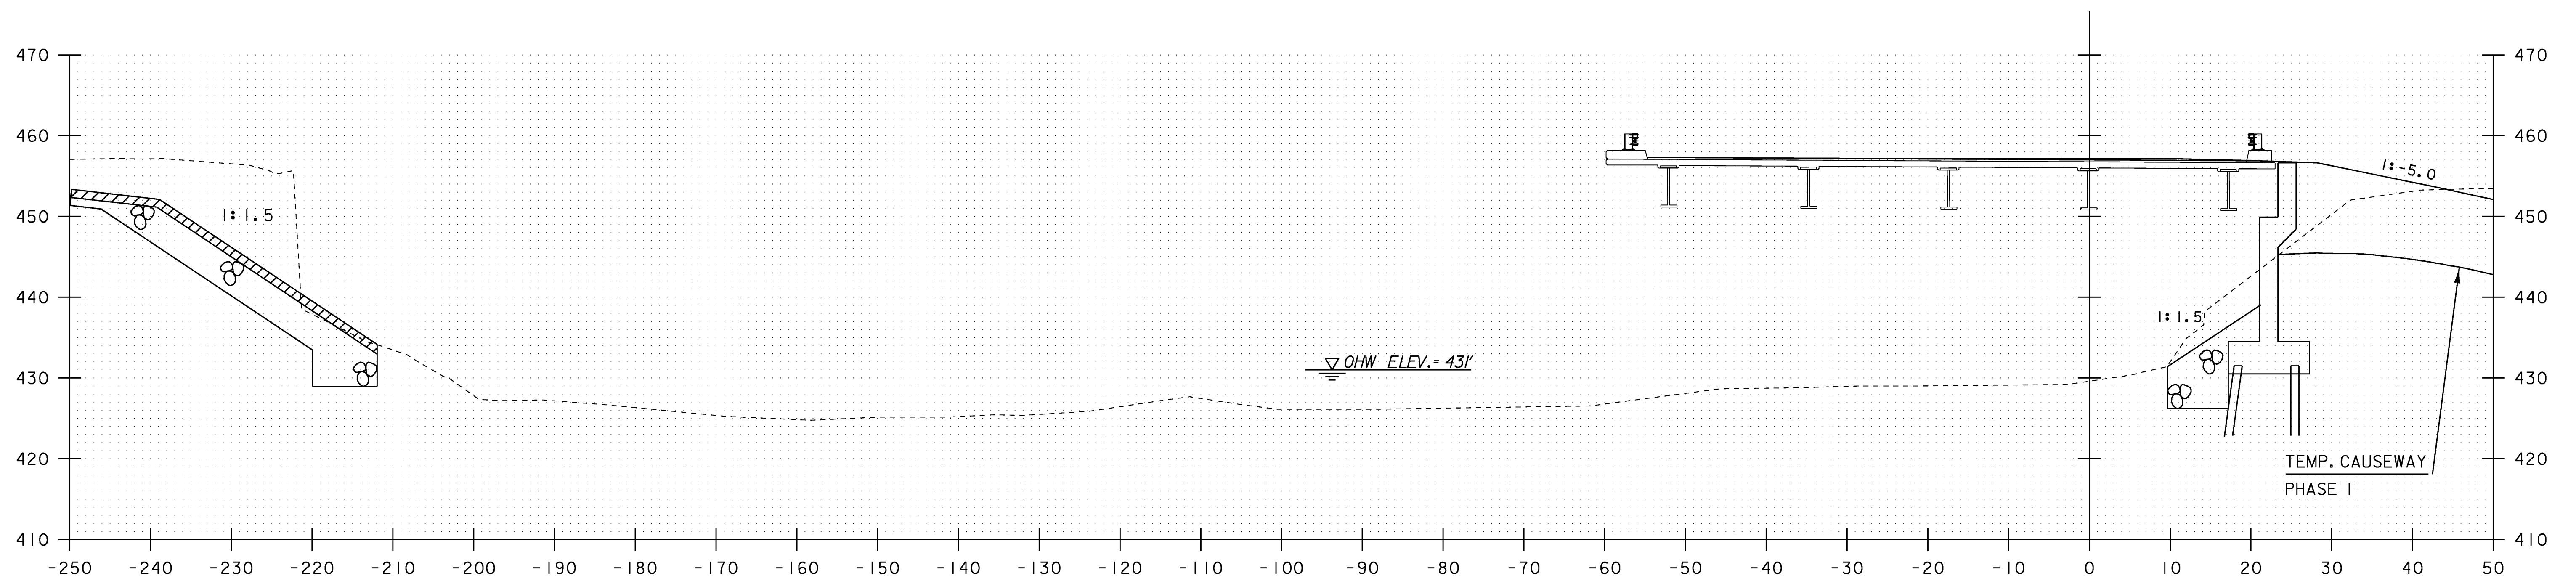

53+00

CHANNEL CROSS SECTION SHEET #4

PROJECT NAME:	MORETOWN-MIDDLESEX	PLOT DATE:	15-JUN-2009
PROJECT NUMBER:	BRS 0284(14)	DRAWN BY:	L. DUQUETTE
FILE NAME:	78f219/str/s78f219xs3.dgn	CHECKED BY:	S. SCRIBNER
PROJECT LEADER:	M. Evans-Mongeon	SHEET	95 OF 103
DESIGNED BY:	S. SCRIBNER		
IPARM:	s78f219chl.l		

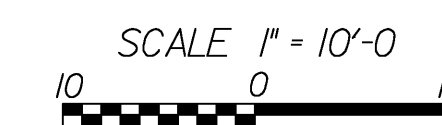

STA. 53+00 TO STA. 53+25