



53+75

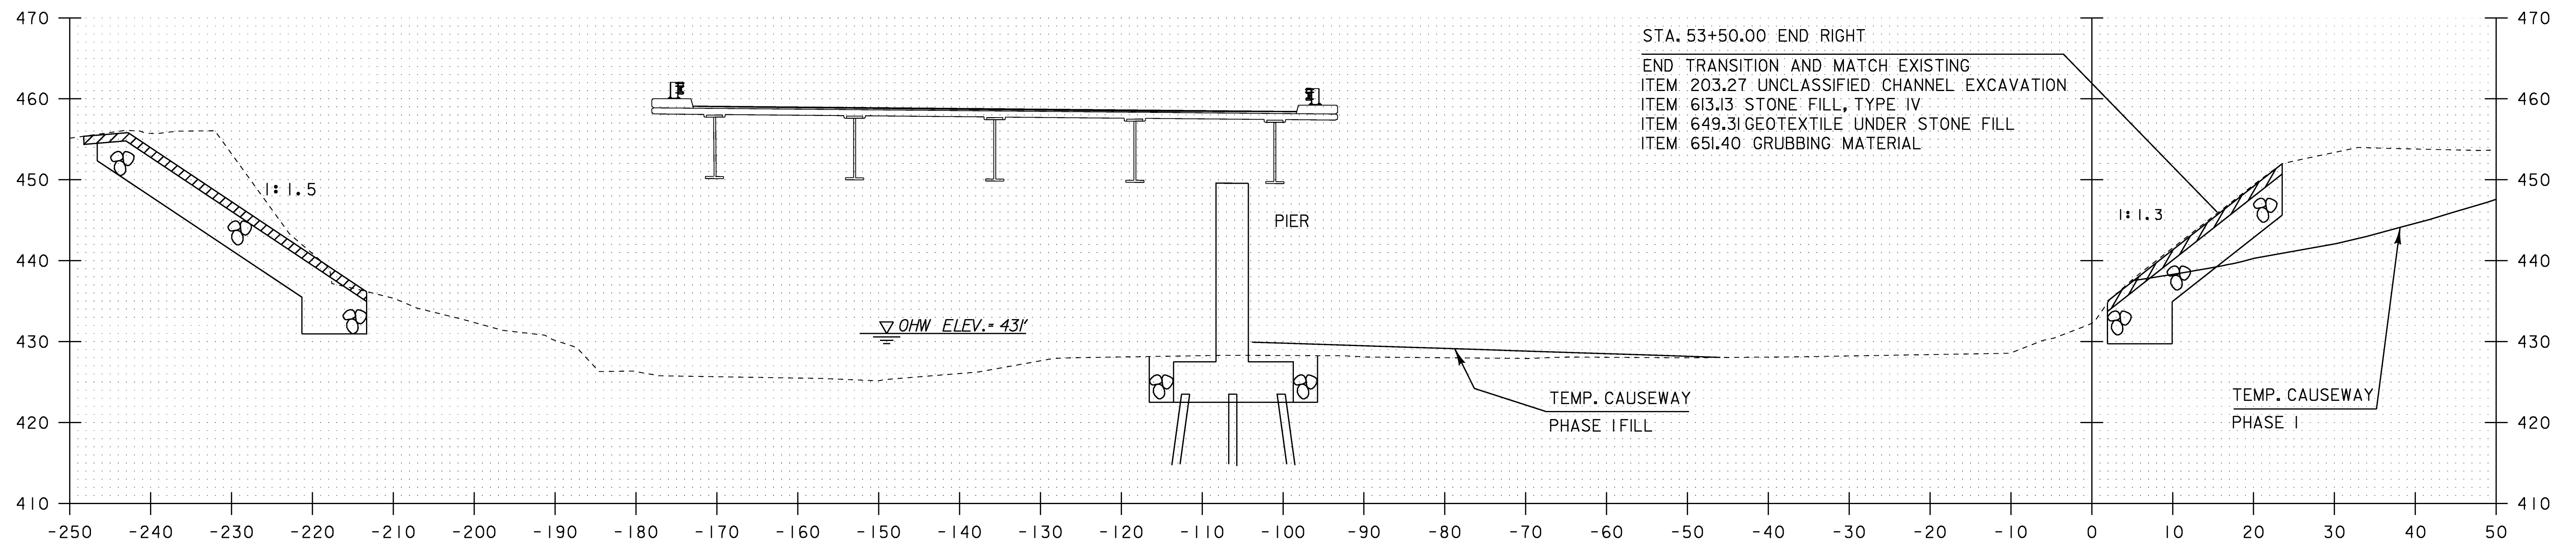

53+50

**CHANNEL CROSS SECTION SHEET #5**

PROJECT NAME: MORETOWN-MIDDLESEX	PLOT DATE: 15-JUN-2009
PROJECT NUMBER: BRS 0284(14)	DRAWN BY: L. DUQUETTE
FILE NAME: 78f219/str/s78f219xs3.dgn	CHECKED BY: S. SCRIBNER
PROJECT LEADER: M. Evans-Mongeon	SHEET 96 OF 103
DESIGNED BY: S. SCRIBNER	
IPARM: s78f219chl.l	

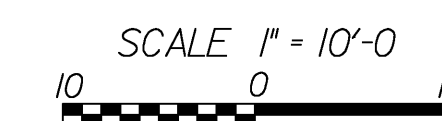

STA. 53+50 TO STA. 53+75