




105+00

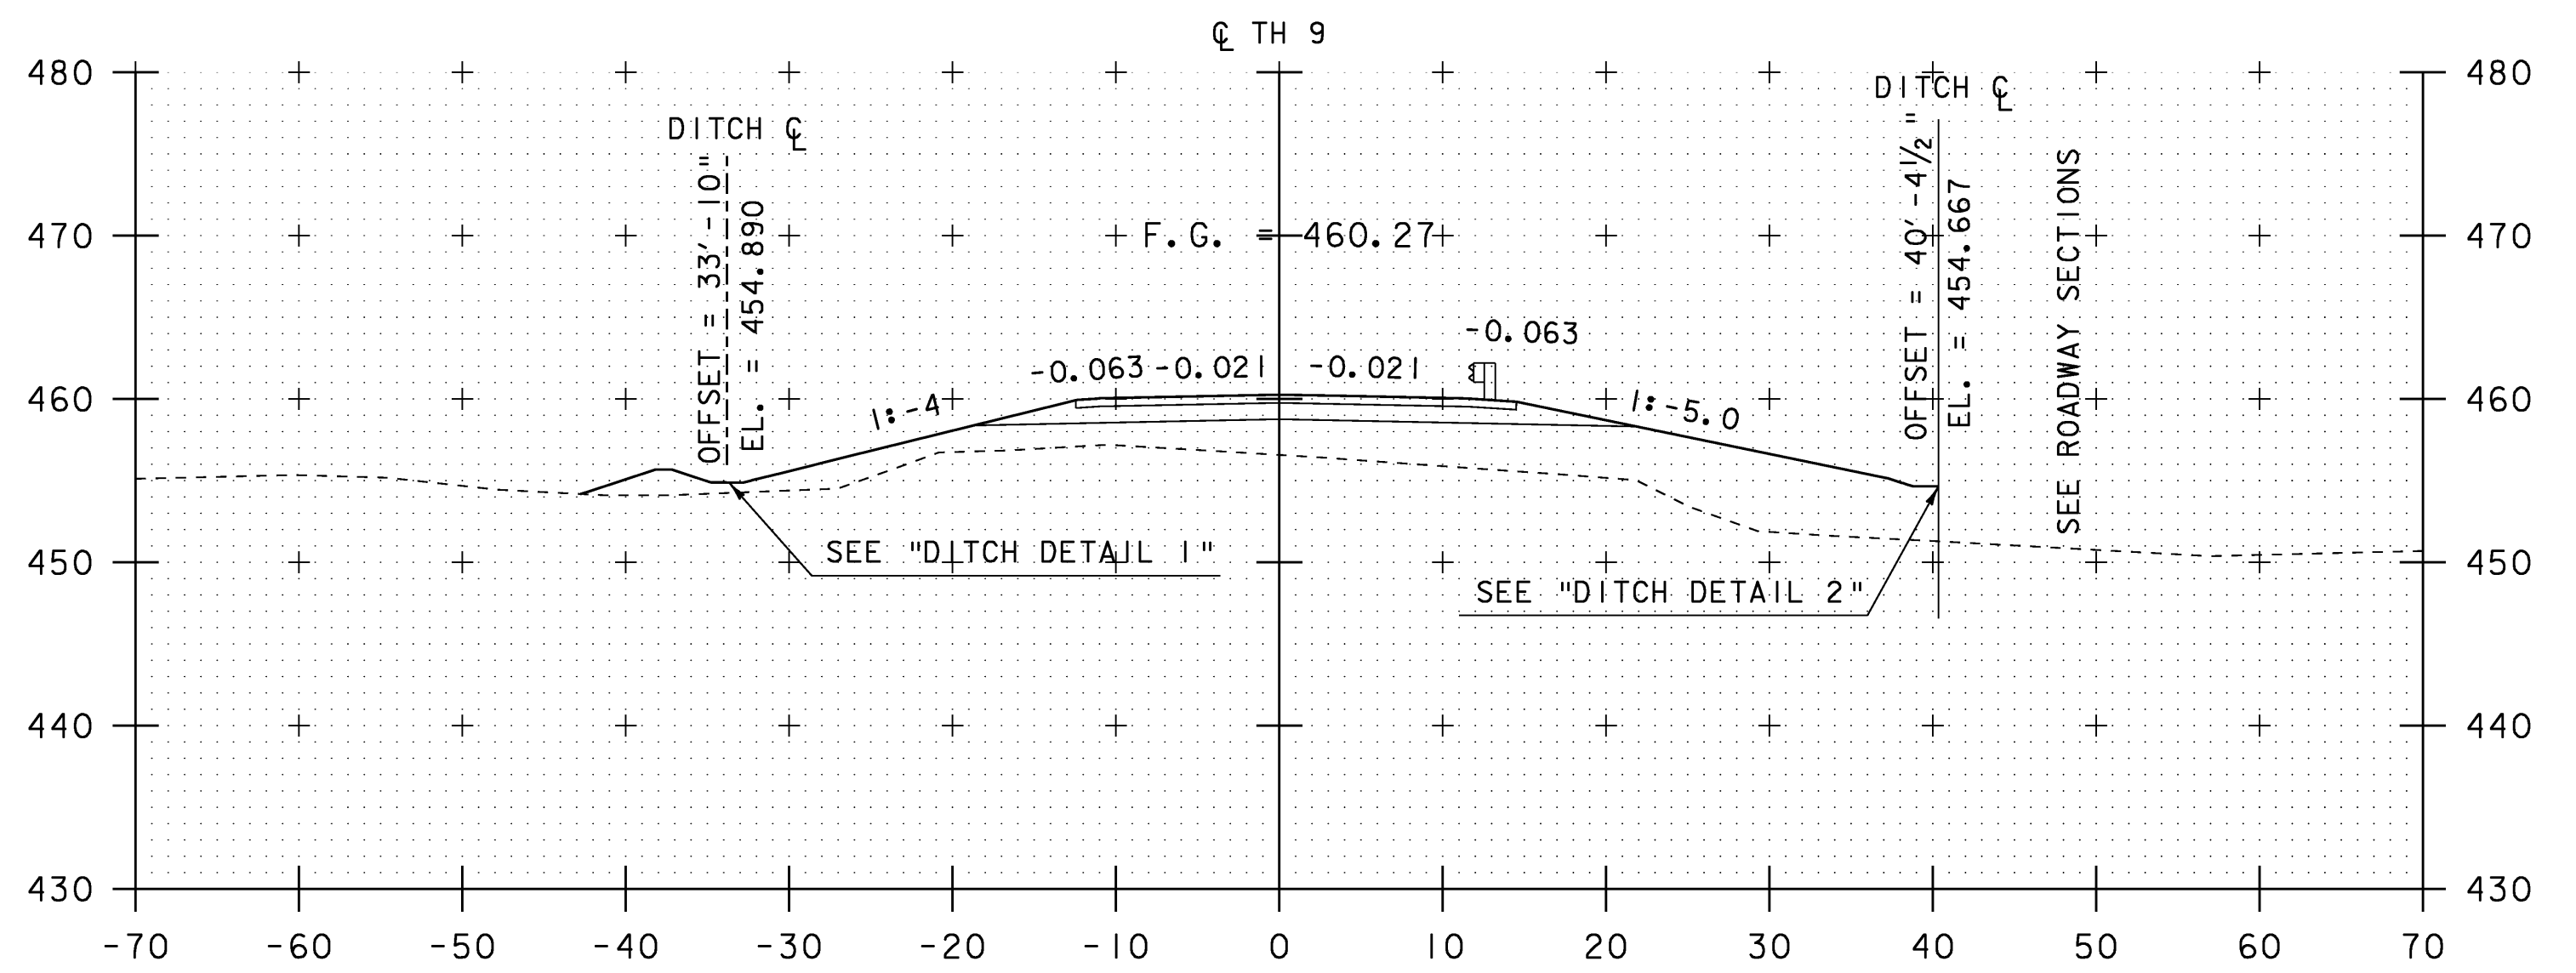

105+50

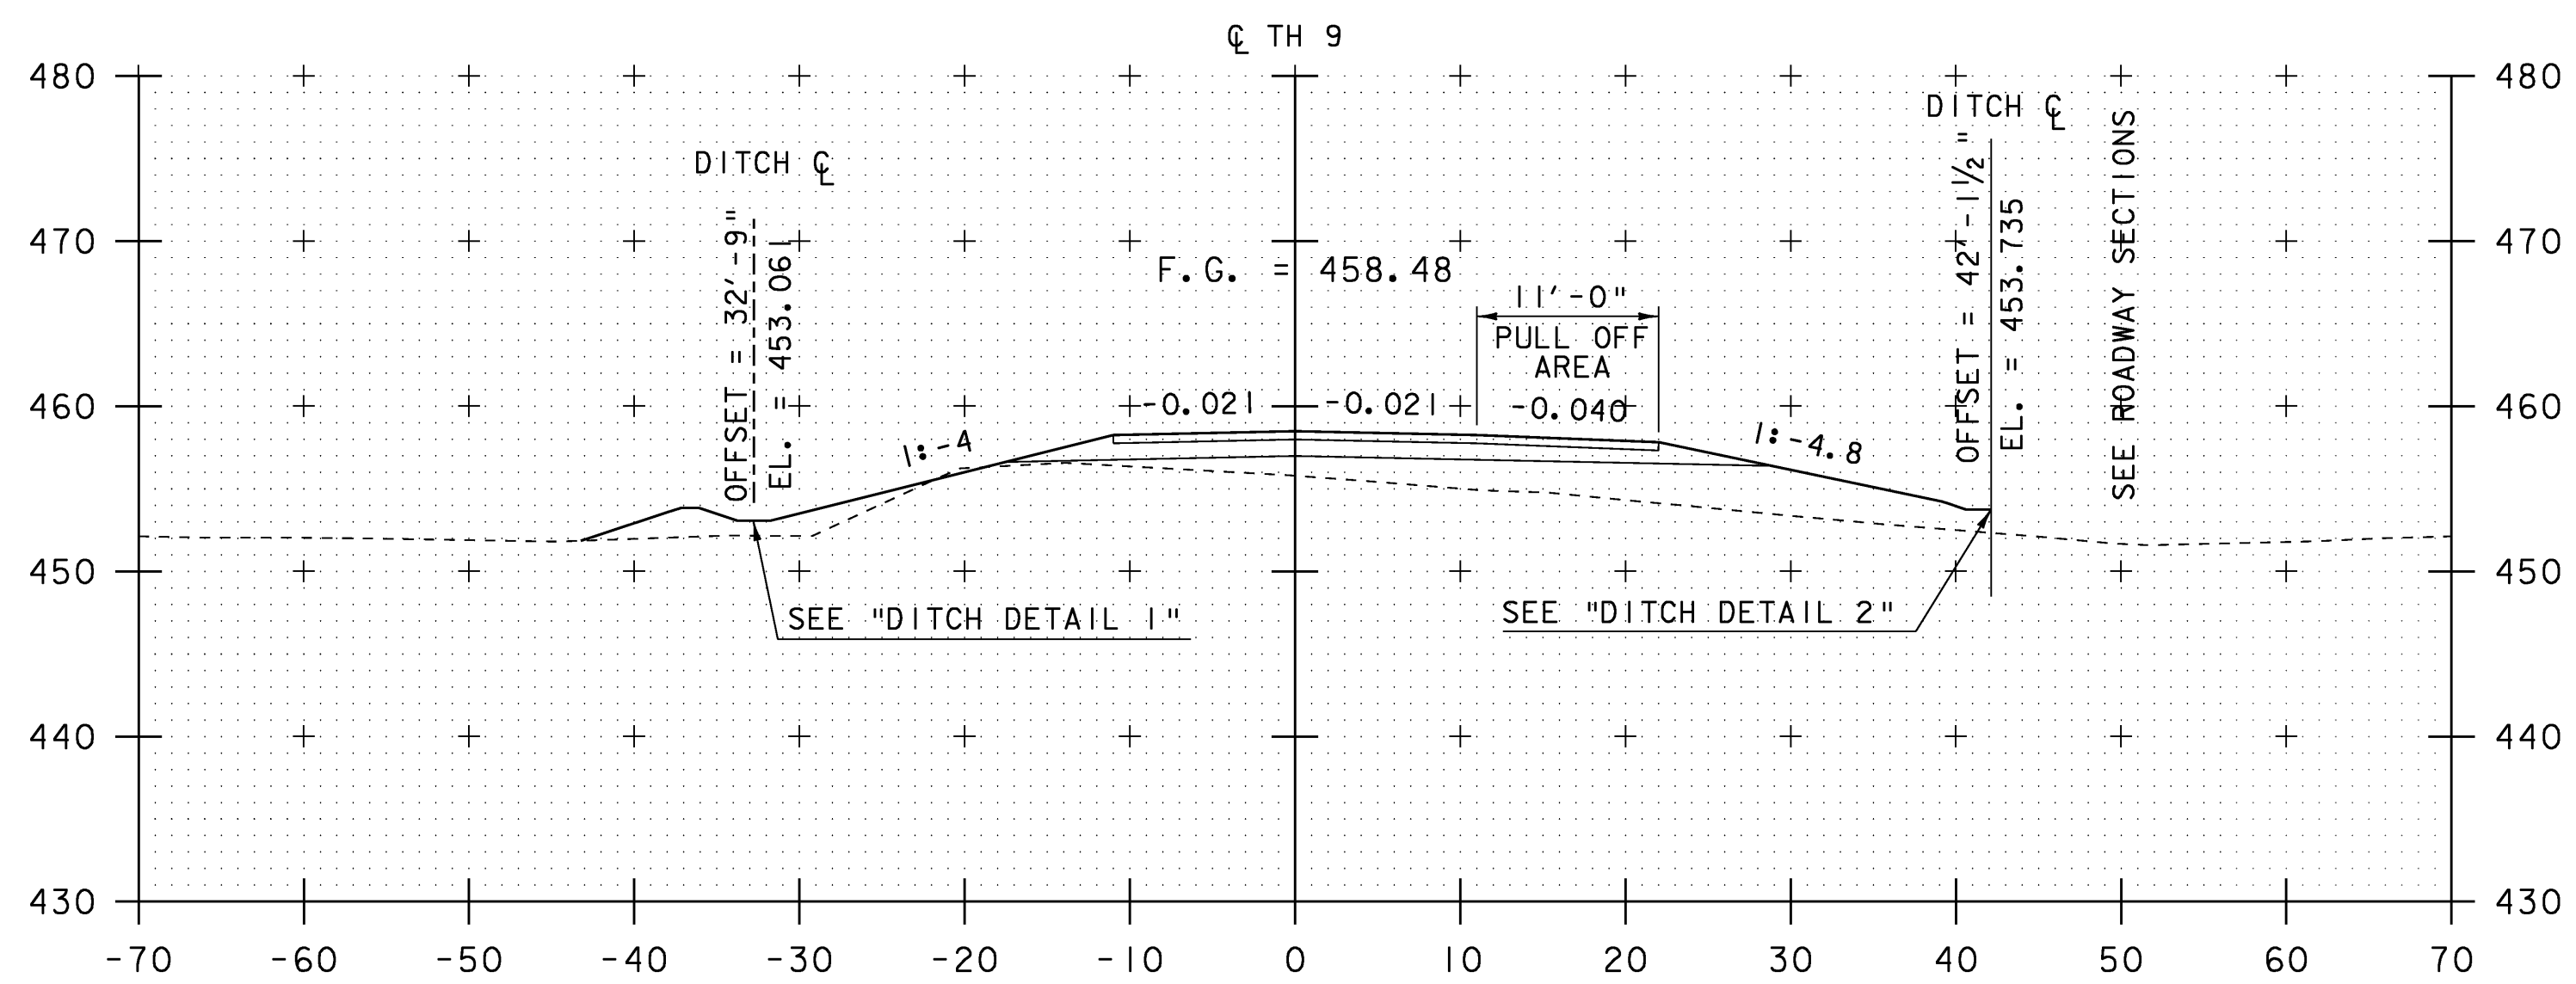


104+75

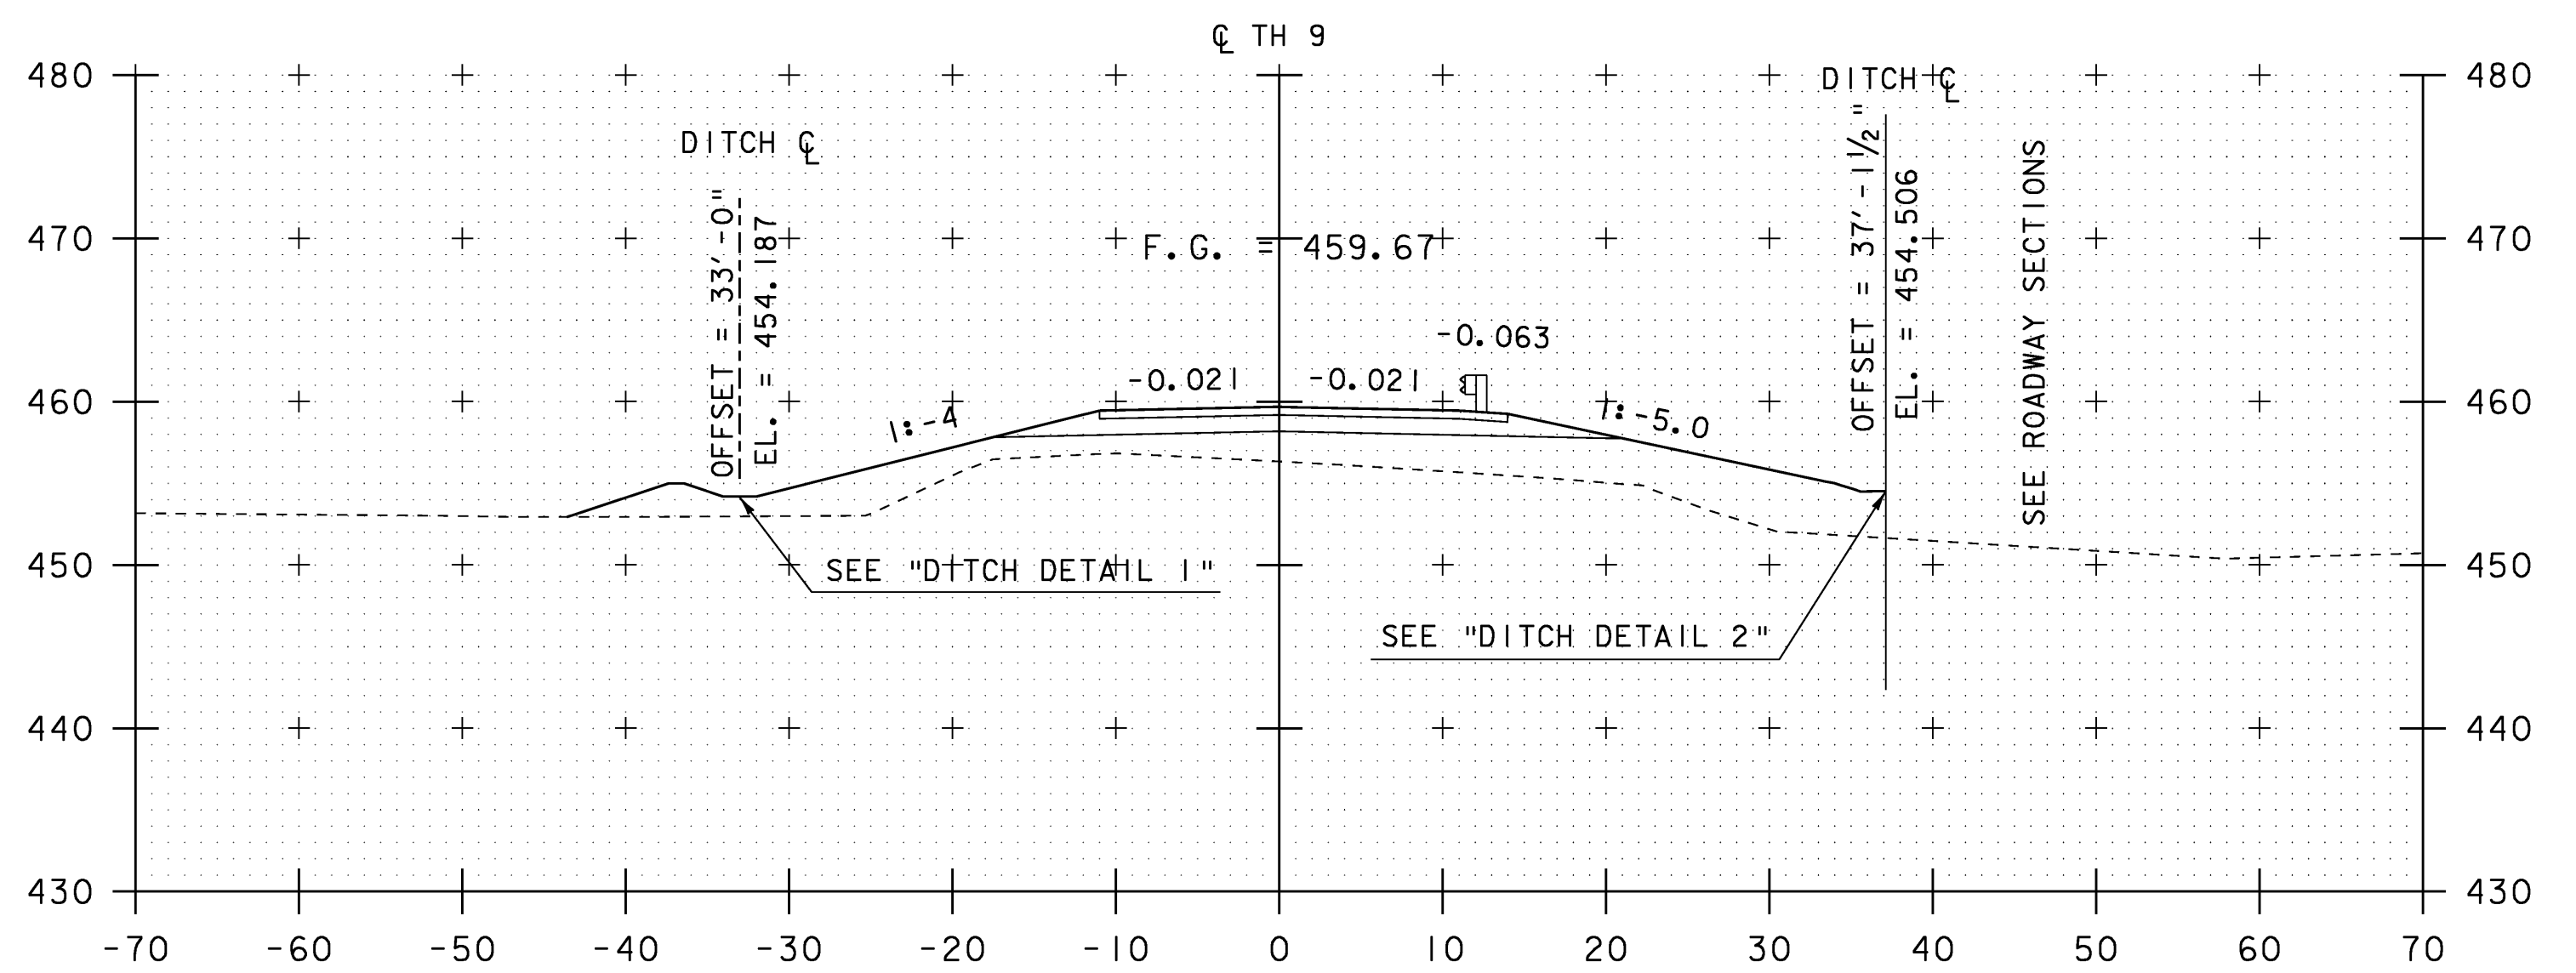

105+25

NOTE: DITCH OFFSET IS MEASURED FROM THE CENTERLINE OF TH 9 TO CENTER OF DITCH

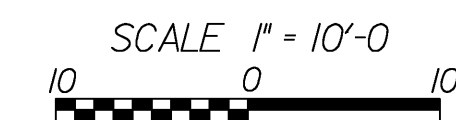

TH 9 CROSS SECTION SHEET #3

PROJECT NAME: MORETOWN-MIDDLESEX	PLOT DATE: 15-JUN-2009
PROJECT NUMBER: BRS 0284(14)	DRAWN BY: G. ROKES
FILE NAME: 78f219/str/s78f219xs3.dgn	CHECKED BY: S. SCRIBNER
PROJECT LEADER: M. Evans-Mongeon	SHEET 101 OF 103
DESIGNED BY: G. ROKES	
IPARM: s78f219lxs1	

STA. 104+75 TO STA. 105+50