




67+25

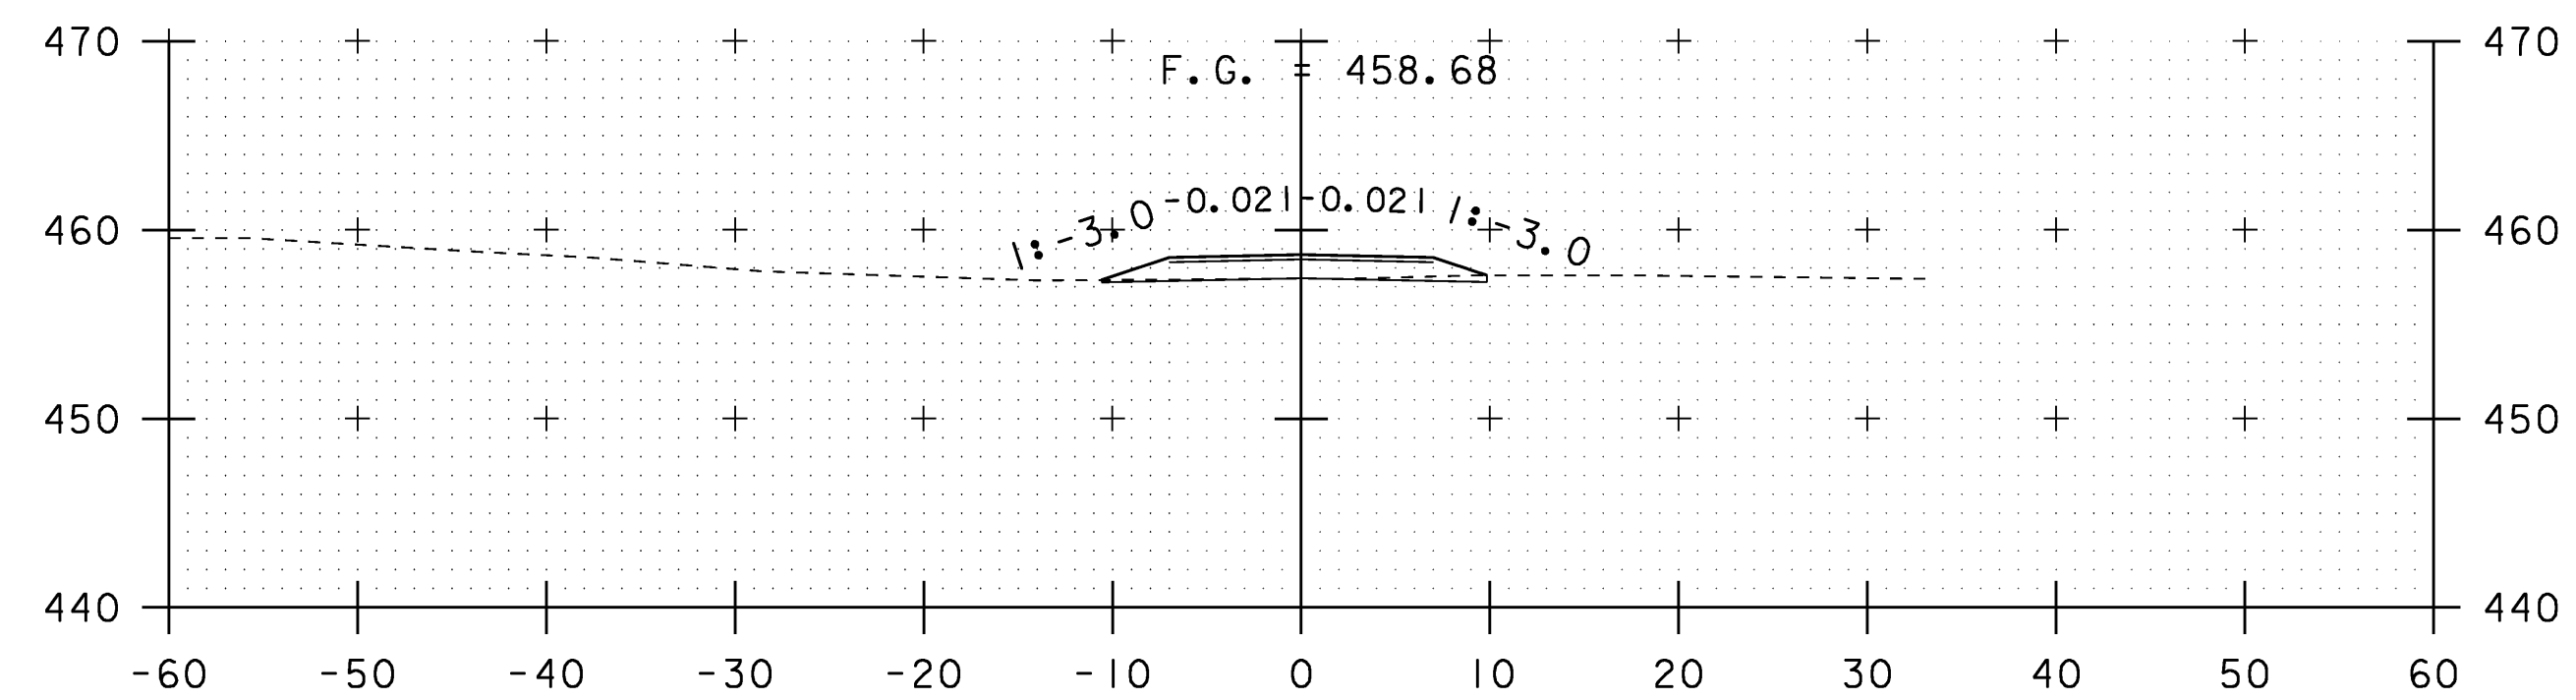


67+75

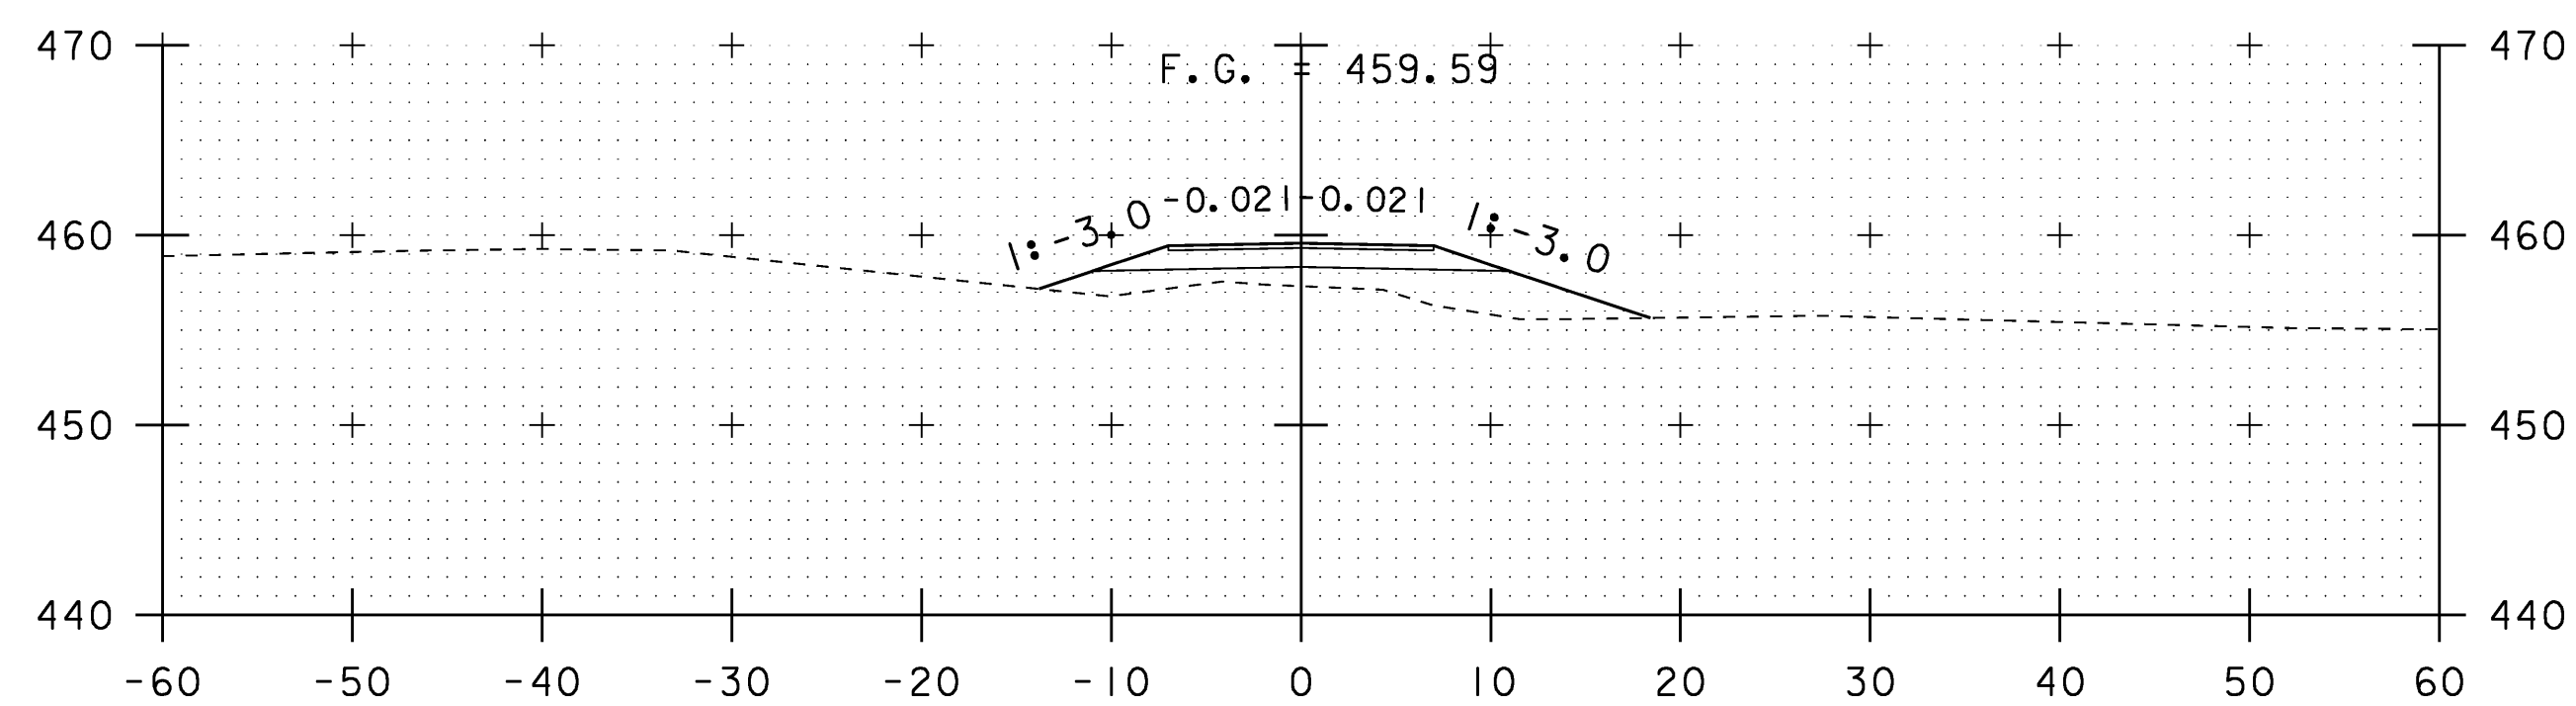

67+00

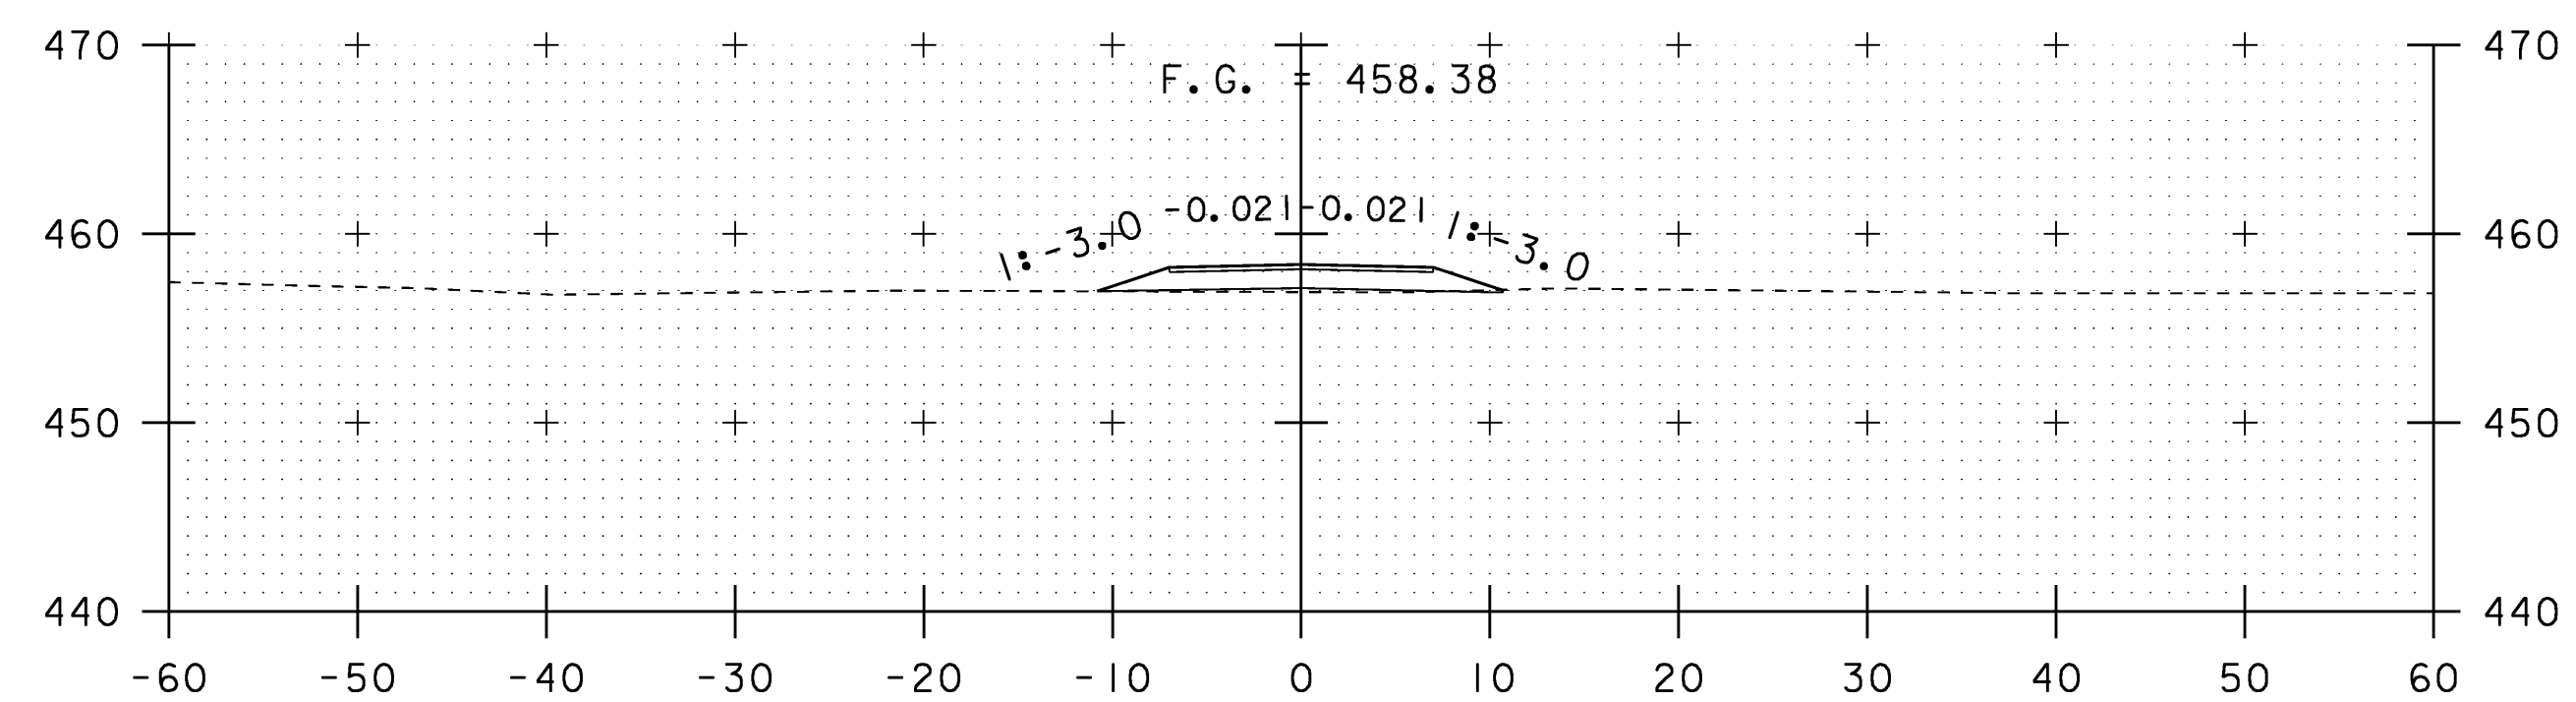

67+50

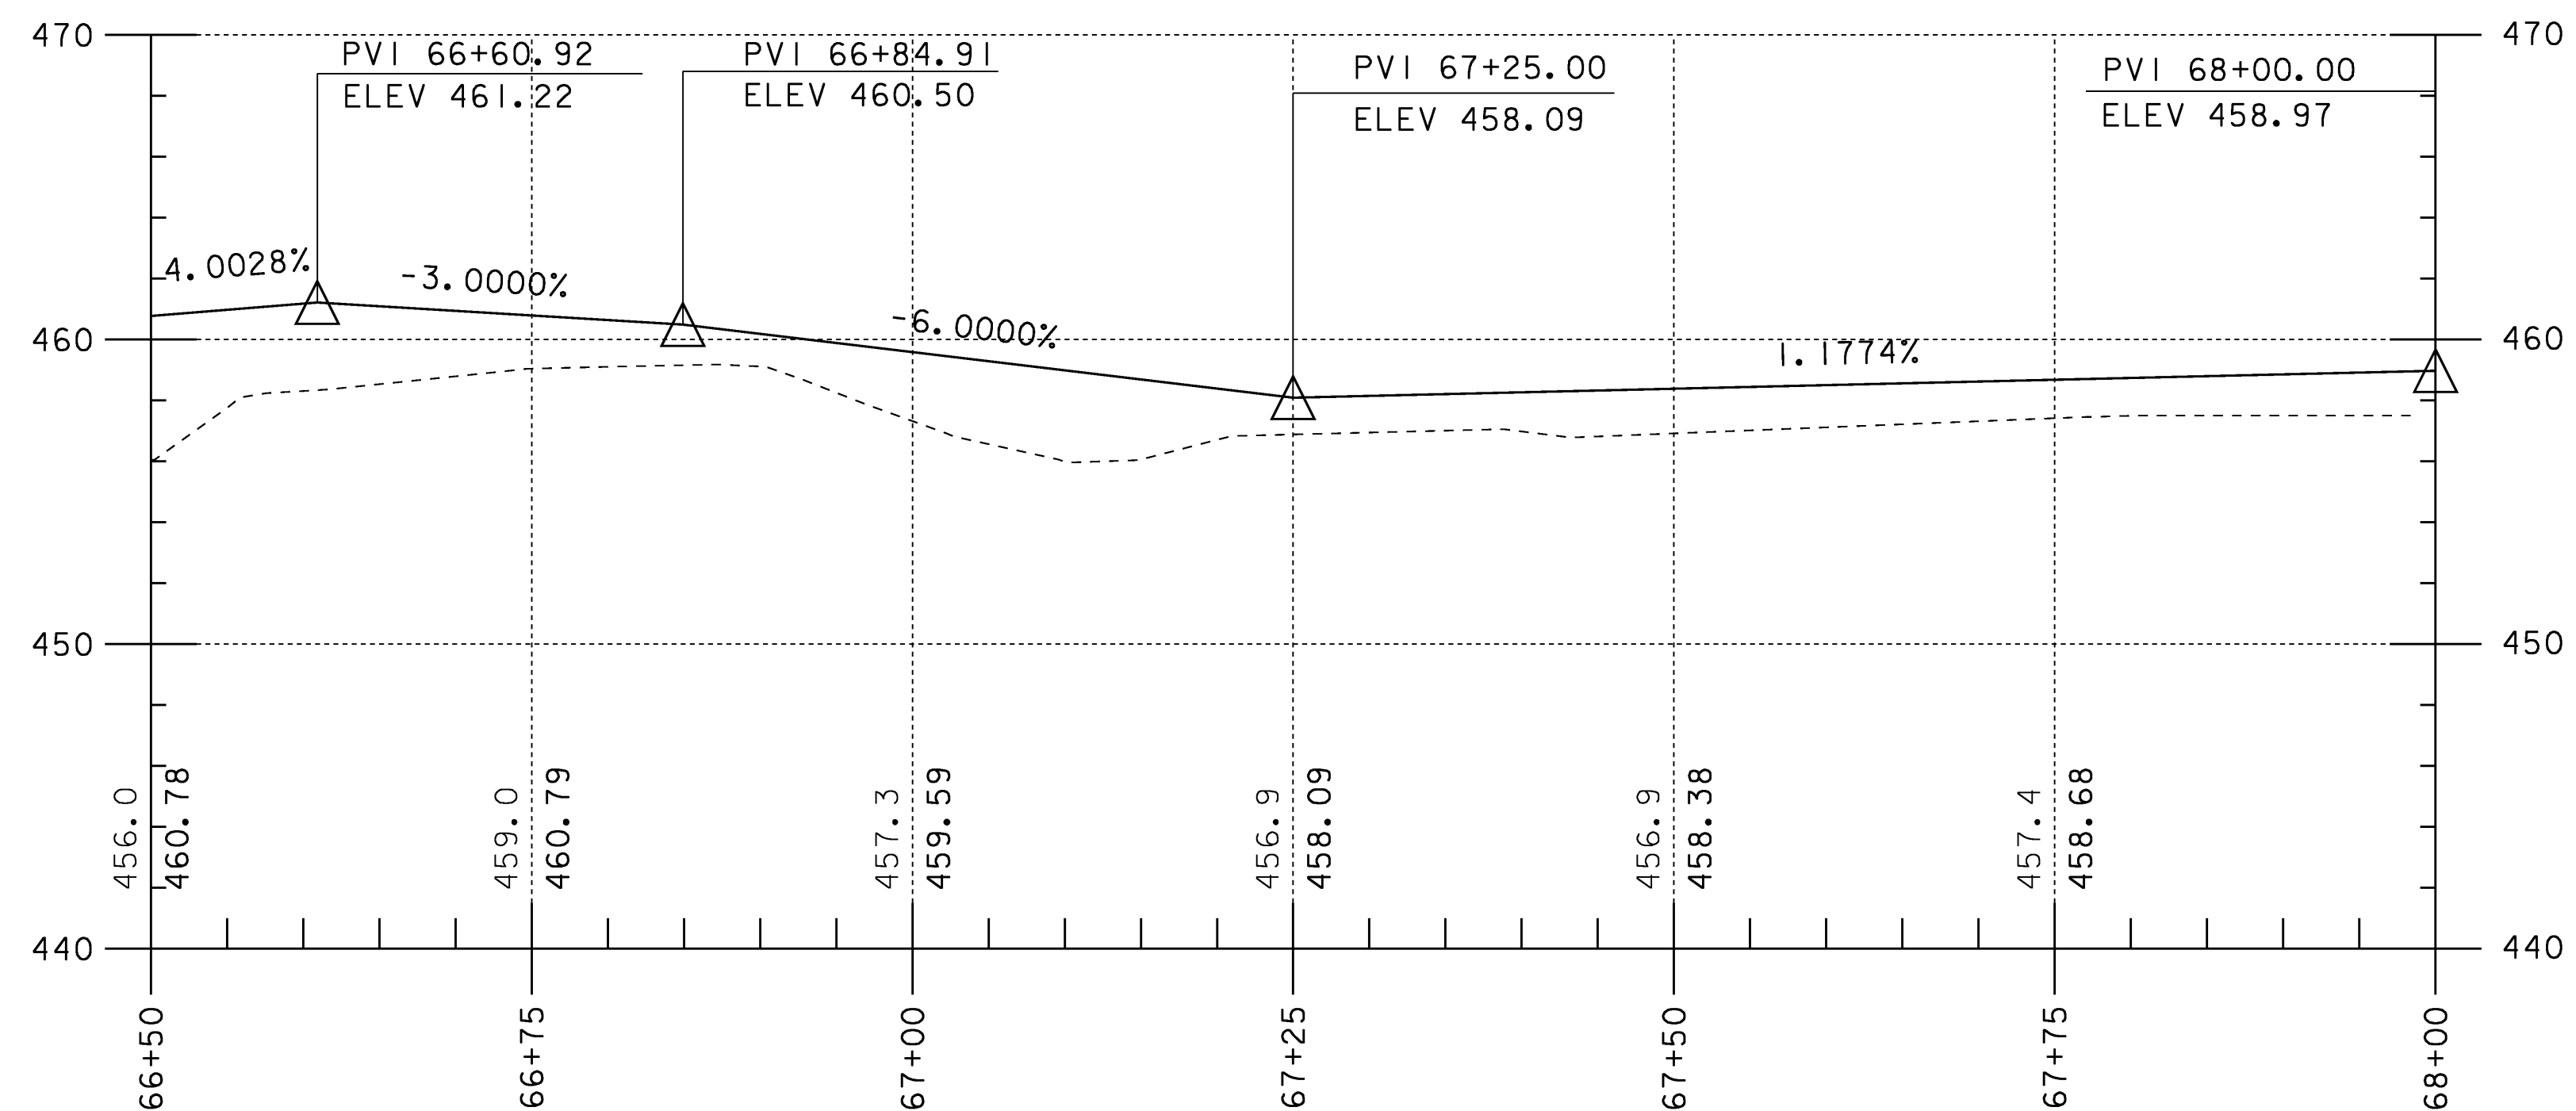

DRIVE 265+34 PROFILE

DRIVE SECTIONS 265+34.00 RT

PROJECT NAME: MORETOWN-MIDDLESEX	PLOT DATE: 15-JUN-2009
PROJECT NUMBER: BRS 0284(14)	DRAWN BY: L. DUQUETTE
FILE NAME: 78f219/str/s78f219xs3.dgn	CHECKED BY: M. EVANS-MONGEON
PROJECT LEADER: M. Evans-Mongeon	SHEET 103 OF 103
DESIGNED BY: G. ROKES	

