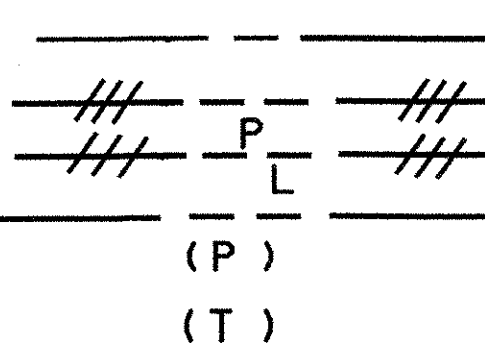

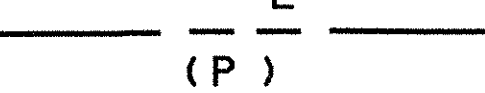


**STATE OF VERMONT
AGENCY OF TRANSPORTATION
RIGHT OF WAY PLANS
DETAIL SHEET**

TABLE OF PROJECT PROPERTY ACQUISITION

PARCEL NO.	GRANTOR	SHEET NO.	BEGINNING STATION	ENDING STATION	TAKING	REM.	RIGHTS	TITLE TAKEN	DATE	TOWN OR CITY RECORDED	BK.	PG.	REMARKS	REVISION NO.	SHEET	DESCRIPTION OF REVISION	DATE	MADE BY	APPROVED BY
3A	HERB CRAWFORD'S AUTOLAND, INC.	13	REV. 128+12 RT. REV. 128+10 RT. REV. 128+94 LT. REV. 128+99 RT. REV. 129+00 RT. REV. 129+23 RT. REV. 129+49 RT. REV. 129+54 RT. REV. 129+64 RT. REV. 129+52 RT. REV. 129+13 RT.	REV. 129+00 RT. REV. 129+83 RT. REV. 129+11 RT. REV. 129+49 RT. REV. 129+60 RT. REV. 129+70 RT. REV. 129+75 RT. REV. 129+80 RT.	3300 SF±		CONST. EASE. (T) 1740 SF± ALL R. T. & I. CULVERT (P) REMOVE & RESET (T) DRIVE (T) DIT. & DRAINAGE (P) CULVERT (P) DITCH (P) WALK (T) EASE. (T)	WD	07-11-01	ROYALTON	47	4-5	WATER LINE SIGN 20.5' PAVED MM 0245 INSTALL WATER LINE	9	11,13	PARCEL NO. 2 CRAWFORD. DELETE CLEAR & TRIM (P) FROM PARCEL ON DETAIL & LAYOUT SHEETS; ADD DRIVE(T) TO LAYOUT AND ADJUST DETAIL SHEET TO SHOW DRIVE RT.(T); CHANGE SLOPE (T) STATION FROM 127+01 RT. TO 126+94 RT.(CHANGE AREA TO 35 SF±); CHANGE CHANNEL (P) STATION FROM 127+07 TO 127+05 AND CHANGE AREA TO 545 SF±. PER C.O. 9108	3-22-00	R. B. K.	R. P. D.
3B		13	REV. 128+12 RT.	REV. 129.75 RT.	4000 SF±		ALL R. T. & I.	WD	07-11-01	ROYALTON	47	4-5	VT RTE. 14 HWY EASEMENT	10	11,13	PARCEL NO. 1A CRAWFORD. DELETE CLEAR & TRIM (P); ADD SLOPE (T) TO LAYOUT AND DETAIL SHEET WITH AREA OF 205 SF±. PER C.O. 9109.	3-22-00	R. B. K.	R. P. D.
4	TOWN OF ROYALTON	13,14	REV. 129+75 RT. REV. 129+75 RT. REV. 129+78 RT. REV. 129+82 RT.	REV. 132+50 RT. REV. 130+20 RT. REV. 129+85 RT. REV. 130+35 RT.	0.15 A±		ALL R. T. & I. SLOPE (T) 300 SF± WALK (T) CONST. EASE. (T) 305 SF±	QCD	01-11-00	ROYALTON	62	440	VT RTE. 14 HWY EASEMENT	11	11,13	PARCEL NO. 1 CRAWFORD. ADD PARCEL 1D; REV. 128+38 LT. ~ REV. 128+98 LT.; 3925 S.F.± MITIGATION SITE. REDUCE AREA IN PARCEL 1B FROM 0.17A± TO 3480 S.F.±. PER C.O. 9111.	4-04-00	M. J. R.	R. P. D.
5	C. V. P. S. CORP.												UTILITY						
6	BELL ATLANTIC												UTILITY			MYLAR REPRODUCIBLES TO STRUCTURES 6-12-01			
7	THE HELICON GROUP, L.P.												UTILITY						
REVISED	10-11-99																		

<p>ACCT.MRyan \\vaot_cadd\fillingcabline\78f232\RightofWay\F232d.dgn DATE PLOTTED 05-SEP-2001 F232d2.1</p>	<p>DR. (P)- DRAINAGE RIGHT DIT. (P)- DITCHING RIGHT CH. (P)- CHANNEL RT. DRIVE (T)- DRIVE RIGHT CUL. (P)- CULVERT RIGHT [W]- WATER SOURCES</p>	<p>PRESENT R.O.W.  TAKING WITHOUT ACCESS  TAKING WITHOUT ACCESS ALONG PROPERTY LINE  TAKING WITH ACCESS (P) PERMANENT EASEMENT (T) TEMPORARY EASEMENT</p>	<p>LEGEND . . . CZ (P) CLEAR ZONE --- CONST. (T) --- CONSTRUCTION EASEMENT SR SR SLOPE RIGHTS P PROPERTY LINE △ TOP OF CUT ○ TOE OF SLOPE</p>	<p>R. O. W. PLANS ROYALTON BRS 0147(5) S R. O. W. SHEET 12 OF 14 SHEETS SHEET 106 OF 76</p>
<p>APPROVED: LAWRENCE BLISS DATE: 06-16-98 AGENT D, PLANS & TITLES</p>				