
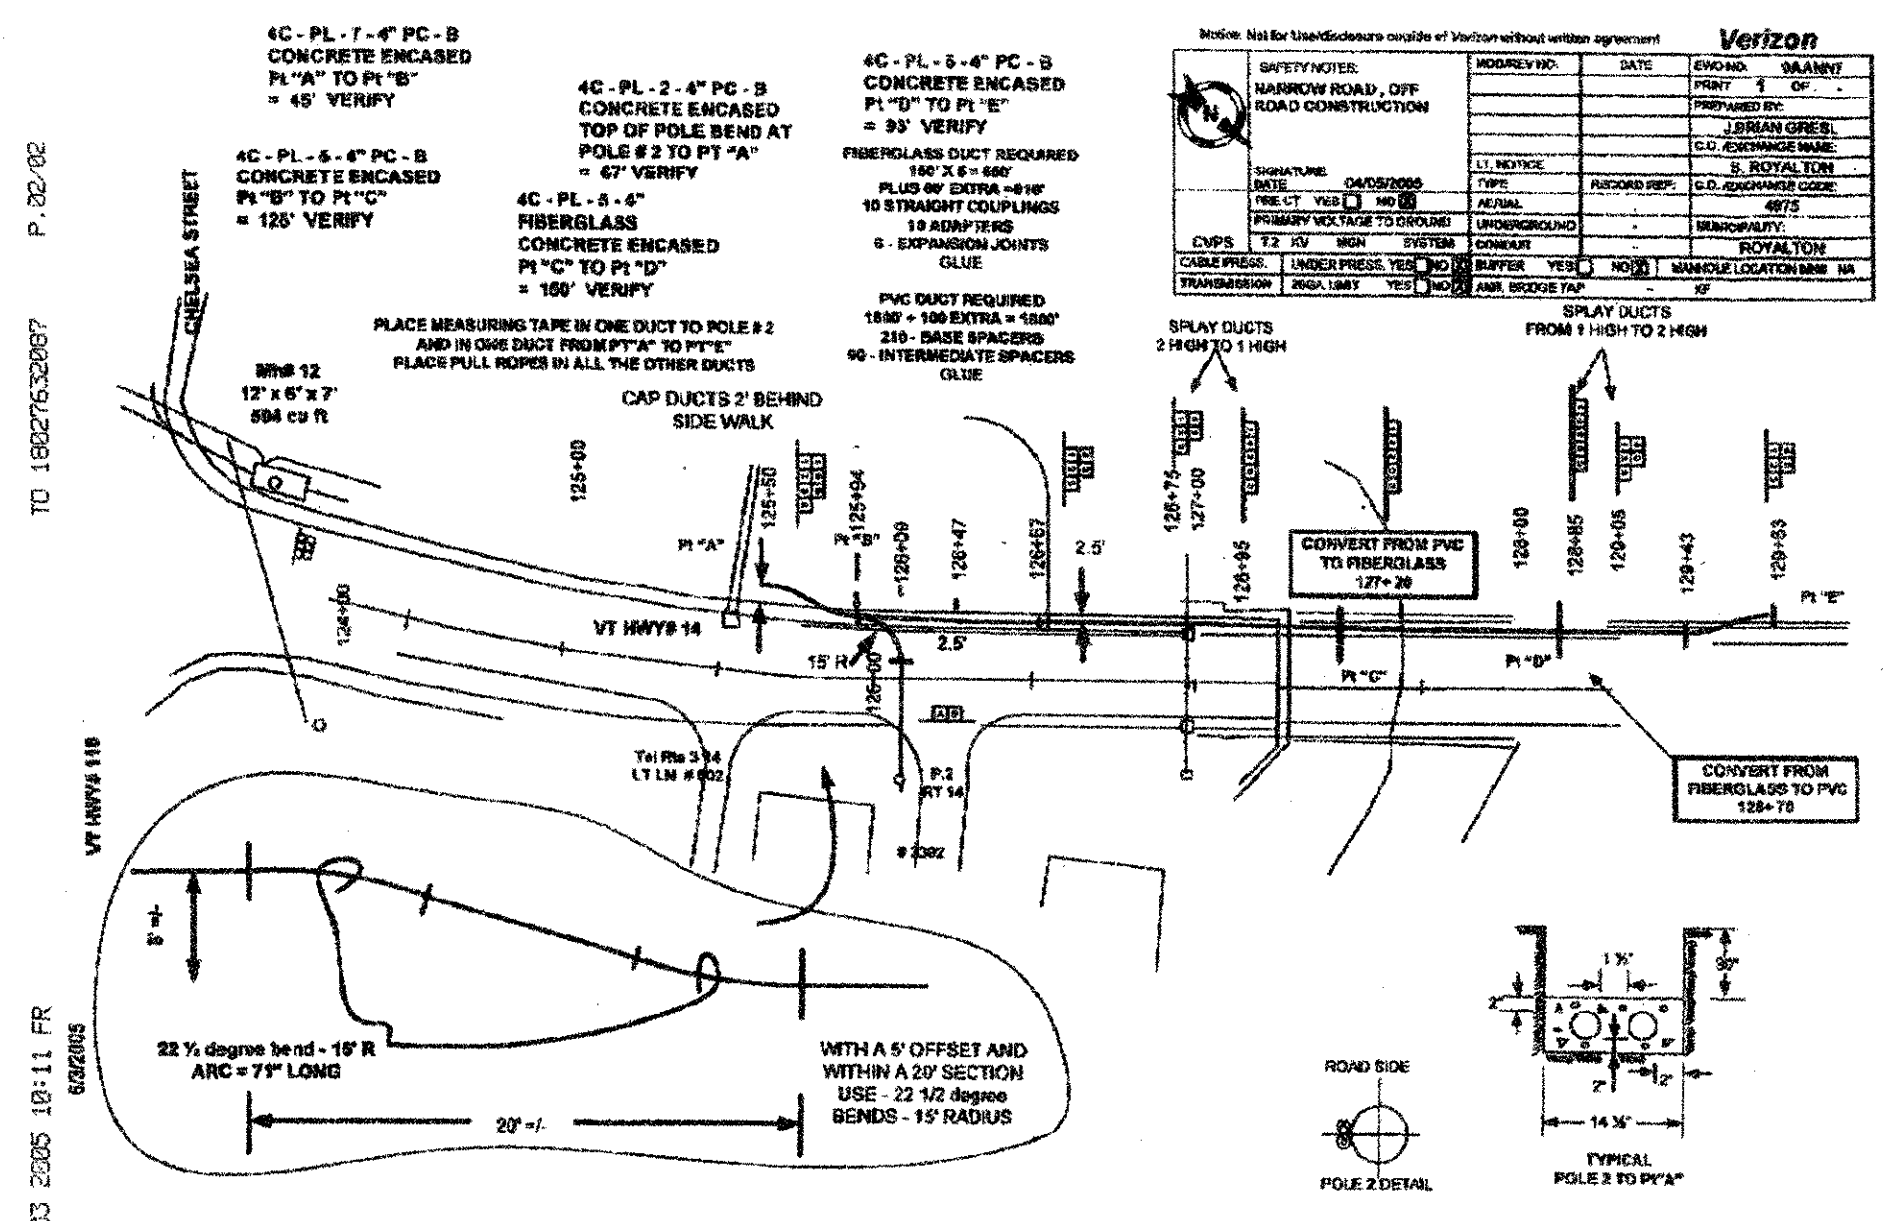


F:\Proj90-94\1298 Roylton\Hwy\ACAD\1298\1298\4-23-99 10:29:38 am EST

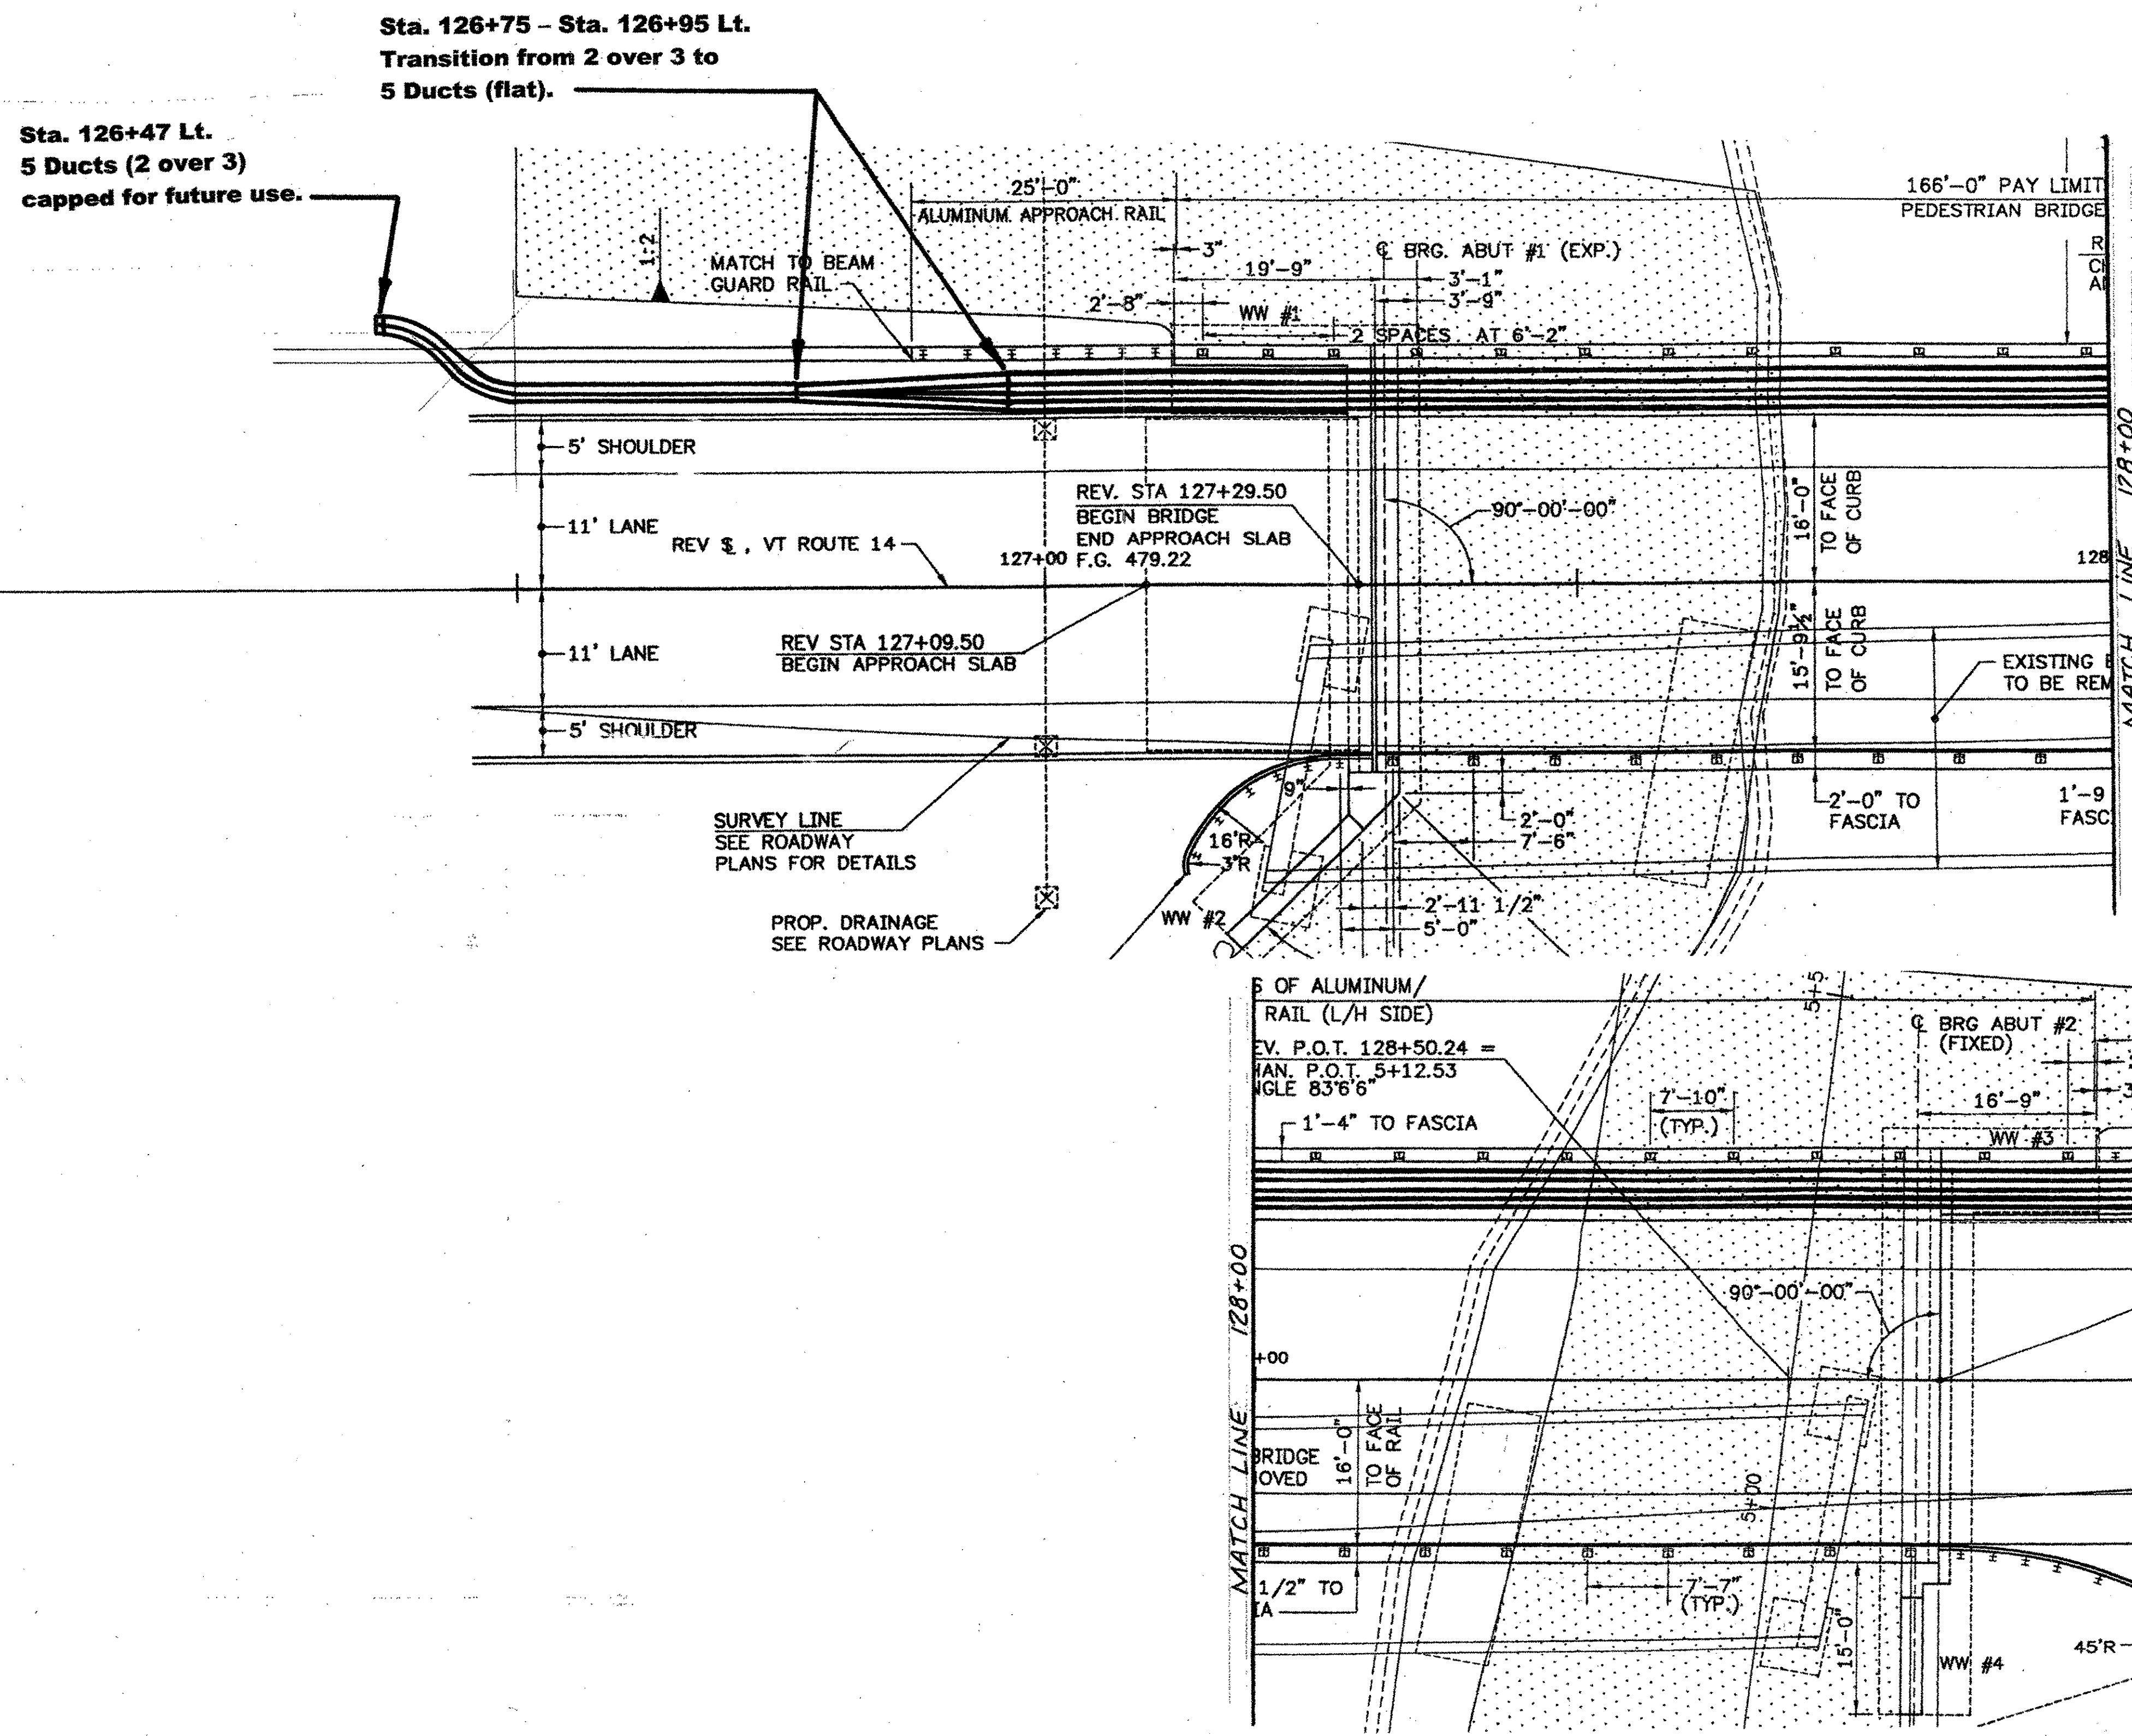

DATE	BY	CHKD	APP'D
12/15/00	J. BROWN		
12/15/00	J. BROWN		
**Sta. 128+85 - 129+05 Lt.**  
Transition from 5 Ducts (flat)  
To 2 over 3.

**Sta. 129+63 Lt.**  
5 Ducts (2 over 3)  
capped for future use.

- Notes:**
- Duct sweeps are approx. 8' radius.
  - Termination of ducts to be 2' minimum from back face of guardrail.

<b>STATE OF VERMONT AGENCY OF TRANSPORTATION</b>			
Town Of	ROYALTON	Bridge No.	21
Highway No.	VT. ROUTE 14	Log Sta.	
VT. Route 14 over the First Branch of the White River			
<b>UTILITY DETAILS</b>			
Designed By		Drawn By	
Checked By	Date	Bridge Design Supervisor	Date
PROJECT	ROYALTON	PROJECT NO.	BRS 0147(5) S
I.G.C. Info.			
Bridge Sheet No.	Sheet 13 Of 76		

DATUM	
VERTICAL	NGVD 1929
HORIZONTAL	N/A