
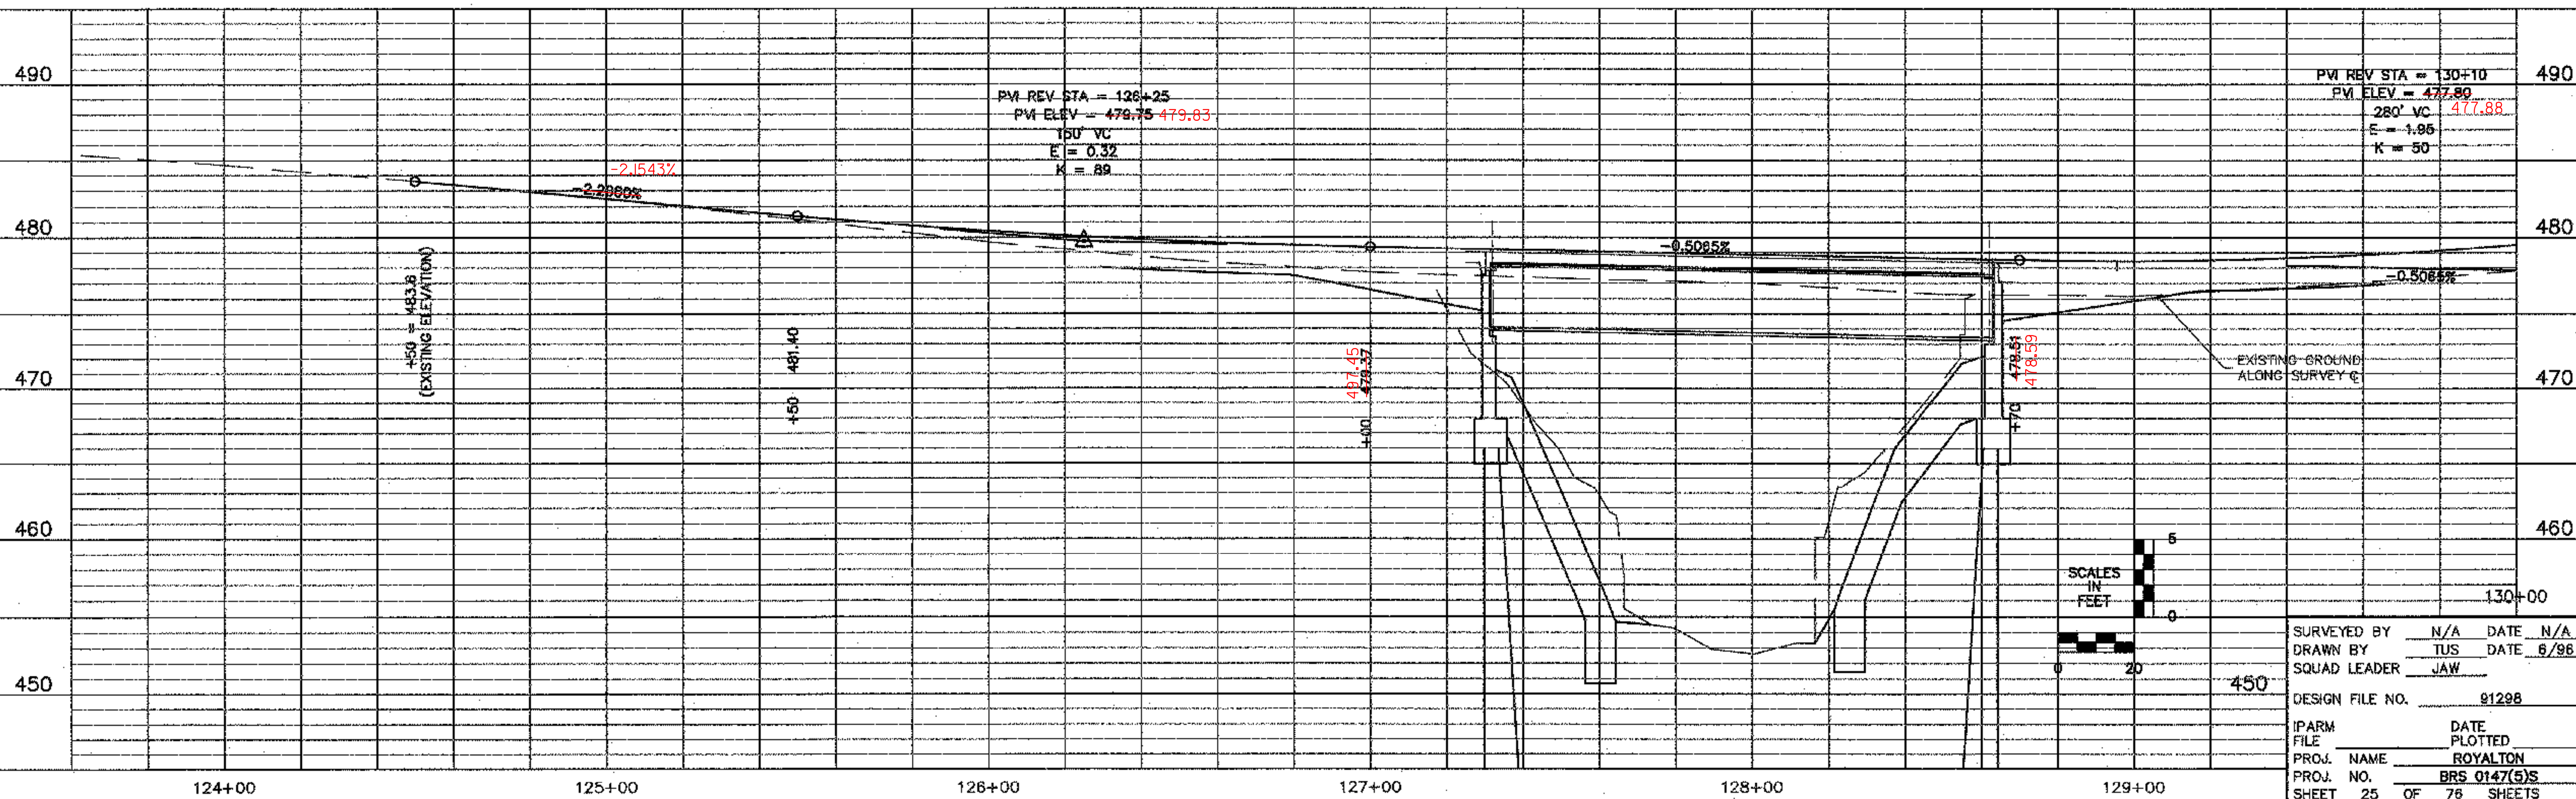
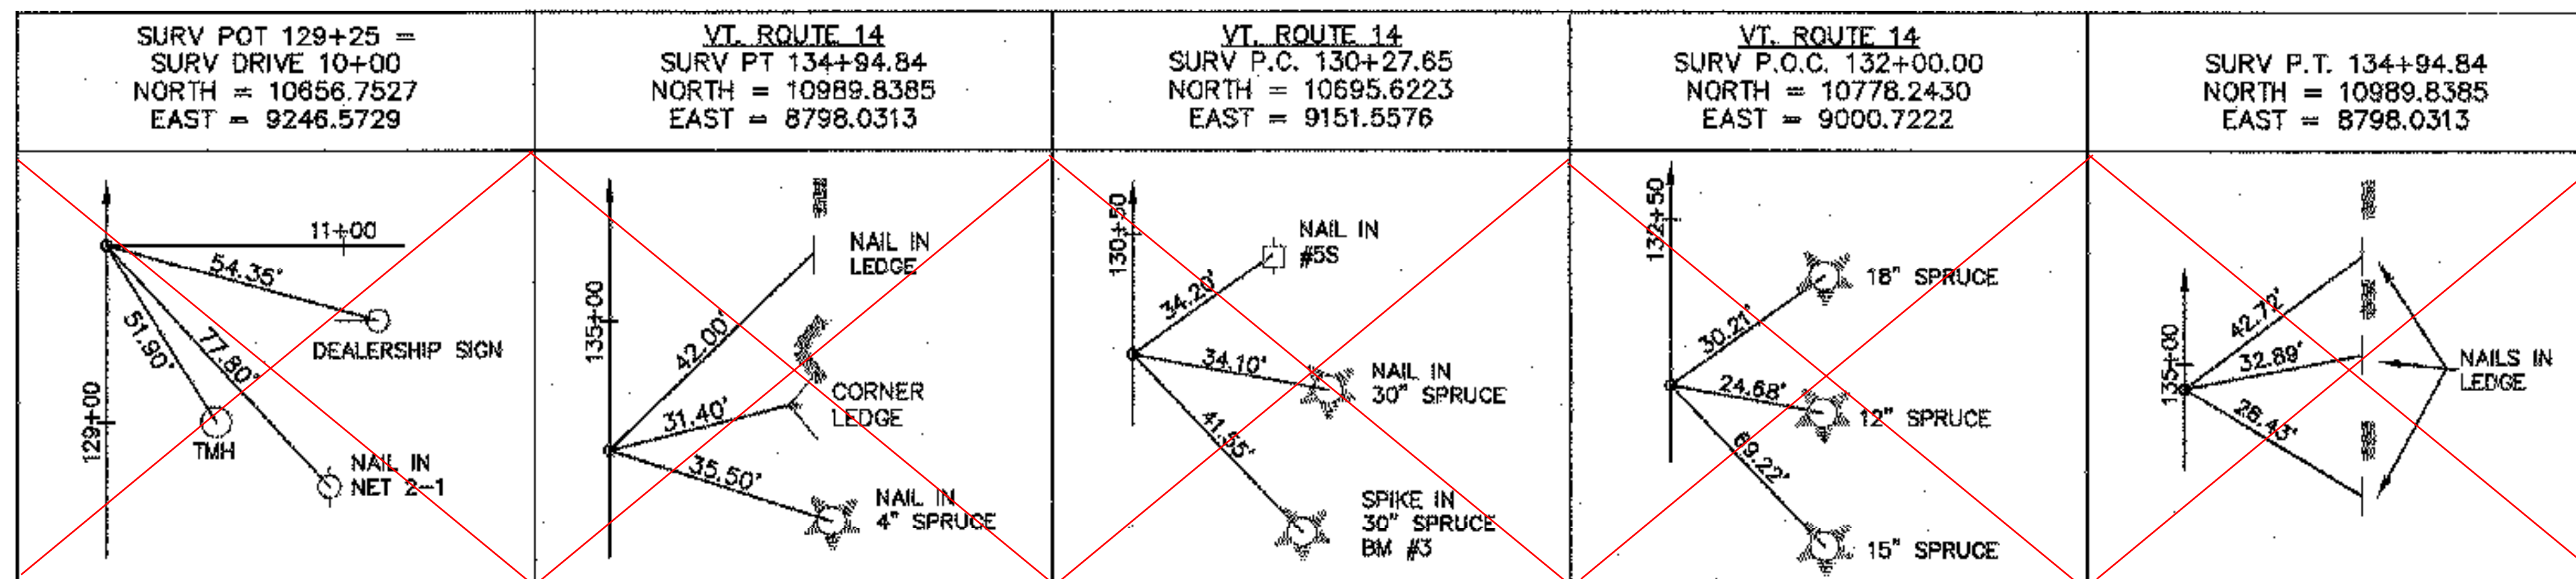


SURVEY LINE TIES

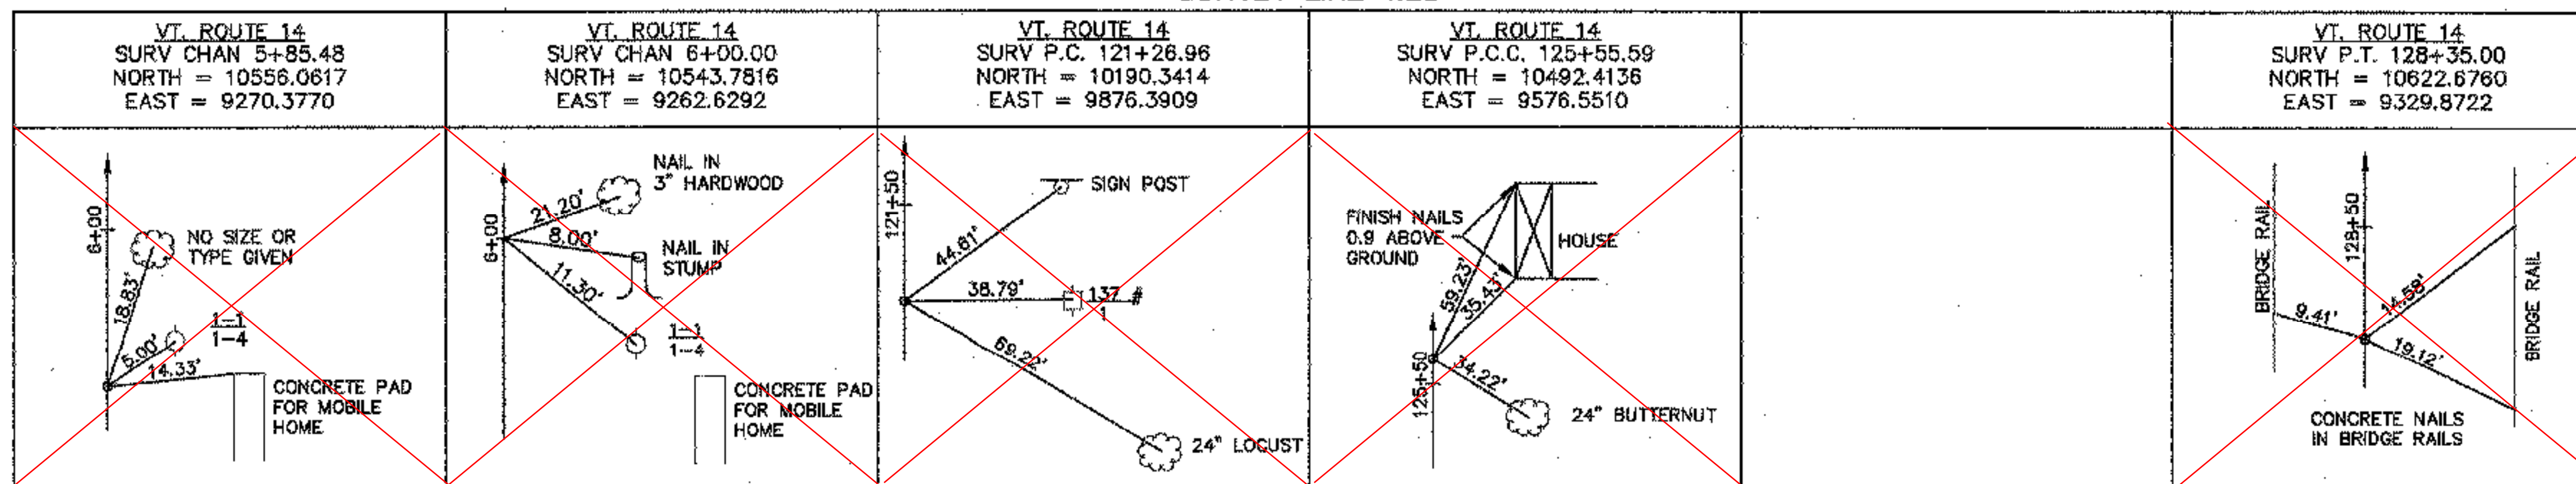

SURVEYED BY	N/A	DATE	N/A
DRAWN BY	TUS	DATE	6/98
SQUAD LEADER	JAW		
DESIGN FILE NO.	91298		
IPARM FILE	DATE PLOTTED		
PROJ. NAME	ROYALTON		
PROJ. NO.	BRS 0147(5)S		
SHEET	25	OF	78 SHEETS