


SHEET 28J OF 76 SHEETS  
 PROJ. NO. BRS 0147(5)  
 PROJ. NAME ROYALTON  
 FILE PLOTTED  
 I/FARM DATE  
 DESIGN FILE NO. 91298  
 SQUAD LEADER JAW  
 DRAWN BY TJS DATE 6/96  
 SURVEYED BY N/A DATE N/A

FINAL CONDITIONS  
SITE PLAN 2

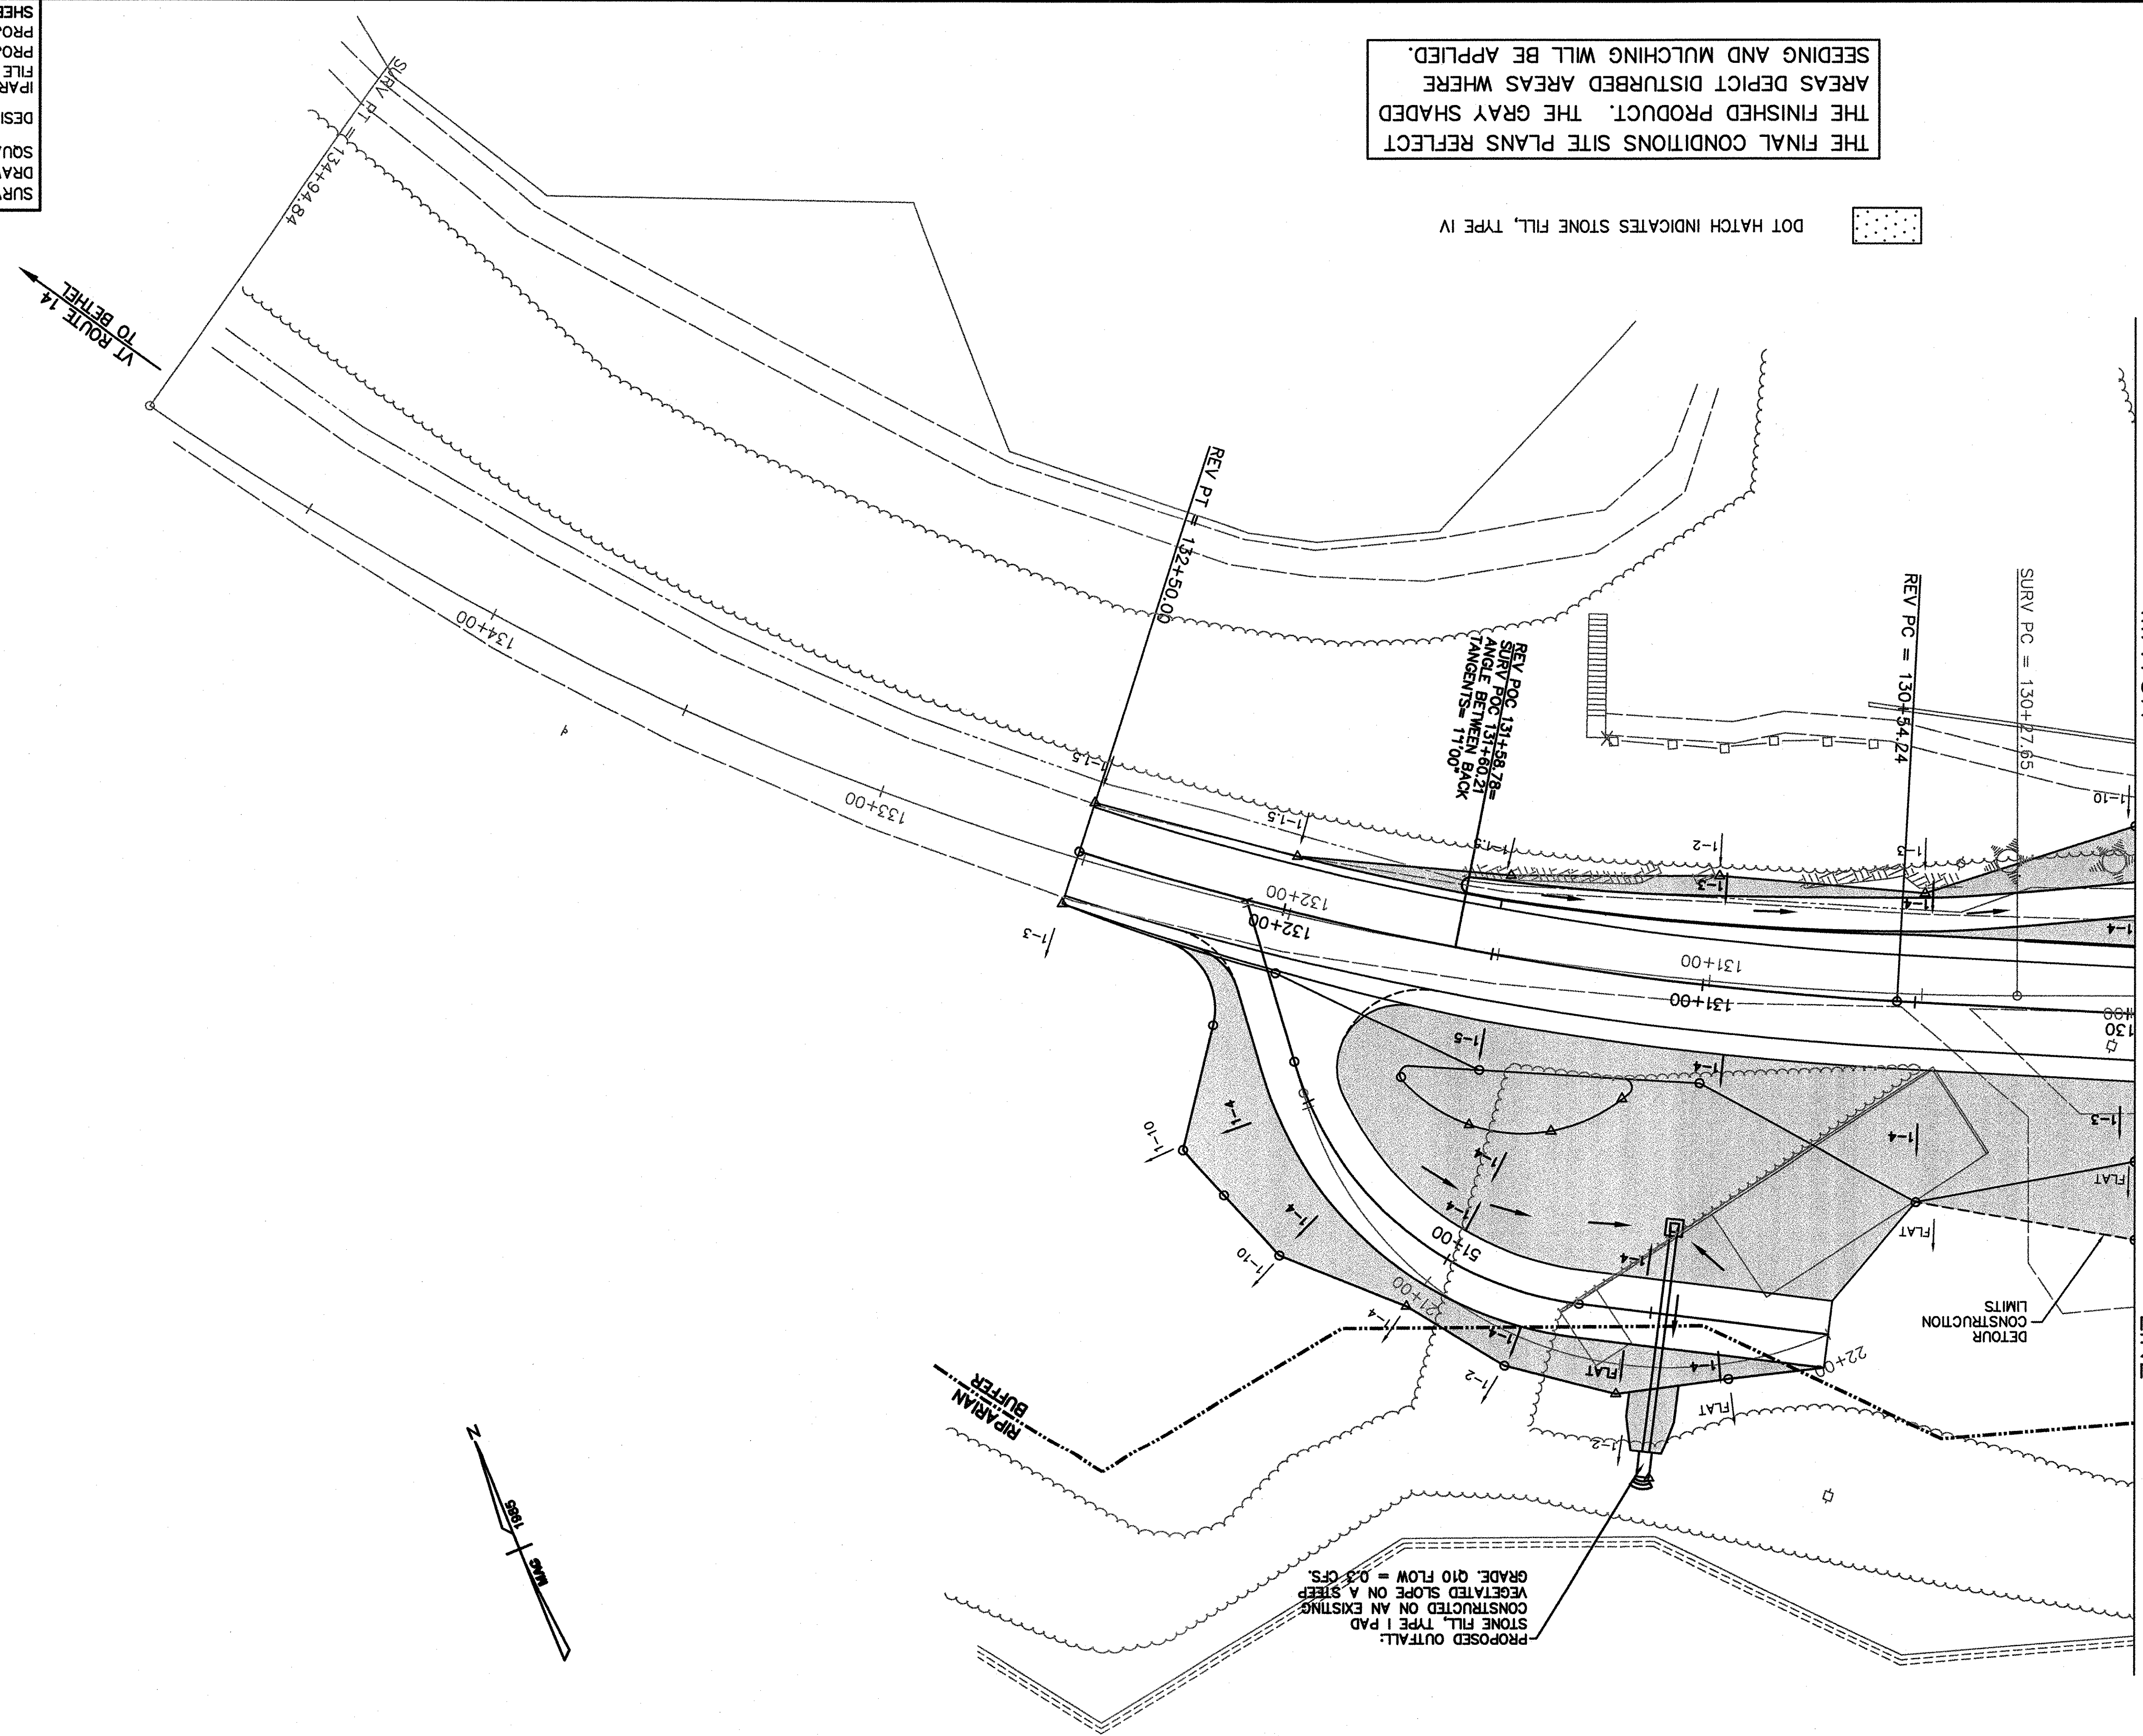

THE FINAL CONDITIONS SITE PLANS REFLECT THE FINISHED PRODUCT. THE GRAY SHADED AREAS DEPICT DISTURBED AREAS WHERE SEEDING AND MULCHING WILL BE APPLIED.

DOT HATCH INDICATES STONE FILL, TYPE IV

PLAN	BY	DATE
SUBMITTED		
PLOTTED		
ALIGNMENT CHECKED		
RT. OF WAY CHECKED		
NOTE BOOK NO.		