


BY	DATE
SURVEYED	
PLOTTED	
ALIGNMENT CHECKED	
RT. OF WAY CHECKED	
PLAN	
NOTE BOOK	
NO.	

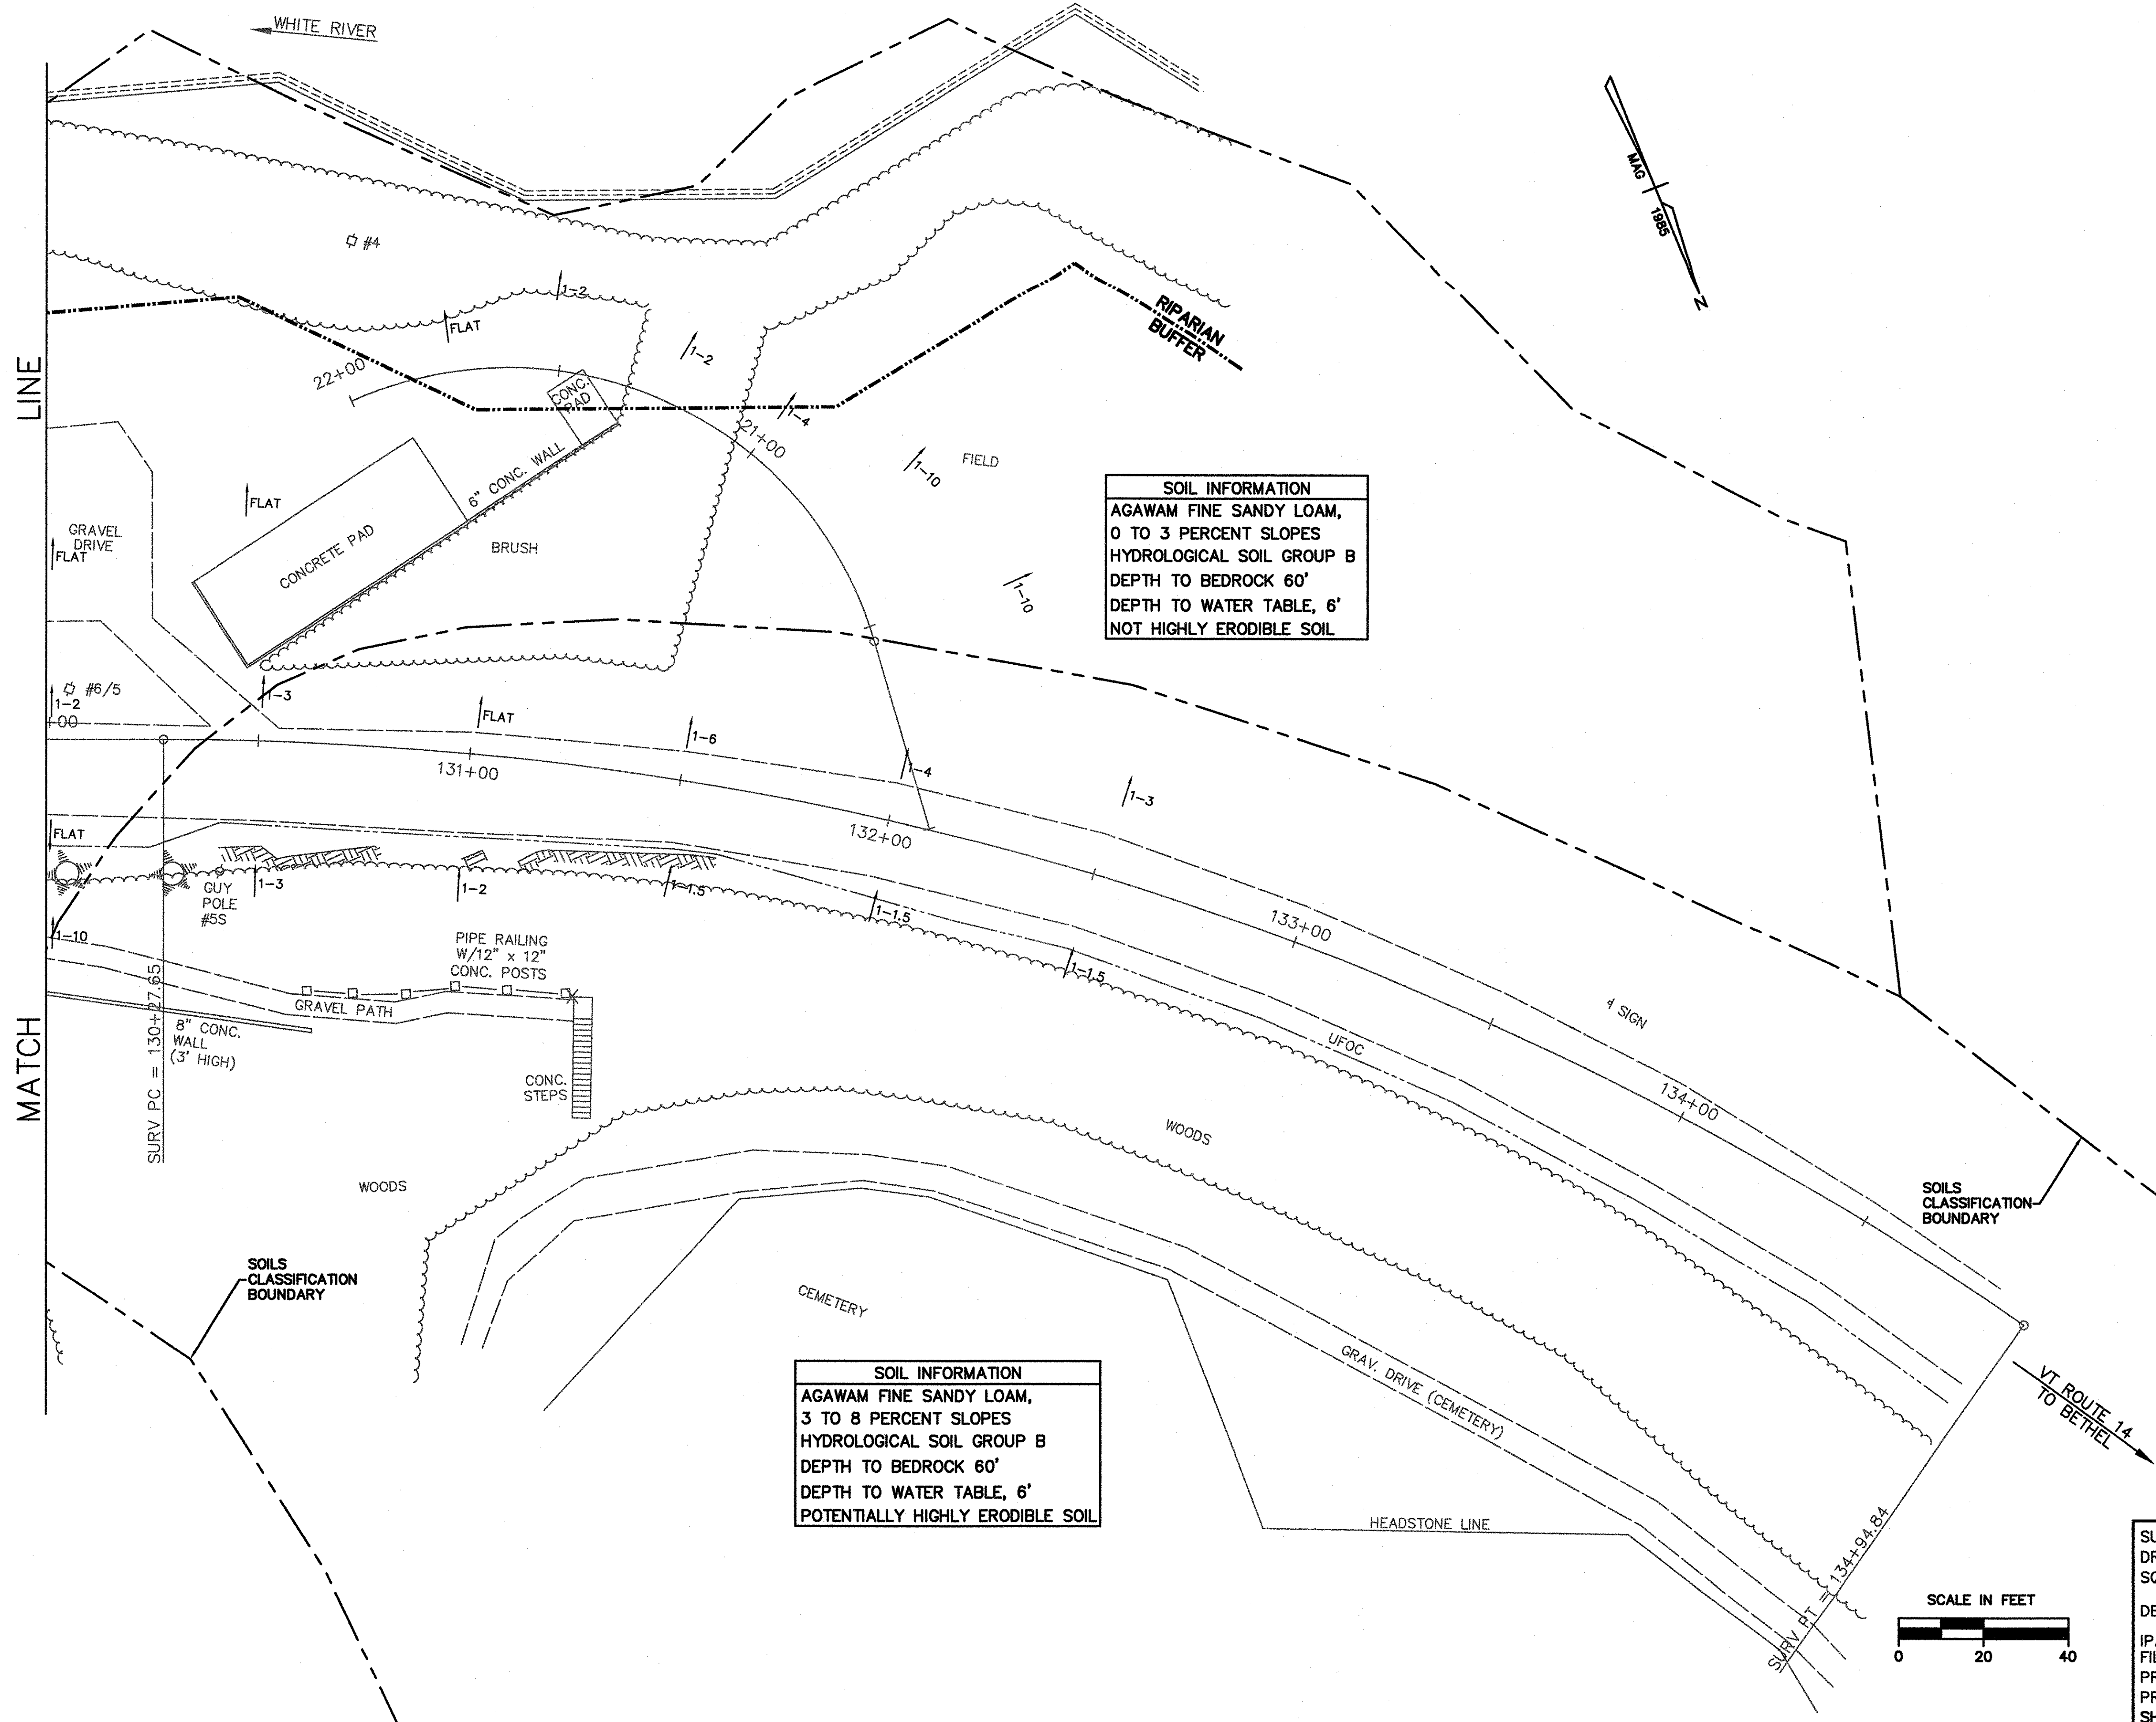

SOIL INFORMATION
 AGAWAM FINE SANDY LOAM,
 0 TO 3 PERCENT SLOPES
 HYDROLOGICAL SOIL GROUP B
 DEPTH TO BEDROCK 60'
 DEPTH TO WATER TABLE, 6'
 NOT HIGHLY ERODIBLE SOIL

SOIL INFORMATION
 AGAWAM FINE SANDY LOAM,
 3 TO 8 PERCENT SLOPES
 HYDROLOGICAL SOIL GROUP B
 DEPTH TO BEDROCK 60'
 DEPTH TO WATER TABLE, 6'
 POTENTIALLY HIGHLY ERODIBLE SOIL

**EXISTING CONDITIONS
 SITE PLAN 2**

SURVEYED BY	N/A	DATE	N/A
DRAWN BY	TUS	DATE	6/96
SQUAD LEADER	JAW		
DESIGN FILE NO.	91298		
IPARM FILE		DATE PLOTTED	
PROJ. NAME	ROYALTON		
PROJ. NO.	BRS 0147(5)S		
SHEET	28F	OF	76 SHEETS

