

PAVEMENT MARKINGS


DURABLE 4" DOUBLE YELLOW LINE
REV 124+50 TO 132+50 (CENTERLINE)

TEMPORARY 4" DOUBLE YELLOW LINE
REV 124+50 TO 132+50 (CENTERLINE)

DURABLE 4" WHITE LINE
REV 124+50 TO 132+50 LT
REV 124+50 TO 132+50 RT

TEMPORARY 4" WHITE LINE
REV 124+50 TO 132+50 LT
REV 124+50 TO 132+50 RT

REMOVING SIGNS
47 EACH

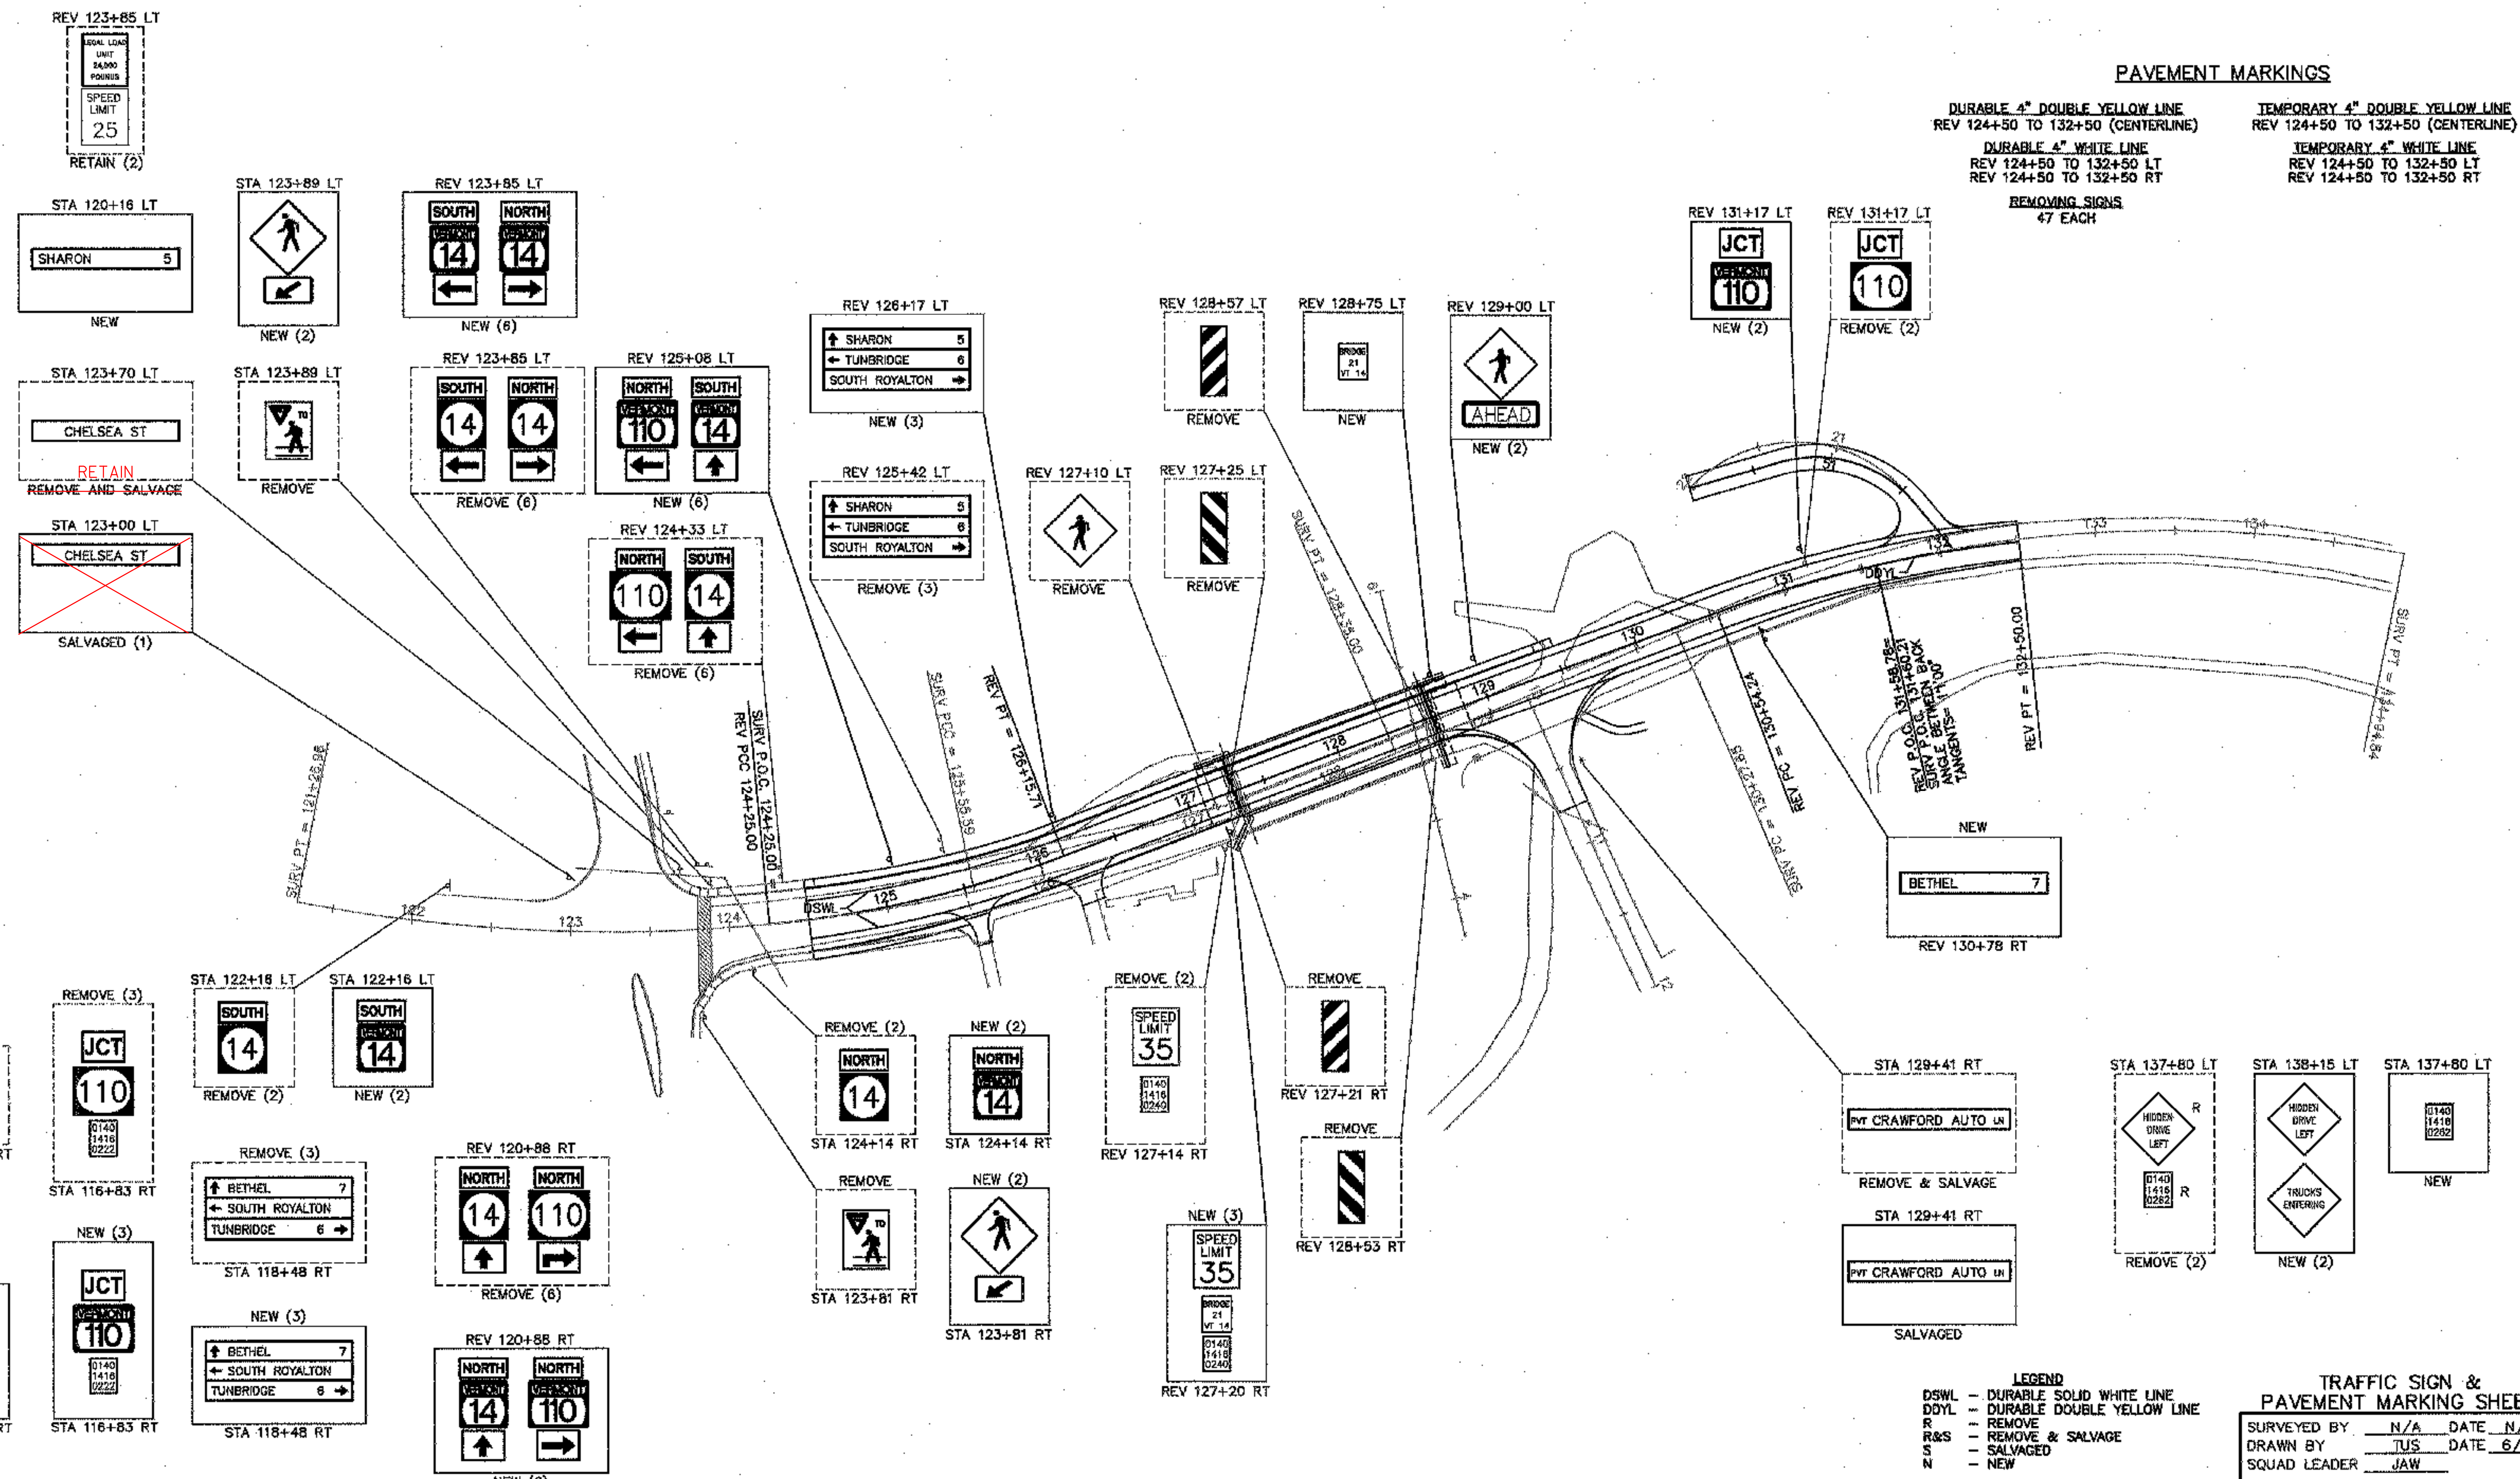

LEGEND

DSWL - DURABLE SOLID WHITE LINE
DDYL - DURABLE DOUBLE YELLOW LINE
R - REMOVE
R&S - REMOVE & SALVAGE
S - SALVAGED
N - NEW

TRAFFIC SIGN & PAVEMENT MARKING SHEET

SURVEYED BY: N/A DATE: N/A
DRAWN BY: TJS DATE: 6/96
SQUAD LEADER: JAW

DESIGN FILE NO. 91298

IPARM FILE DATE PLOTTED
PROJ. NAME ROYALTON
PROJ. NO. BRS 0147(5)S
SHEET 31 OF 76 SHEETS

