
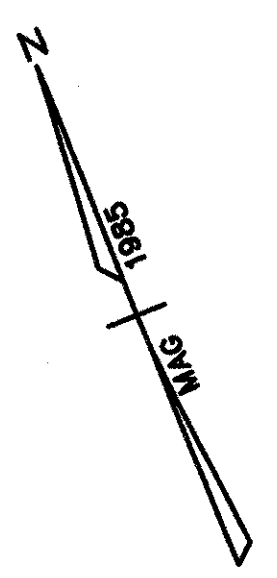


TRAFFIC CONTROL PLAN

SURVEYED BY N/A DATE N/A  
 DRAWN BY TJS DATE 6/96  
 SQUAD LEADER JAW  
 DESIGN FILE NO. 91298

IPARM DATE PLOTTED  
 FILE ROYALTON  
 PROJ. NAME BRS 0147(S)  
 PROJ. NO. SHEET 36 OF 76 SHEETS

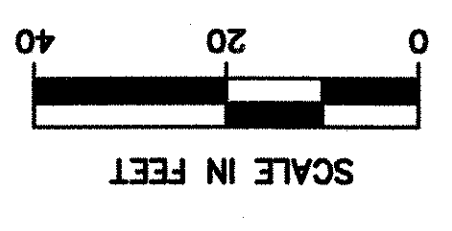

MATCH

LINE

PLAN NO.	SURVEYED	BY	DATE