


ALUMINUM APPROACH RAILING	
LOCATION	PAY LENGTH
WW 1	25'-0"
WW 2	21'-9"
WW 3	25'-0"
WW 4	50'-11"

PLAN
SCALE: 1"=10'

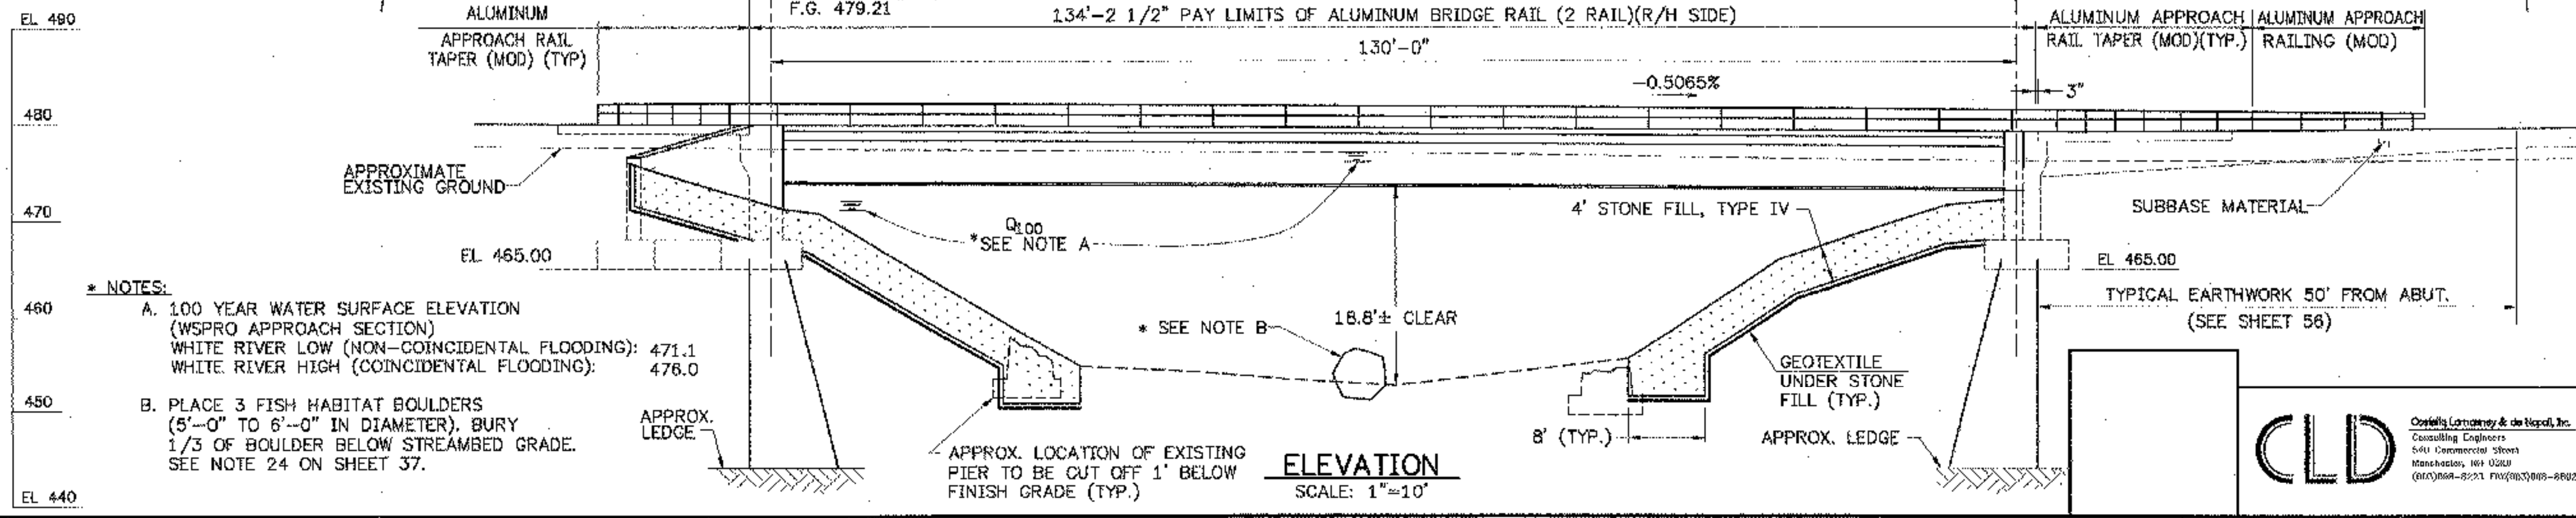

ELEVATION
SCALE: 1"=10'

--- INDICATES STONE FILL, TYPE IV
(MOD) --- INDICATES 2 RAIL MODIFIED FROM 3 RAIL STANDARDS.

**STATE OF VERMONT
AGENCY OF TRANSPORTATION**

Town Of	ROYALTON	Bridge No.	21
Highway No.	VT. ROUTE 14	Log Sta.	
VT. Route 14 over the First Branch of the White River			

PLAN AND ELEVATION

Designed By	AS	Drawn By	GFB
Checked By	CLW/LMM	Date	11/00
PROJECT		ROYALTON	

PROJECT NO.		BRS 0147(5) S	
I.G.C. Info.			

