



* ADJUST SPACING OF FERRULES, COUNTERBORED HOLES AND STUDS FOR CLEARANCE IN VICINITY OF BRACKETS AND BLOCKOUT FOR DOWNSPOUT.

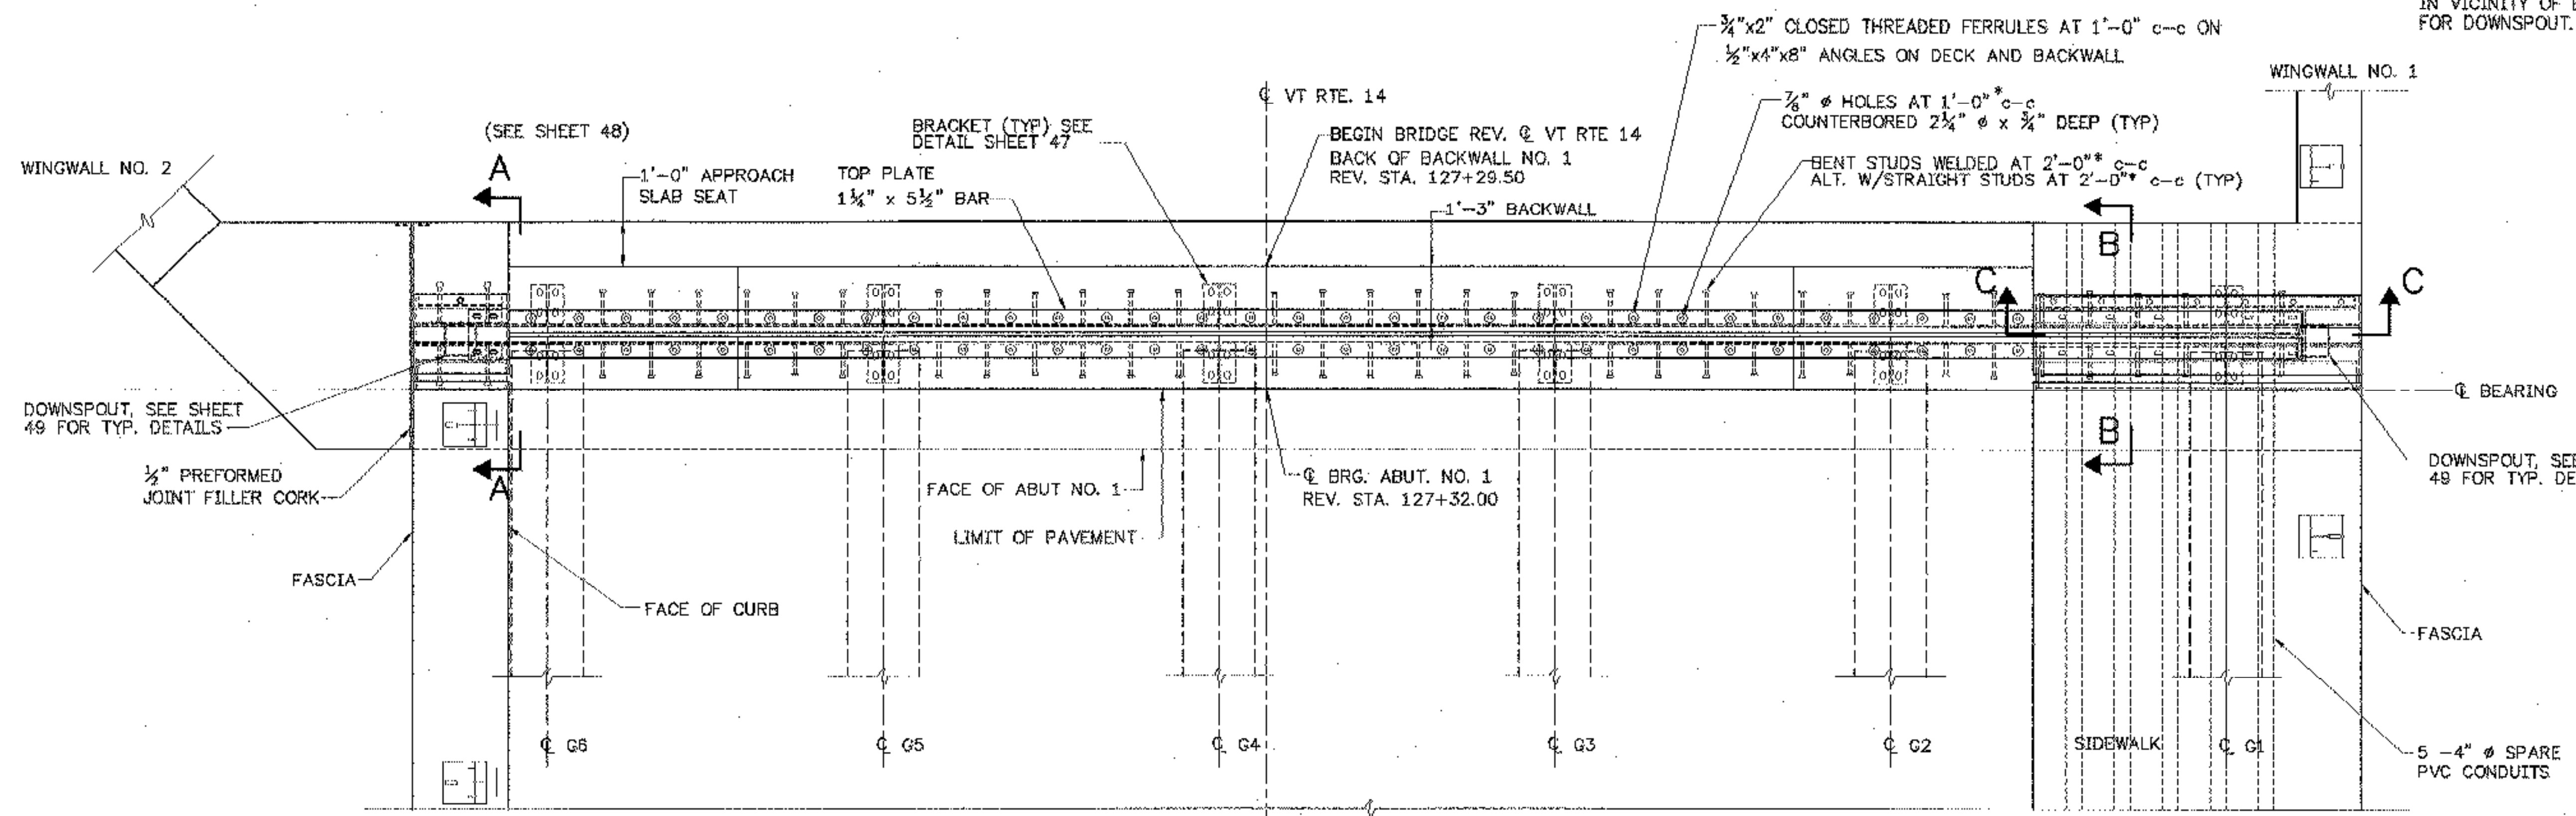

PLAN
Scale: 1/2" = 1'-0"

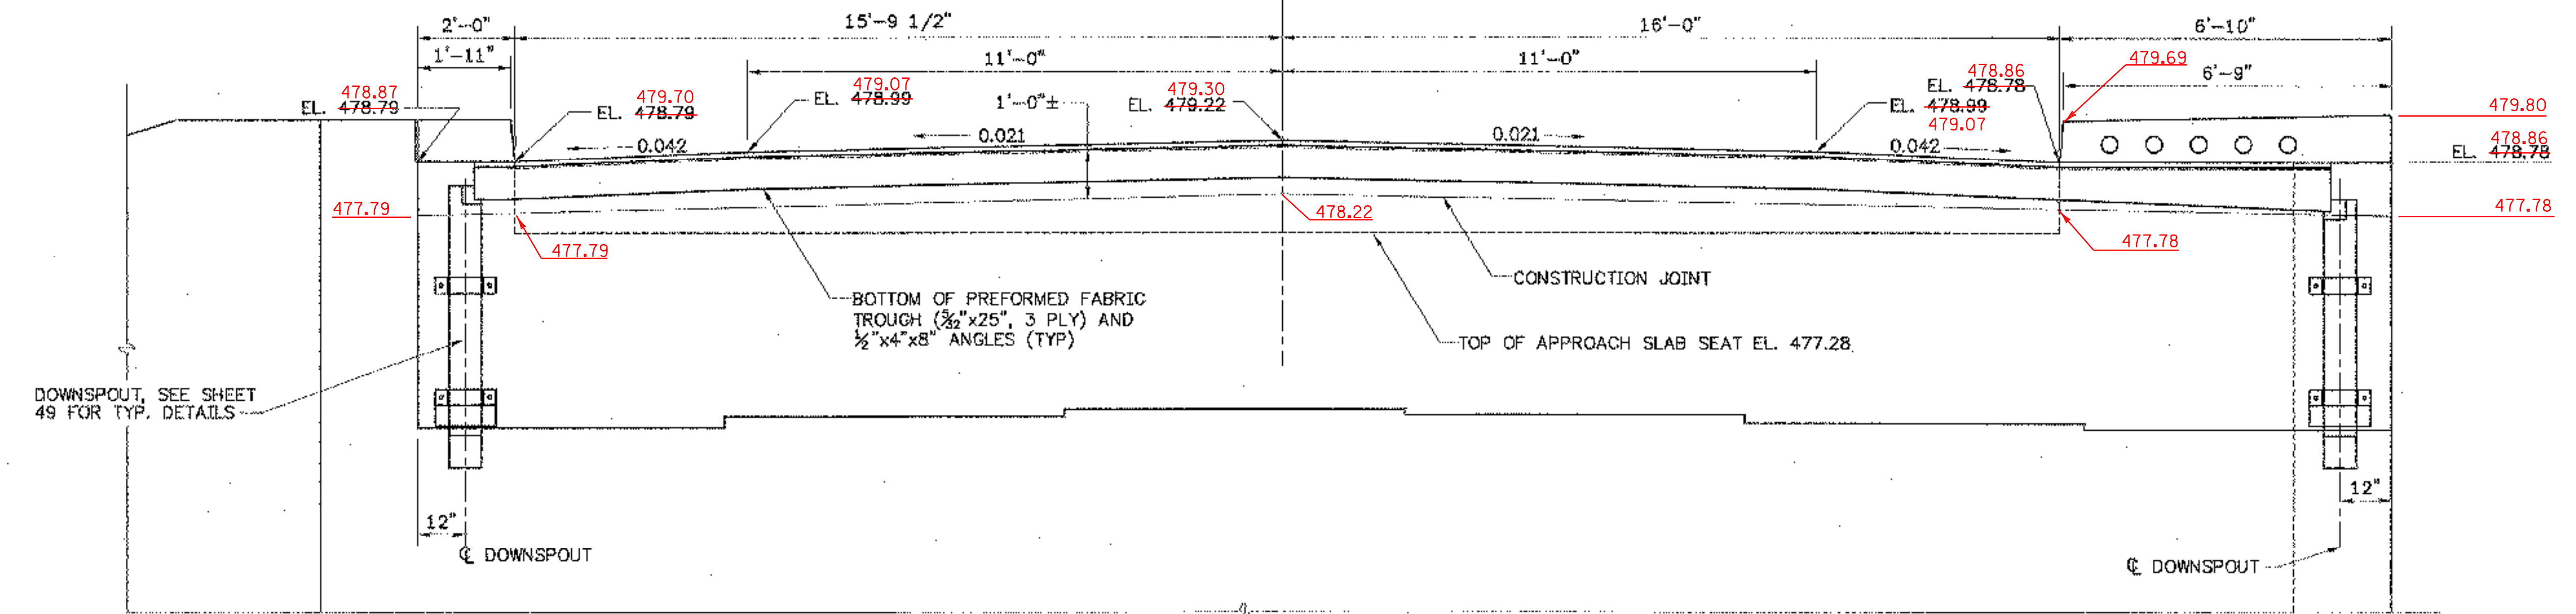

ELEVATION ABUT NO 1
(THROUGH CL. JOINT, LOOKING AT BACKWALL)
Scale: 1/2" = 1'-0"

SEE BRIDGE SHEETS 47, 48 FOR EXPANSION JOINT DETAILS AND SECTIONS.

STATE OF VERMONT AGENCY OF TRANSPORTATION			
Town Of	ROYALTON	Bridge No.	21
Highway No.	VT. ROUTE 14	Log Sta.	
VT. Route 14 over the White River		Surv. Sta.	
EXPANSION JOINT PLAN AND ELEVATION			
Designed By	AS	Drawn By	KBG
Checked By	Date	Bridge Design Supervisor	Date
CLW/LMM	11/00	LMM	11/00
PROJECT	ROYALTON	PROJECT NO.	BRS 0147(5) S
I.G.C. Info.		Sheet 46 Of 82	
Bridge Sheet No.			

