


NOTES:
1. ALL DIMENSIONS ARE IN FEET.
2. ALL ELEVATIONS ARE IN FEET.
3. ALL GRADES ARE TO BE CONFORMED TO THE SPECIFICATIONS FOR HIGHWAY CONSTRUCTION.

NOTES:
1. ALL DIMENSIONS ARE IN FEET.
2. ALL ELEVATIONS ARE IN FEET.
3. ALL GRADES ARE TO BE CONFORMED TO THE SPECIFICATIONS FOR HIGHWAY CONSTRUCTION.

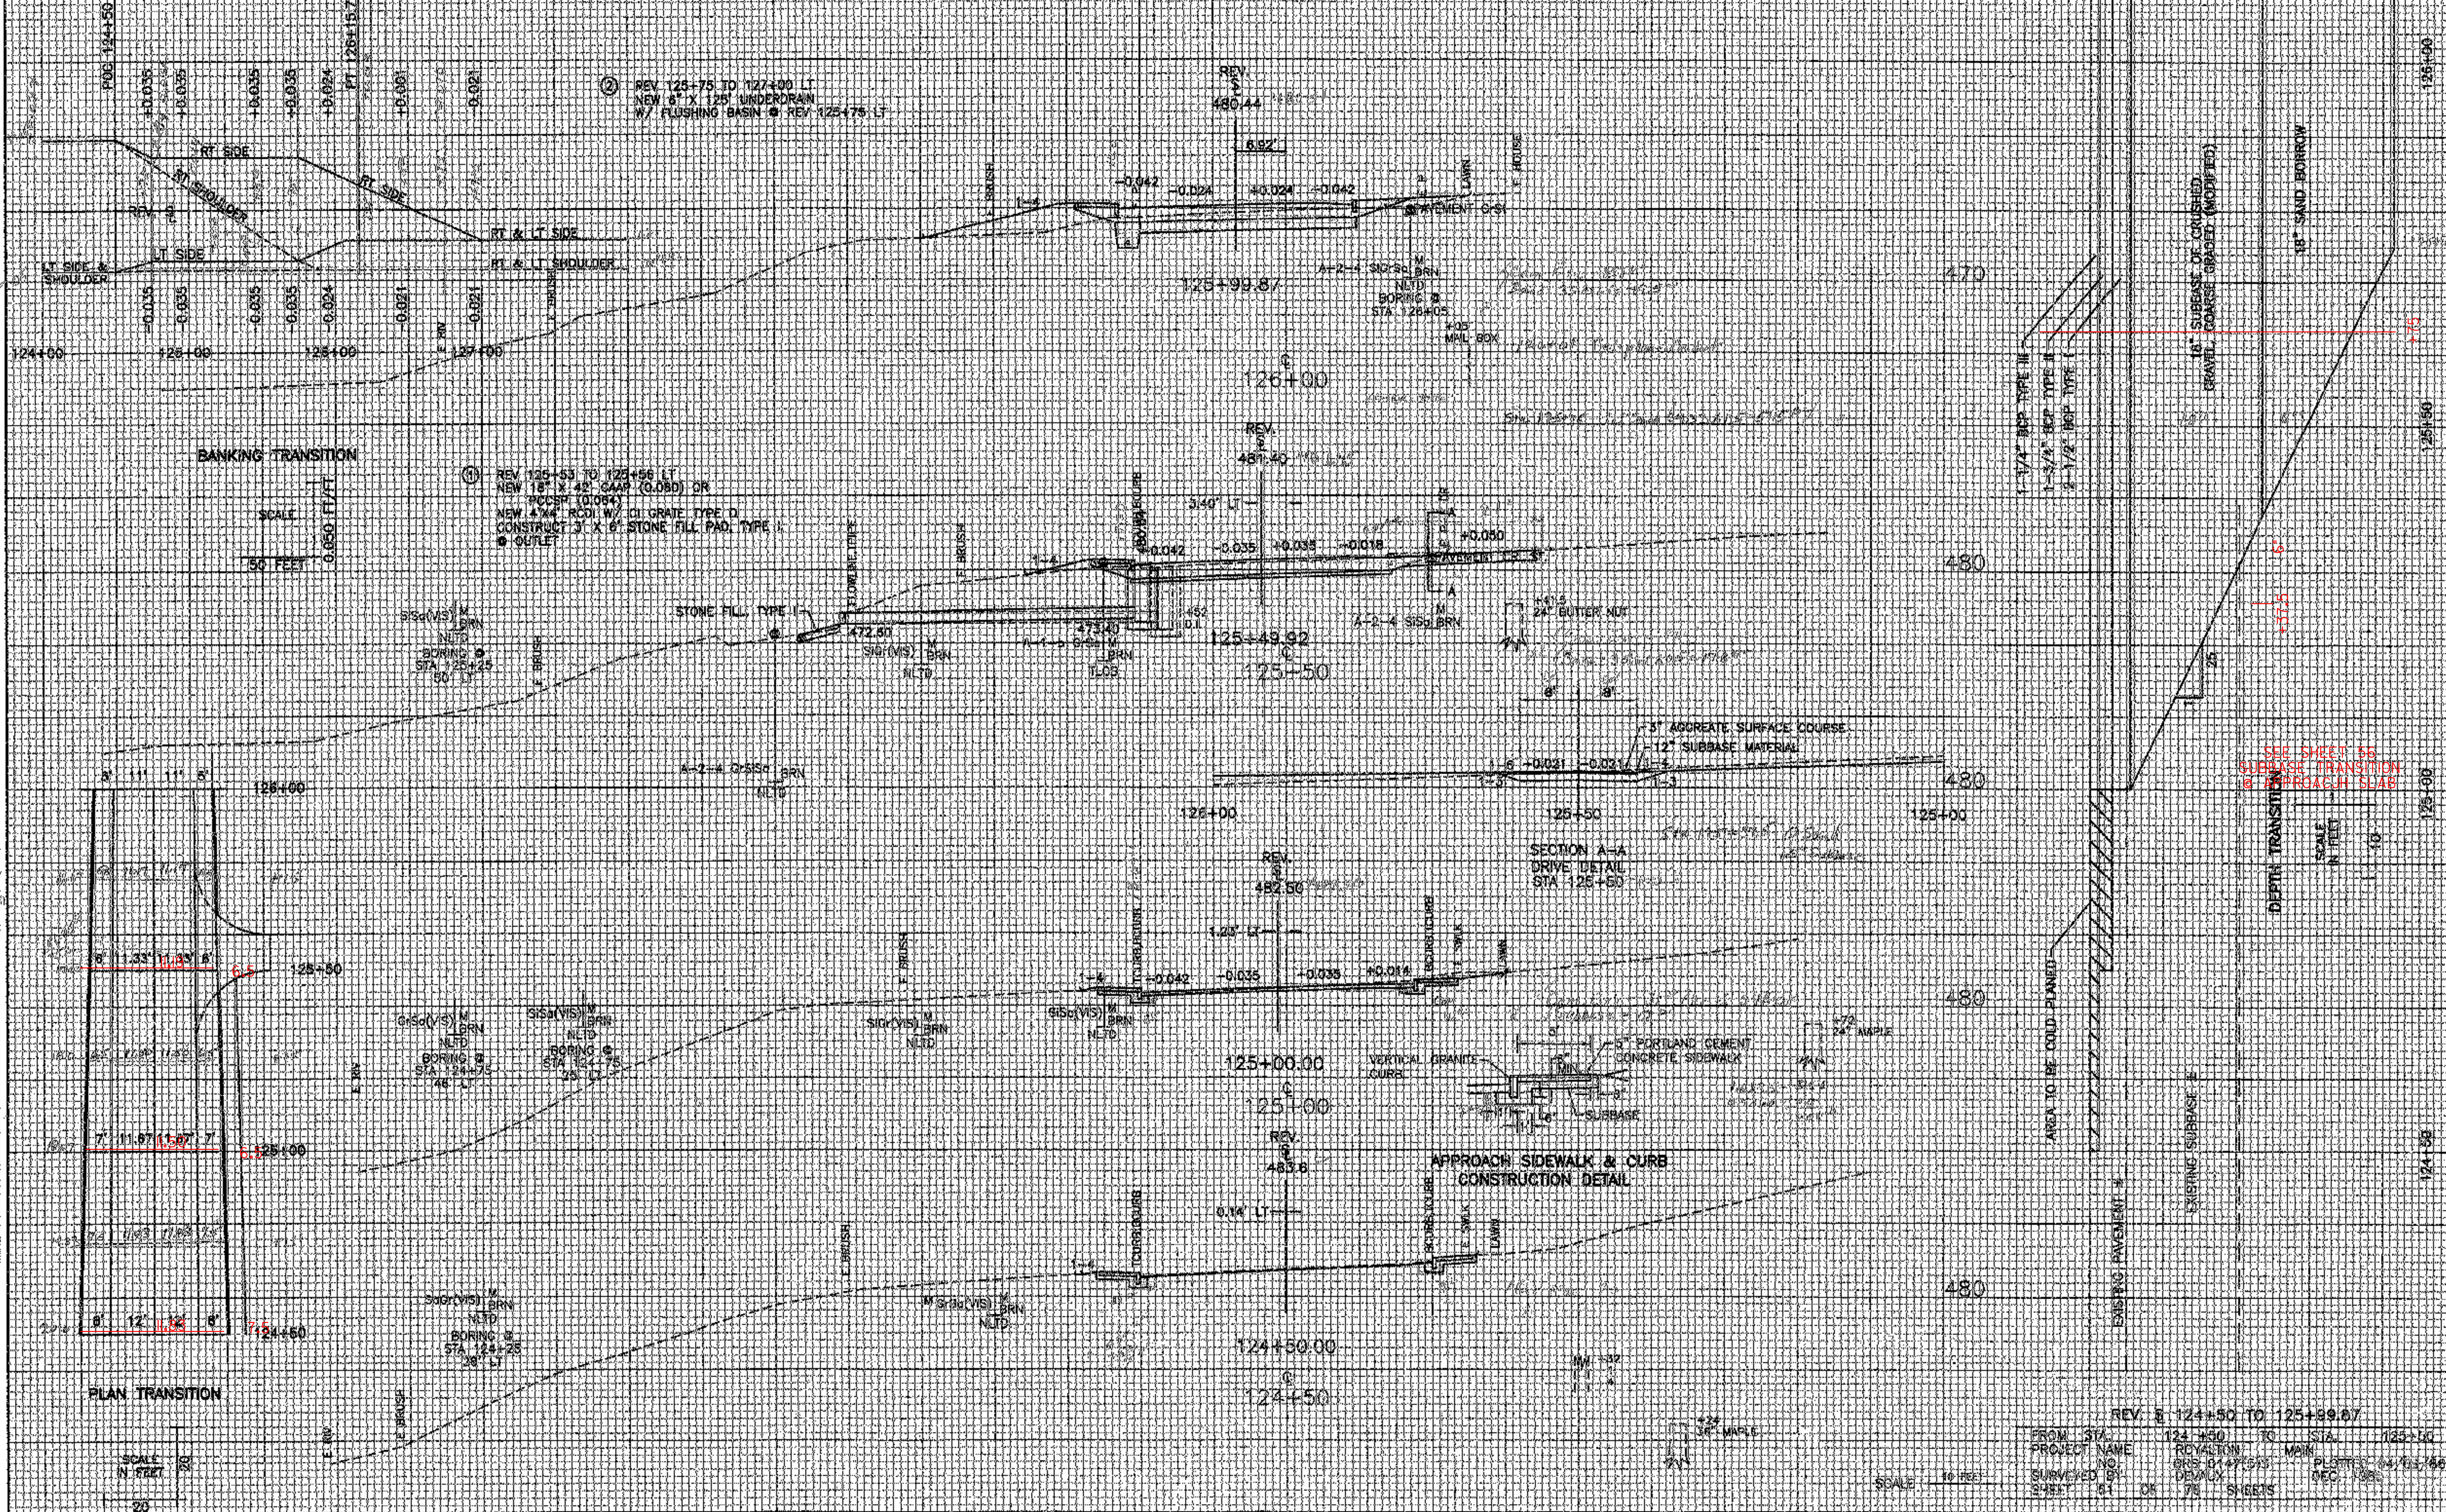

PLAN TRANSITION

SCALE
IN FEET
25

REV. 124+50 TO 125+99.67				
FROM STA.	124+50	TO STA.	125+99.67	
PROJECT NAME	ROYALTON MAIN			
NO.	0147503	PLANS	04/15/86	
SURVEYED BY	DEMAY	DEC	1986	
SHEET	61	OF	78	SHEETS