


| | |
|---------------|--|
| DATE | |
| BY | |
| NO. | |
| FINAL SURVEY | |
| PLOTTED | |
| NO. DATE | |
| AREAS CHECKED | |

| | |
|-----------------|--|
| DATE | |
| BY | |
| NO. | |
| ORIGINAL SURVEY | |
| PLOTTED | |
| NO. DATE | |
| AREAS CHECKED | |

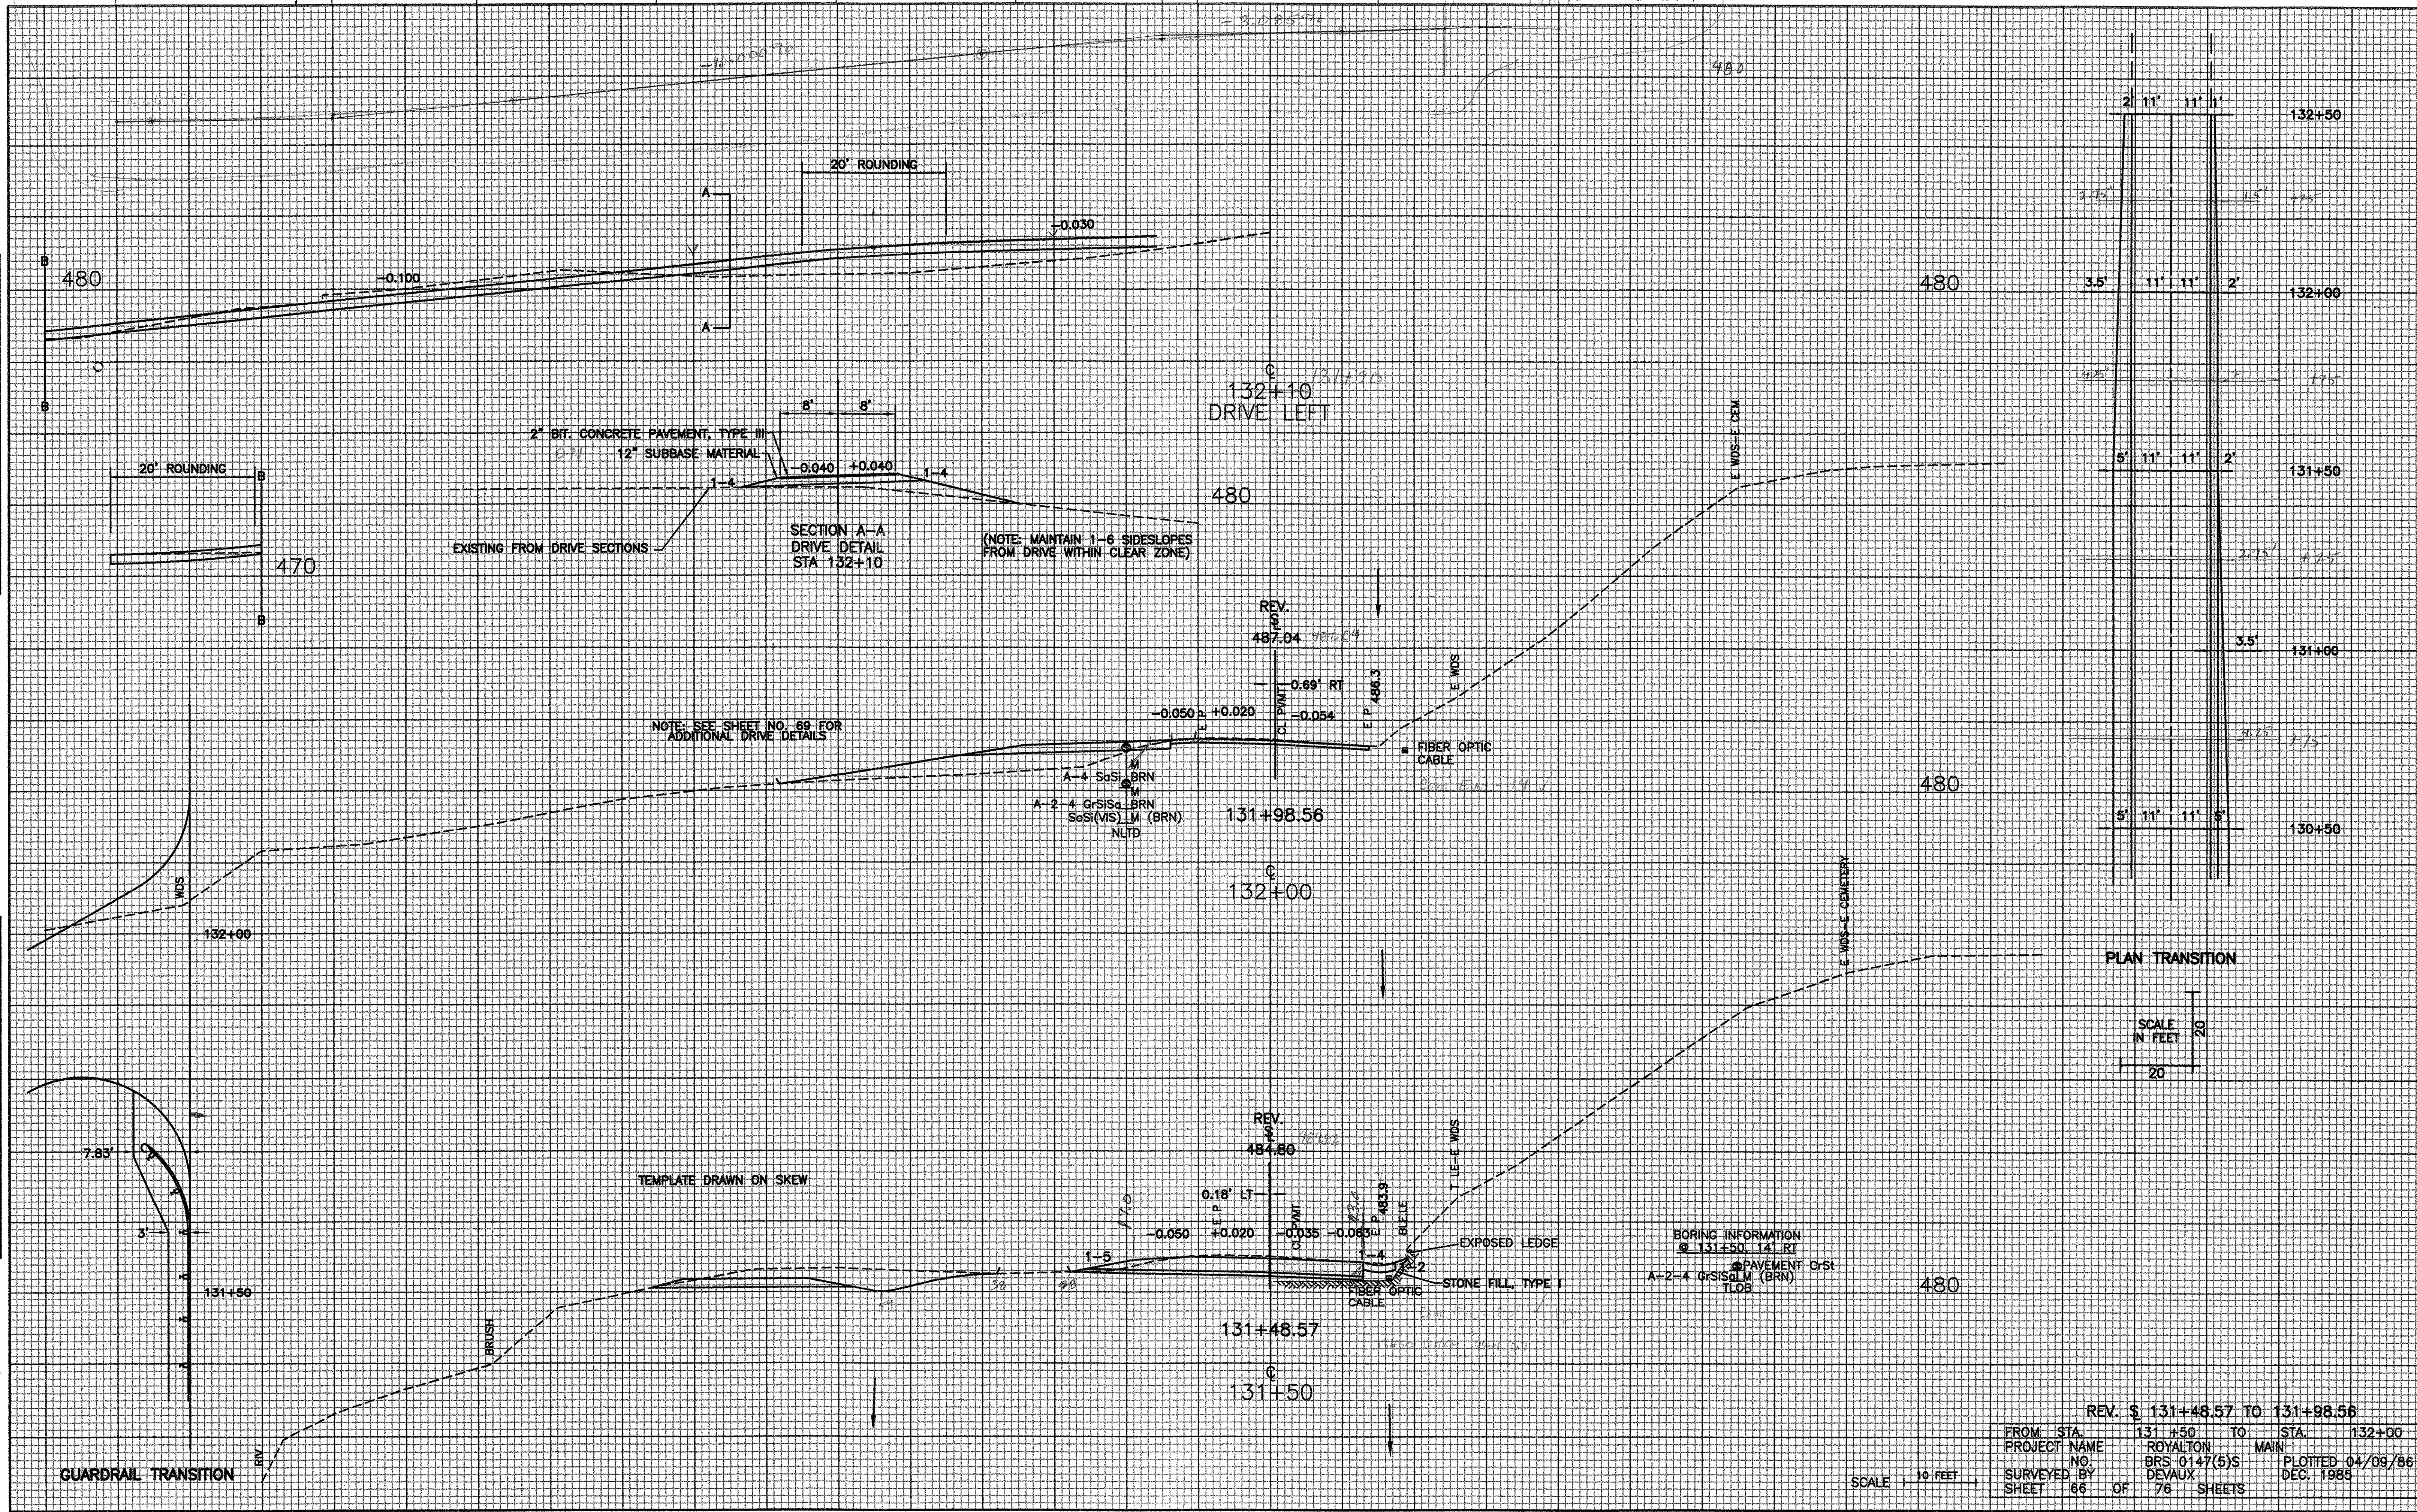

| | | | |
|--------------|--------------|---------|-----------|
| REV. \$ | 131+48.57 | TO | 131+98.56 |
| FROM STA. | 131+50 | TO STA. | 132+00 |
| PROJECT NAME | ROYALTON | MAIN | |
| NO. | BRS 0147(5)S | PLOTTED | 04/09/86 |
| SURVEYED BY | DEVAUX | DEC. | 1985 |
| SHEET | 66 | OF | 76 SHEETS |

SCALE 1" = 20 FEET

131+50 487.65