


FINAL SURVEY	DATE
REVISIONS	BY
NO.	

ORIGINAL SURVEY	DATE
REVISIONS	BY
NO.	

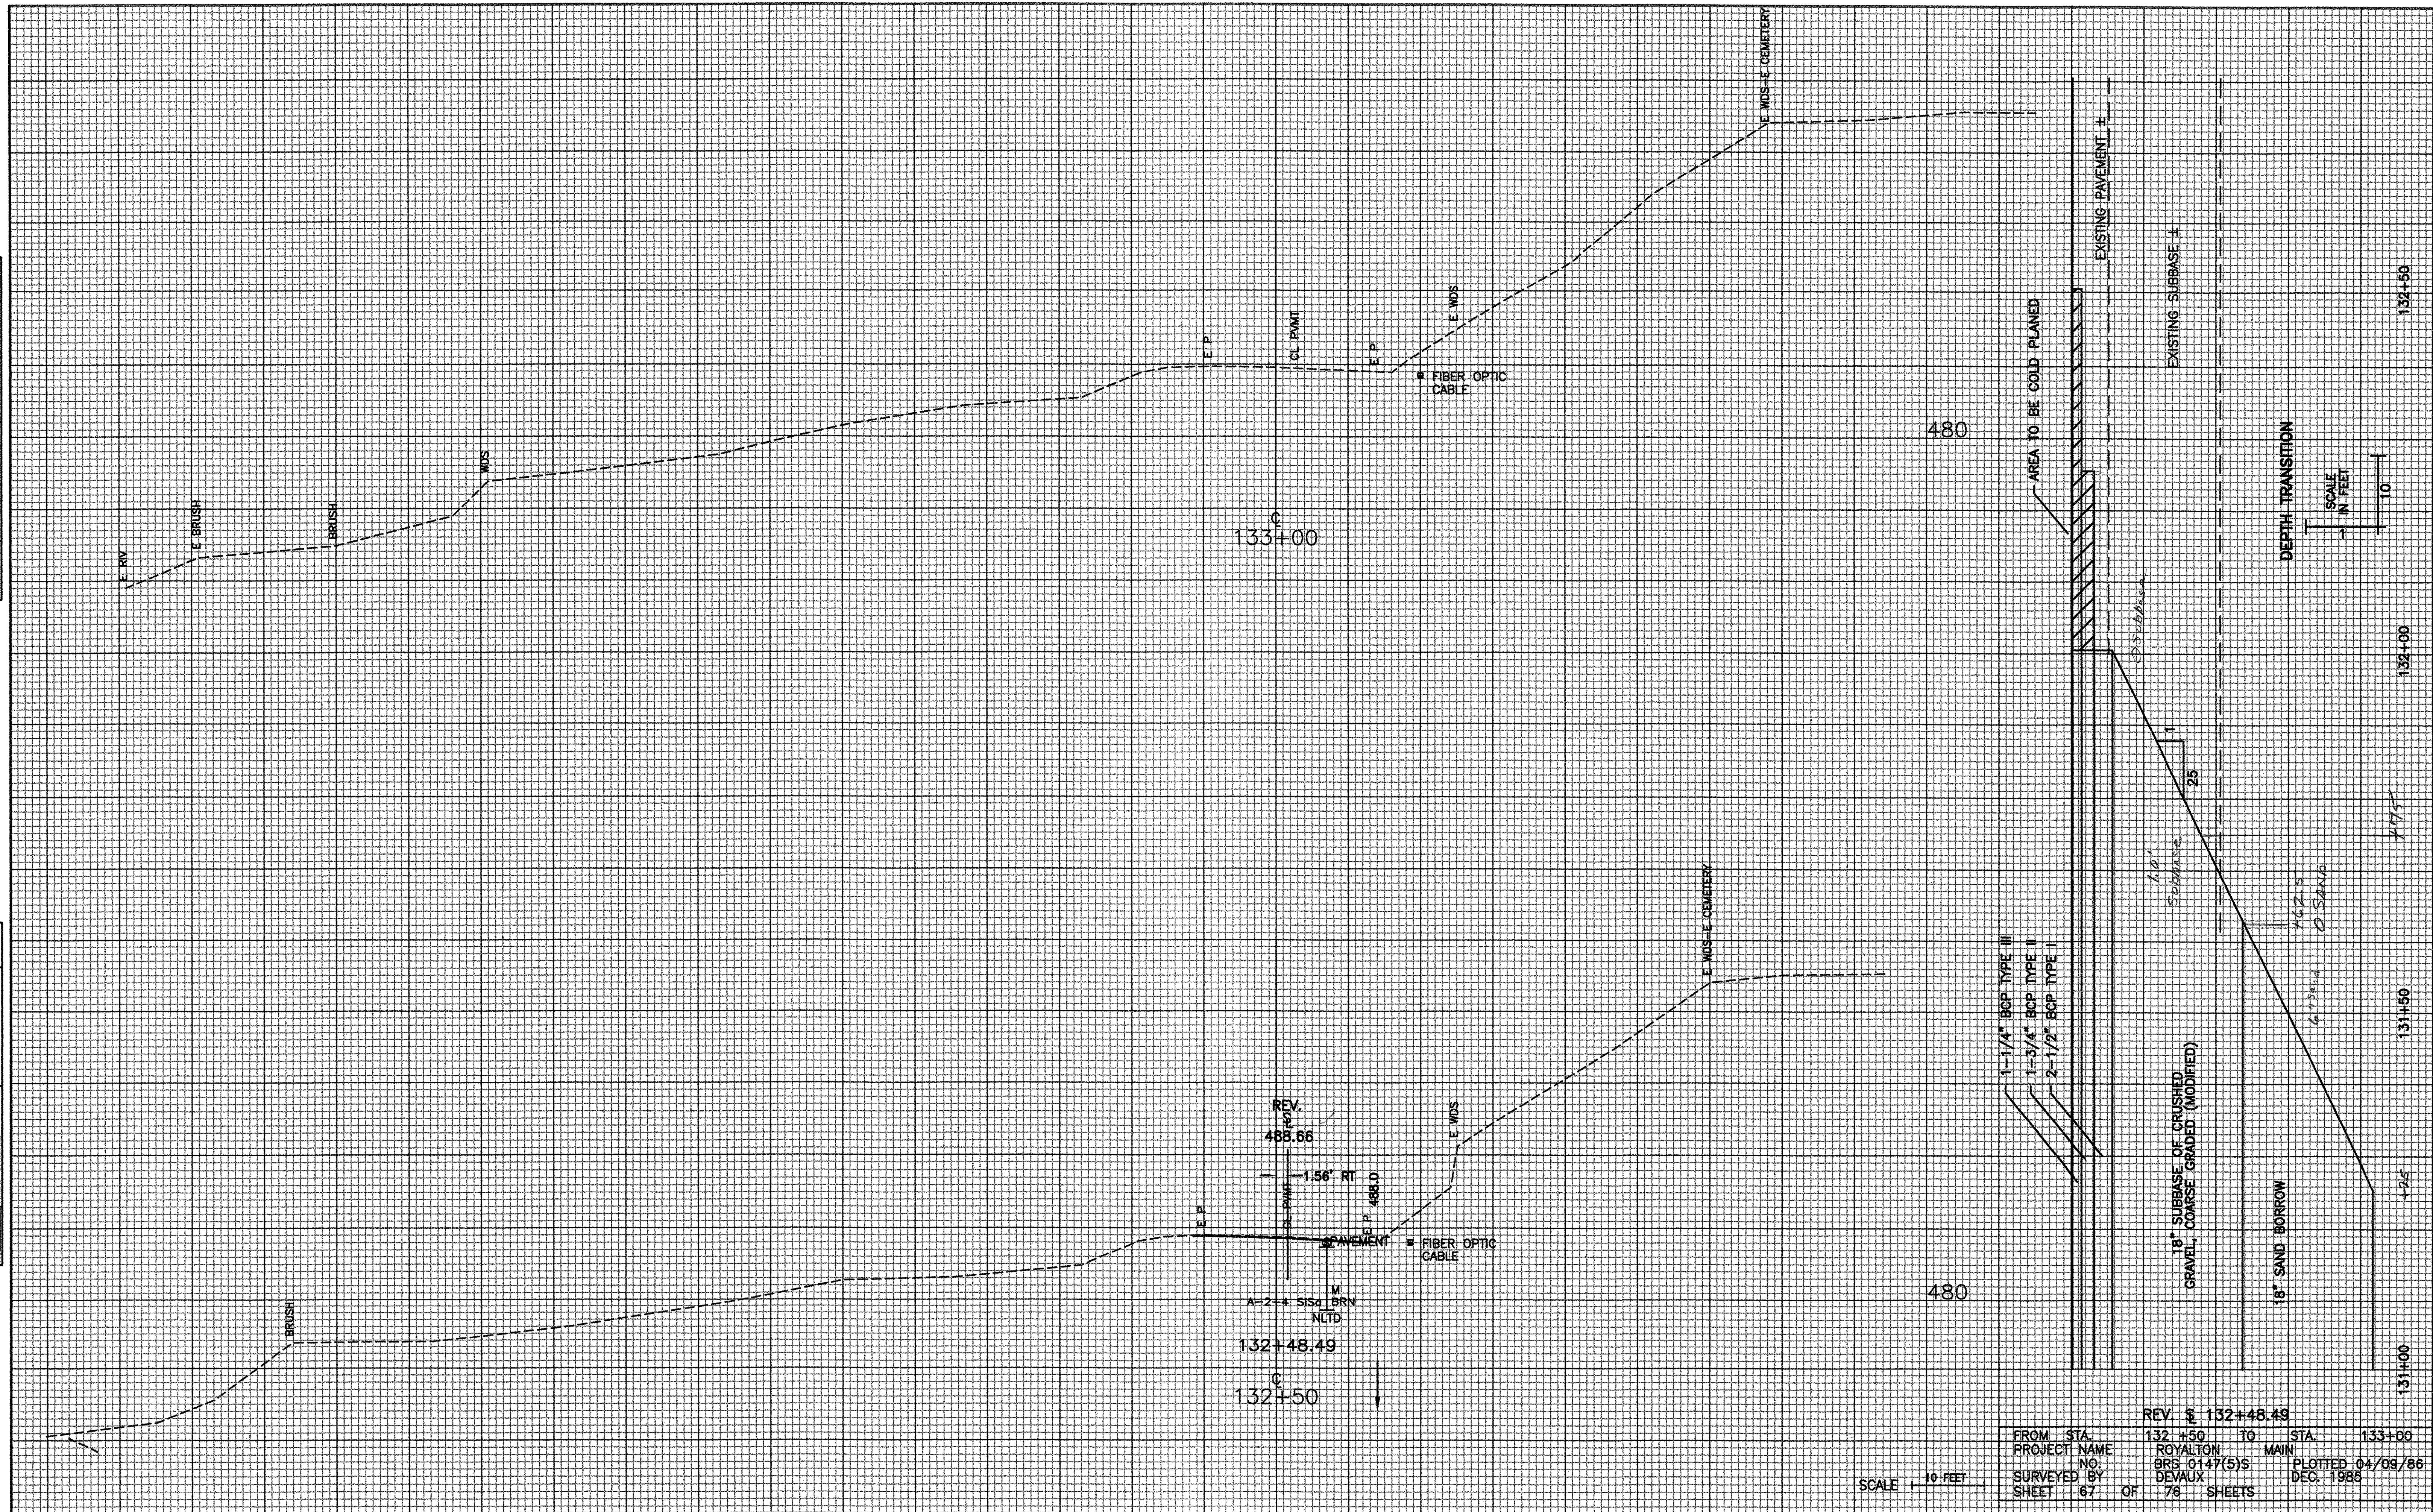

SCALE 10 FEET

REV. §	132+48.49		
FROM STA.	132+50	TO STA.	133+00
PROJECT NAME	ROYALTON MAIN	NO.	BRS 0147(5)S
SURVEYED BY	DEVAUX	PLOTTED	04/09/86
SHEET	67	OF	76 SHEETS

