


DATE	
BY	
FINAL SURVEY	
SURVEYED	
PLOTTED	
TEMP. PLATE	
NOTEBOOK	
AREAS CHECKED	
NO.	

DATE	
BY	
ORIGINAL SURVEY	
SURVEYED	
PLOTTED	
TEMP. PLATE	
NOTEBOOK	
AREAS CHECKED	
NO.	

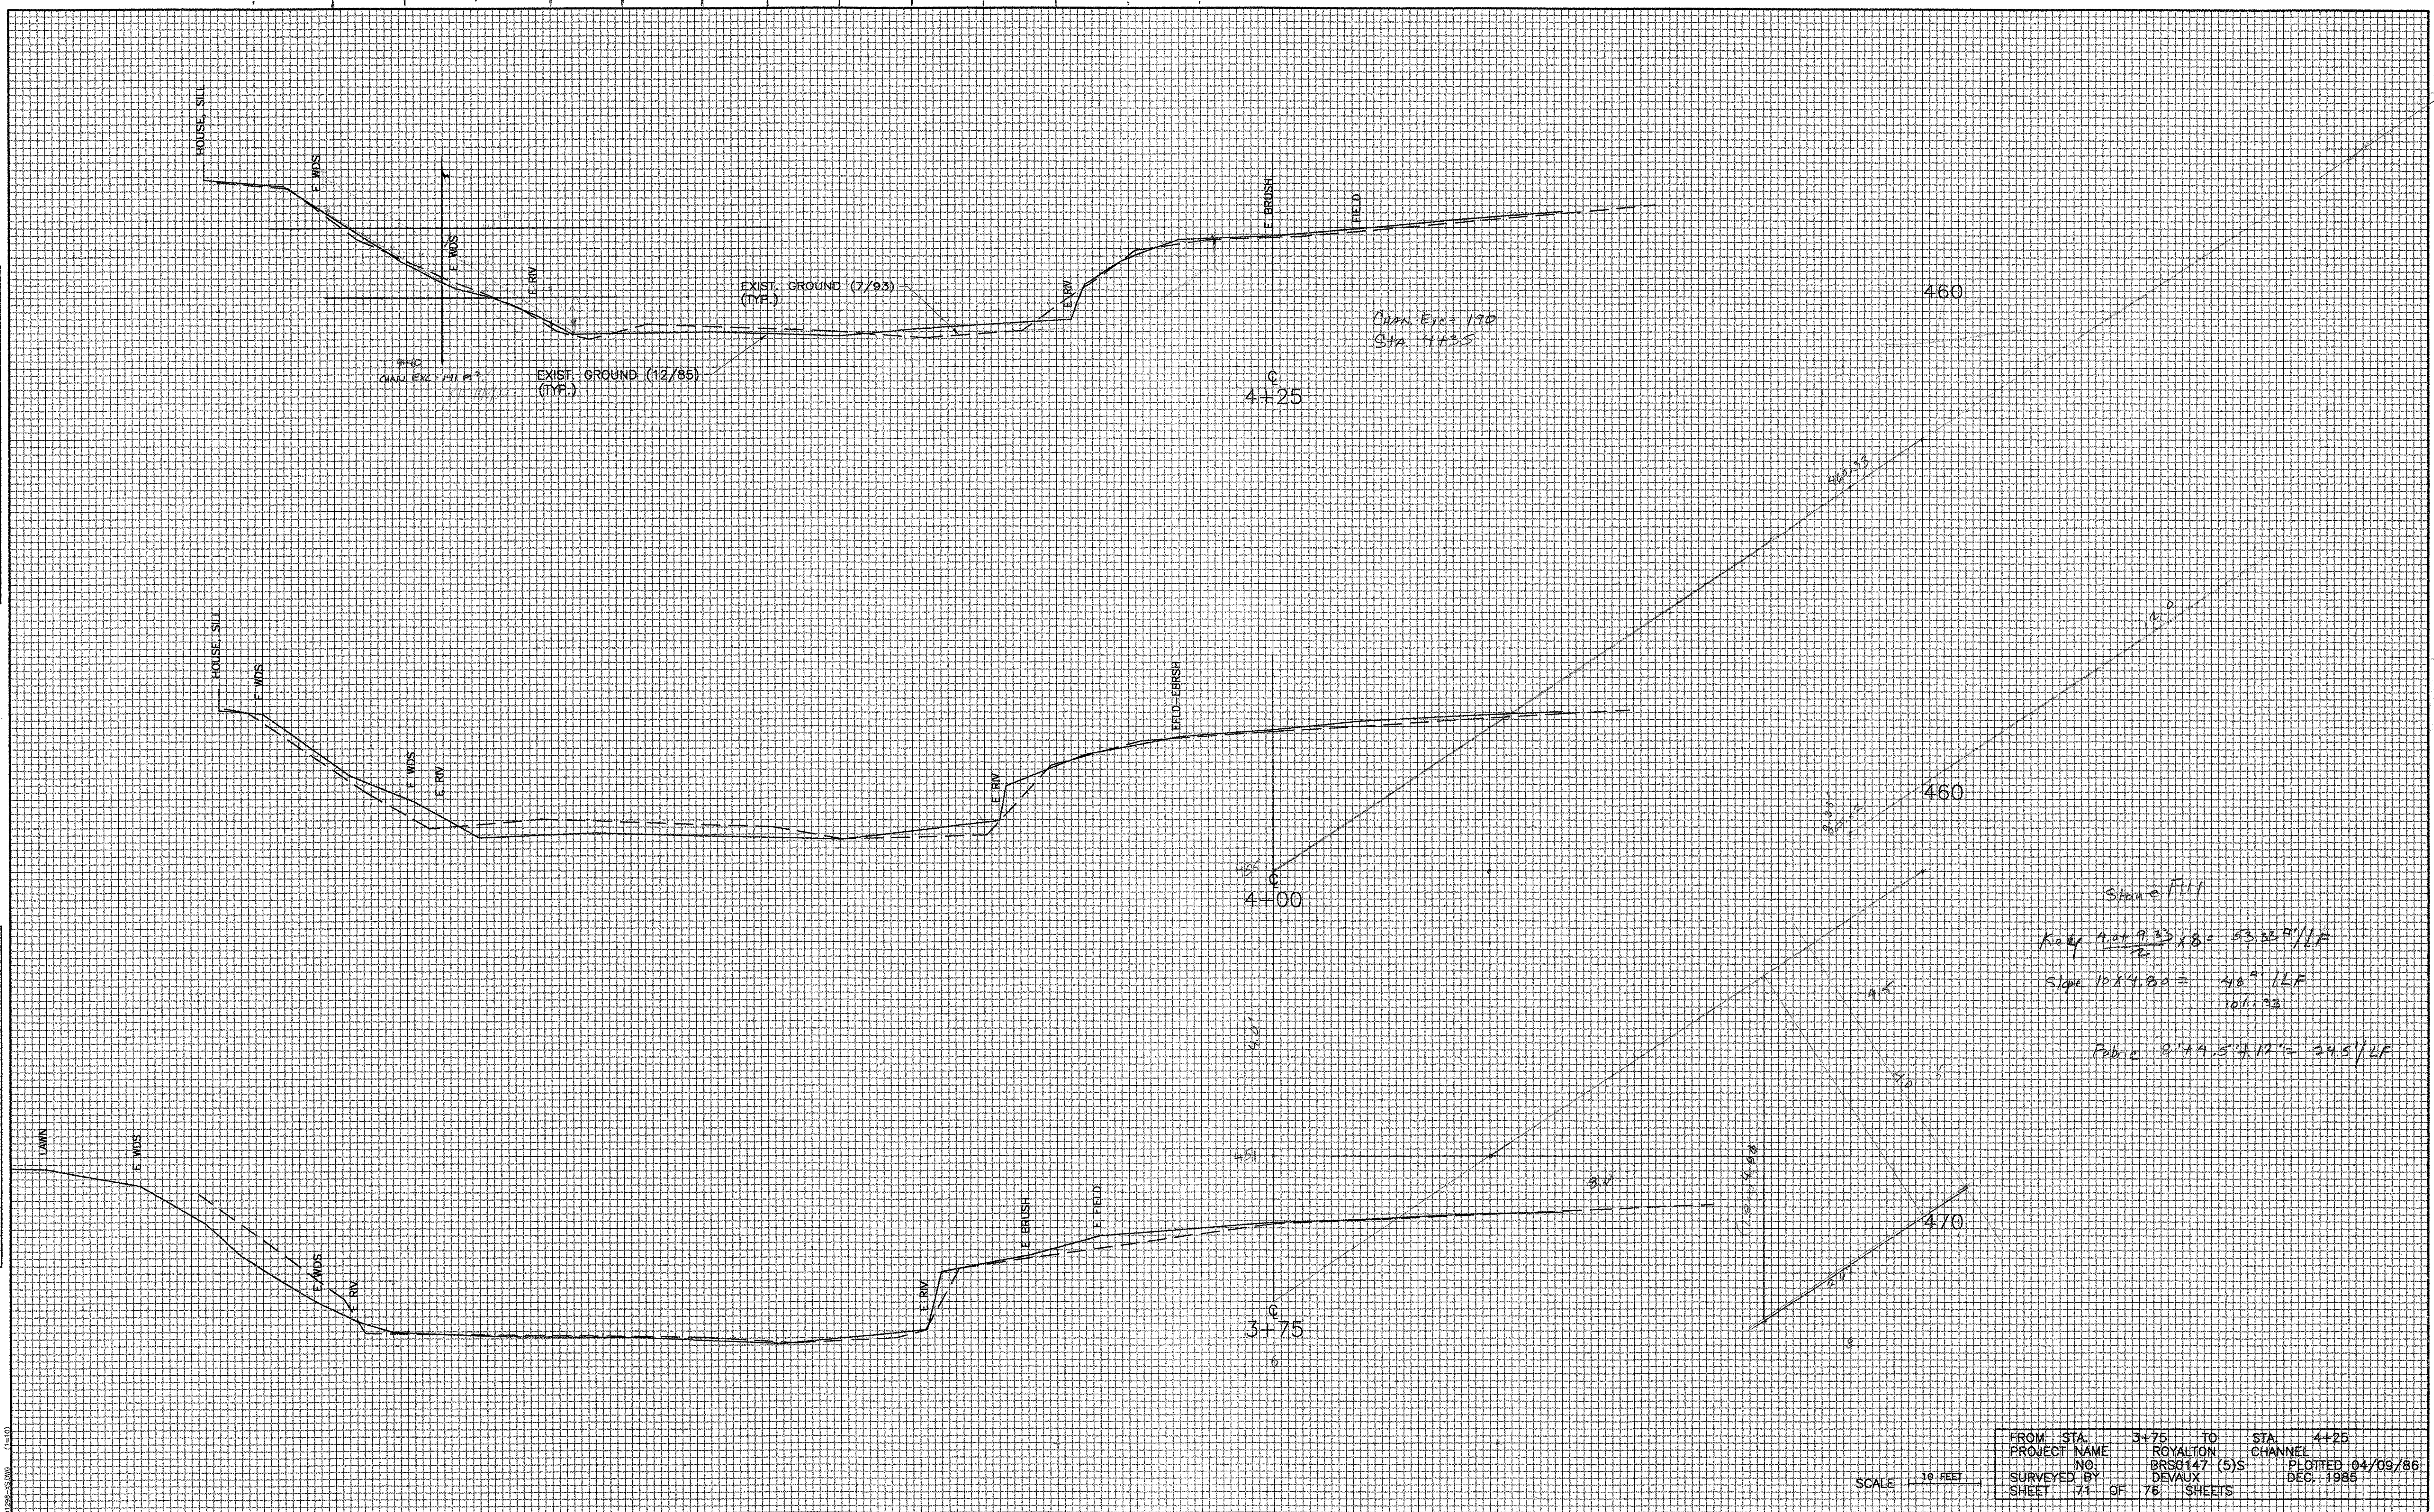

FROM STA.	3+75	TO STA.	4+25
PROJECT NAME	ROYALTON	CHANNEL	
NO.	BR50147 (5)S	PLOTTED	04/09/66
SURVEYED BY	DEVAUX	DEC.	1985
SHEET	71	OF	76 SHEETS