


DATE	
BY	
FINAL SURVEY	
NOTED	
FLUENT	
TEMPLATE	
AREAS	
CHECKED	
NO.	

DATE	
BY	
ORIGINAL SURVEY	
NOTED	
FLUENT	
TEMPLATE	
AREAS	
CHECKED	
NO.	

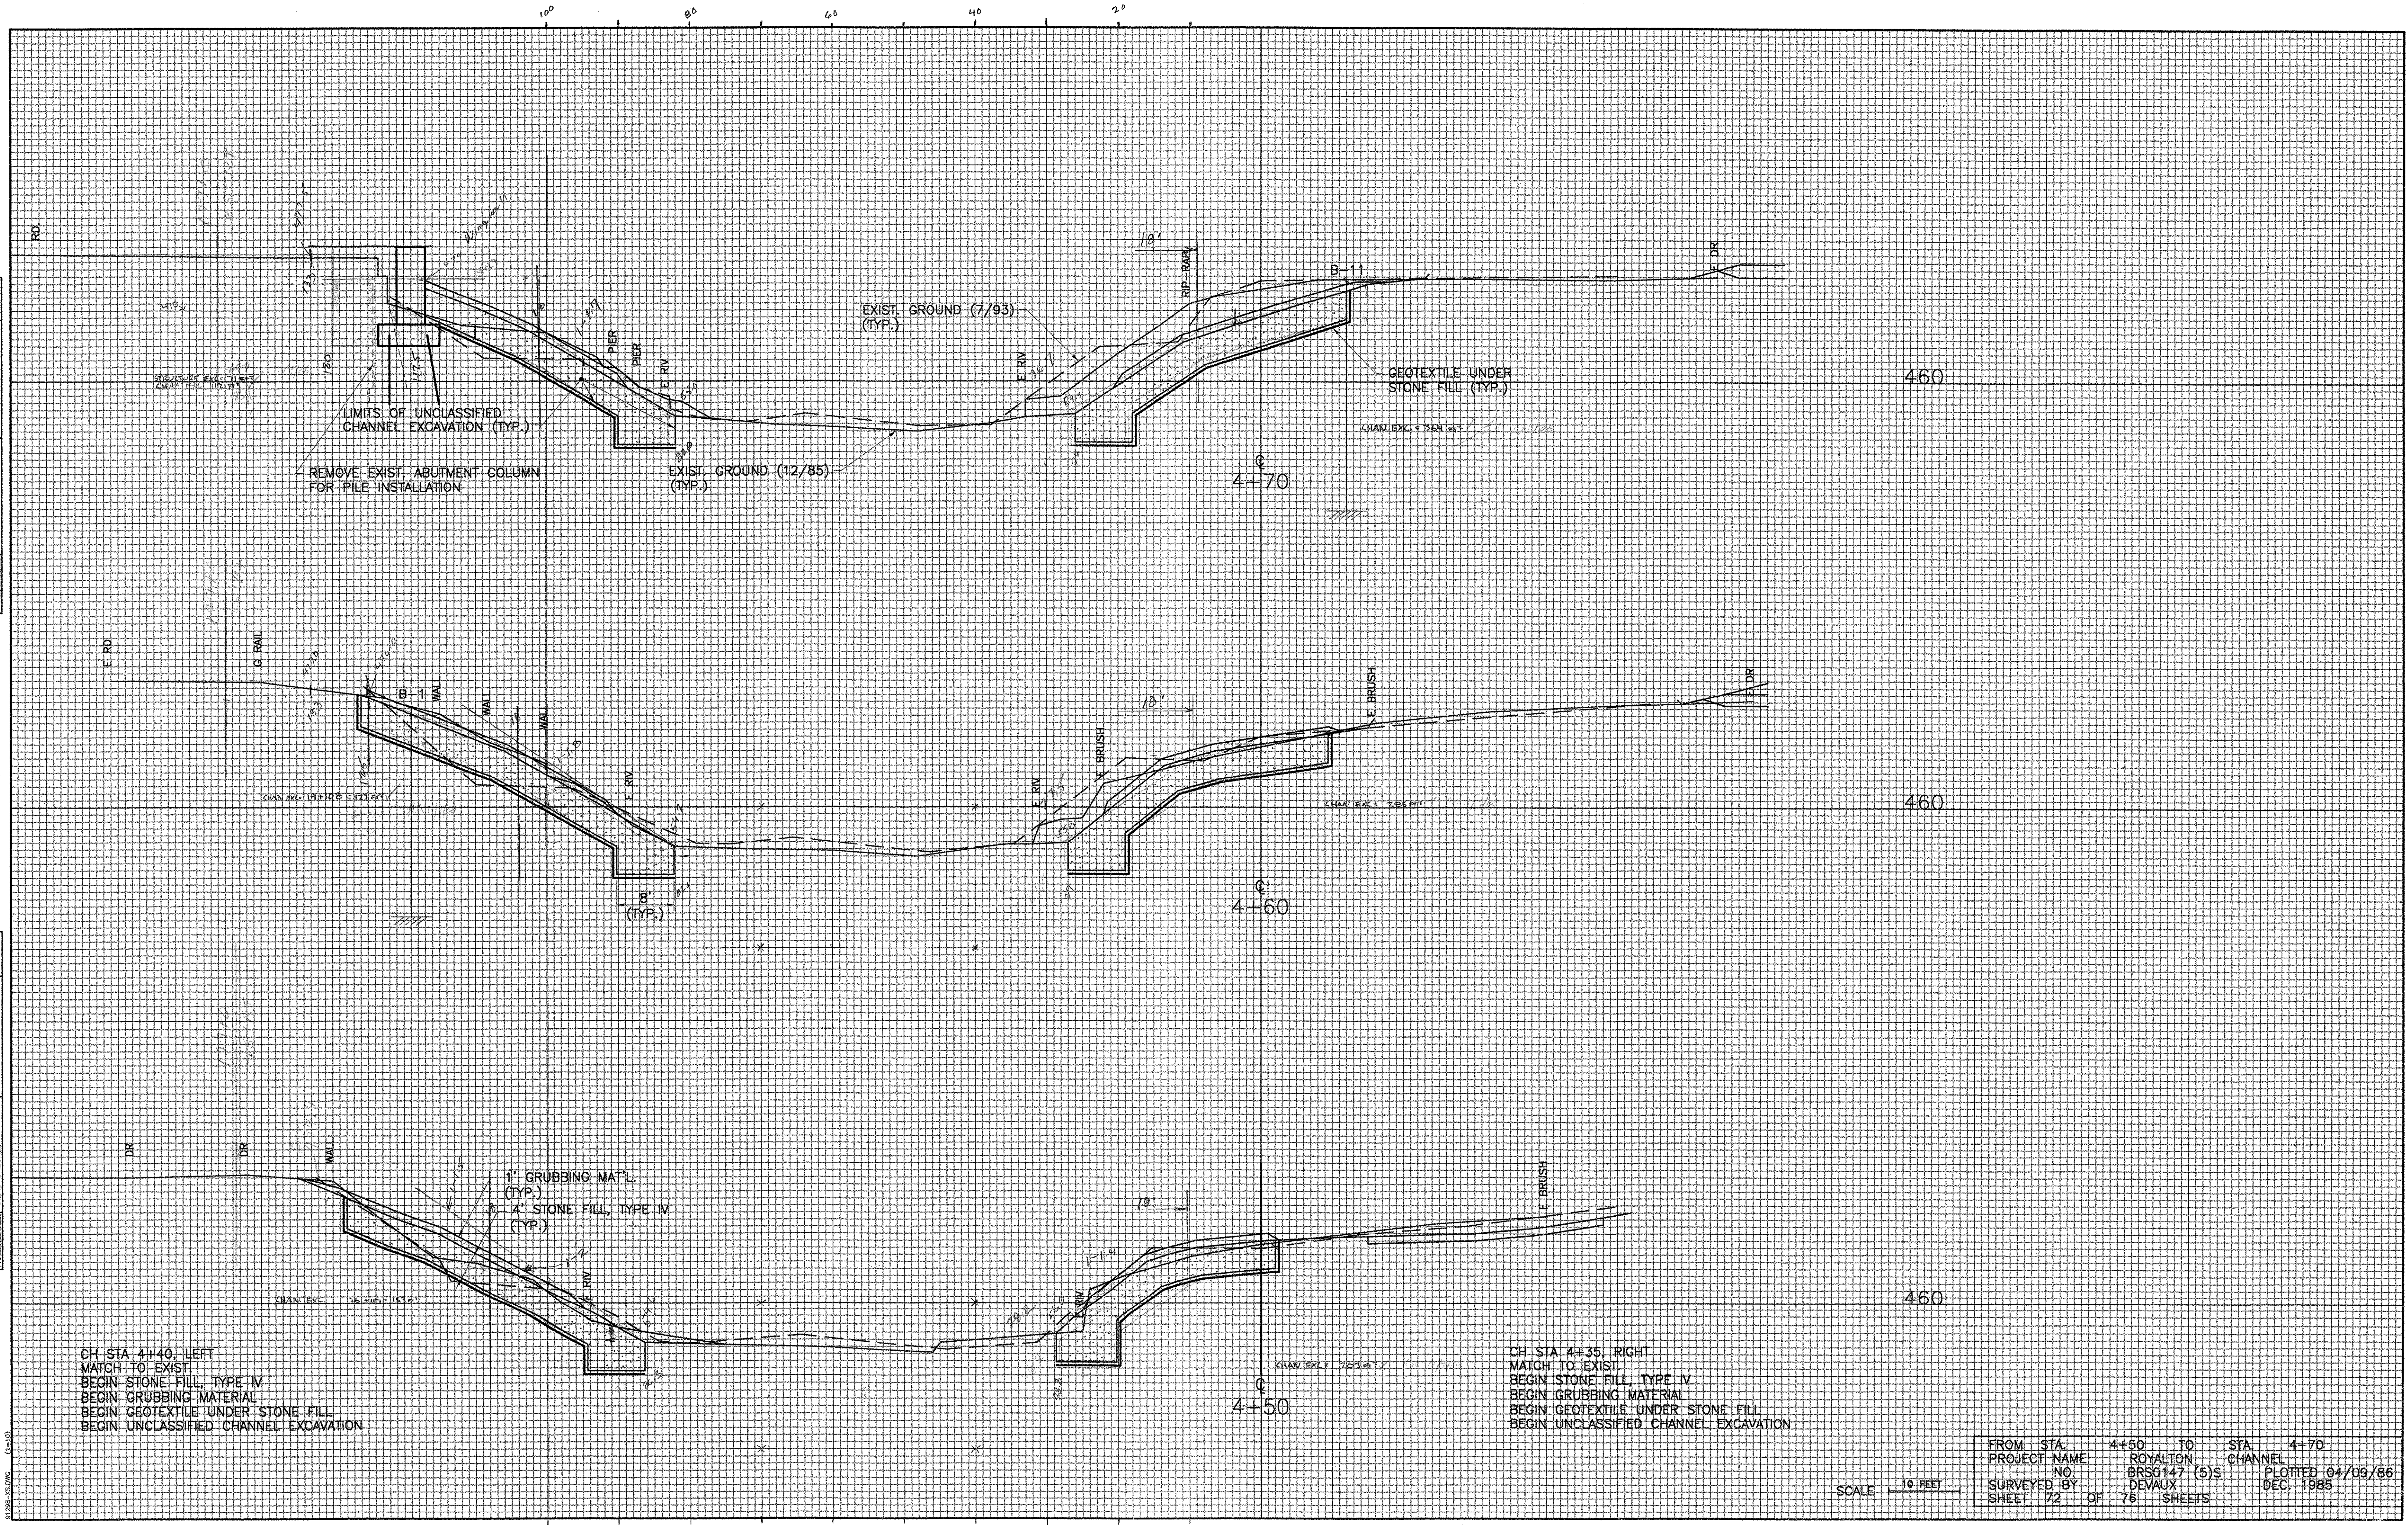

CH STA 4+40, LEFT
MATCH TO EXIST.
BEGIN STONE FILL, TYPE IV
BEGIN GRUBBING MATERIAL
BEGIN GEOTEXTILE UNDER STONE FILL
BEGIN UNCLASSIFIED CHANNEL EXCAVATION

CH STA 4+35, RIGHT
MATCH TO EXIST.
BEGIN STONE FILL, TYPE IV
BEGIN GRUBBING MATERIAL
BEGIN GEOTEXTILE UNDER STONE FILL
BEGIN UNCLASSIFIED CHANNEL EXCAVATION

FROM STA.	4+50	TO STA.	4+70
PROJECT NAME	ROYALTON CHANNEL		
NO.	BRSG 147 (5)S	PLOTTED	04/09/86
SURVEYED BY	DEVAUX	DEC.	1985
SHEET	72	OF	76 SHEETS

SCALE 1" = 10 FEET