


FINAL SURVEY  
 DATE: 10/15/10  
 BY: [Signature]

PERSONAL SURVEY  
 DATE: 10/15/10  
 BY: [Signature]

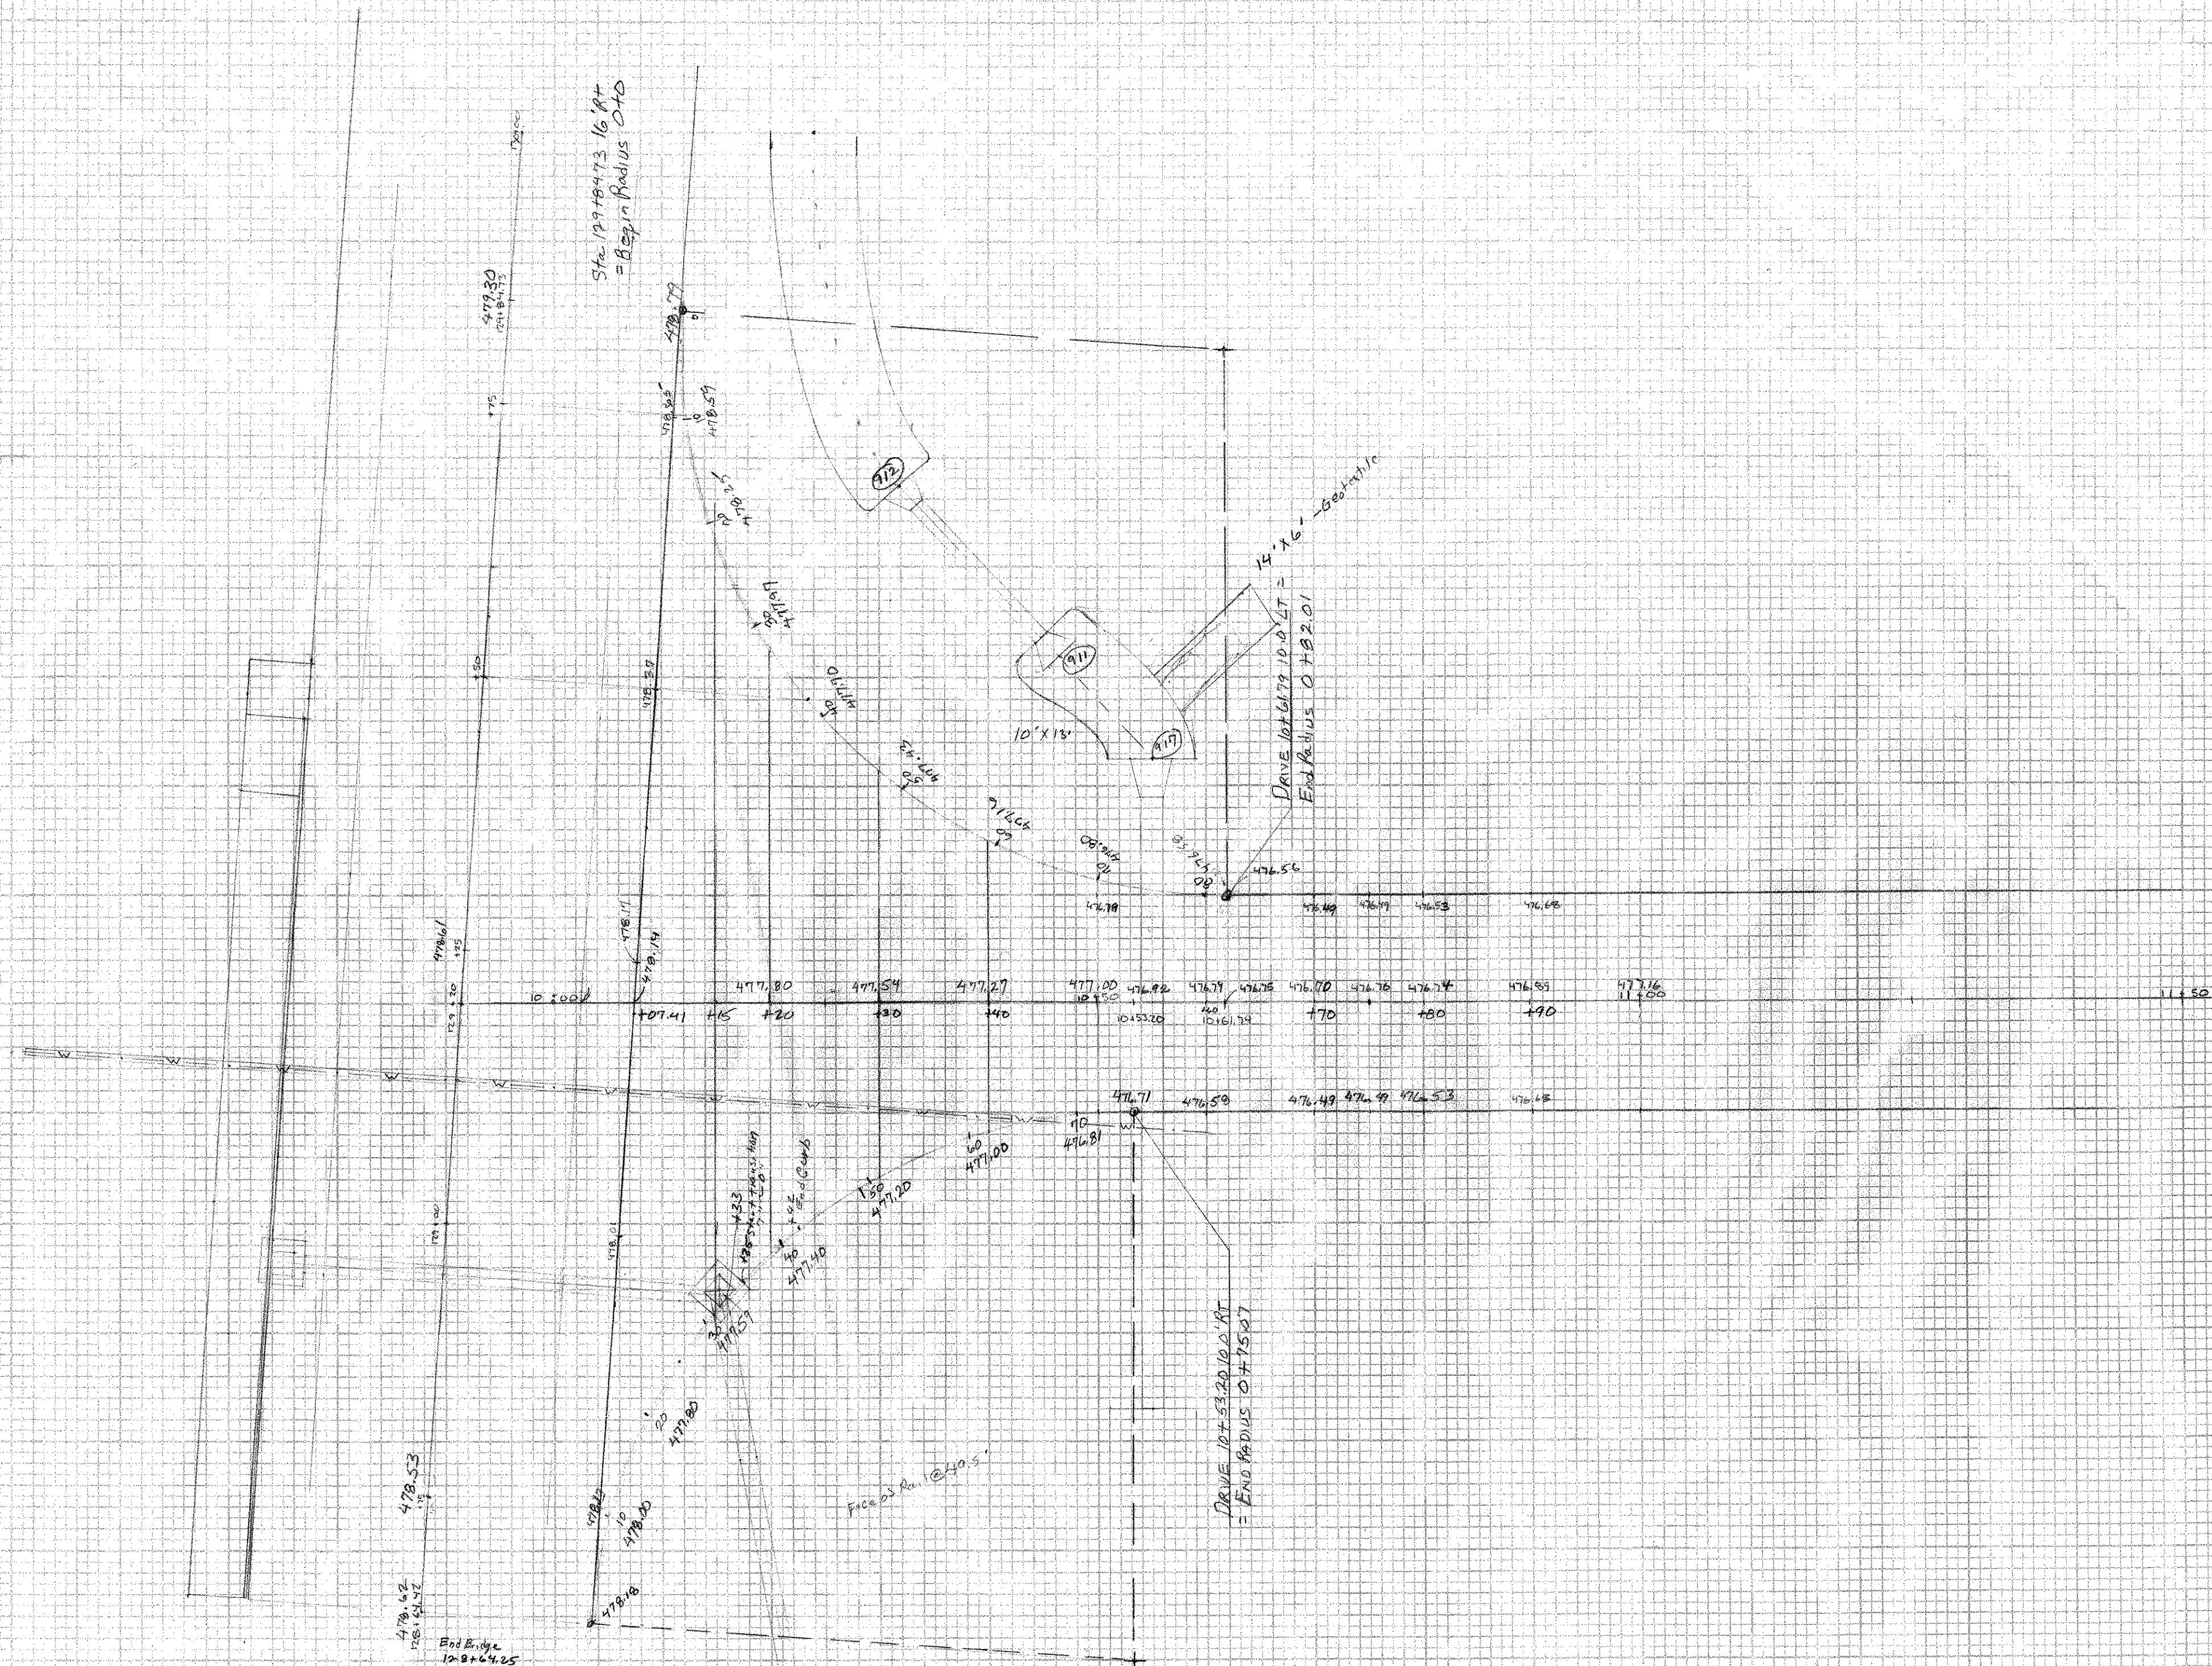

SCALE: 1:10

ROYALTON  
 AC BRS 0147655  
 CRAWFORD DRIVE SHEET