

INDEX OF SHEETS
SEE SHEET 2

STATE OF VERMONT AGENCY OF TRANSPORTATION




PROPOSED IMPROVEMENT BRIDGE PROJECT TOWN OF STOCKBRIDGE COUNTY OF WINDSOR VT. ROUTE 100 (MINOR ARTERIAL)

BEGINNING IN STOCKBRIDGE AT A POINT 2.577 MILES NORTHERLY OF THE PITTSFIELD - STOCKBRIDGE TOWNLINE AND EXTENDING NORTHERLY ALONG VT ROUTE 100 FOR A DISTANCE OF 0.223 MILES TO MILEMARKER 2.780.

LENGTH OF ROADWAY 950.00 FEET = 0.180 MILES
LENGTH OF BRIDGE 225.00 FEET = 0.043 MILES
LENGTH OF PROJECT 1175.00 FEET = 0.223 MILES

WORK TO BE PERFORMED UNDER THIS PROJECT IS THE REPLACEMENT OF BRIDGE #130, ON A NEW ALIGNMENT, WITH ASSOCIATED ROADWAY AND APPROACHES.

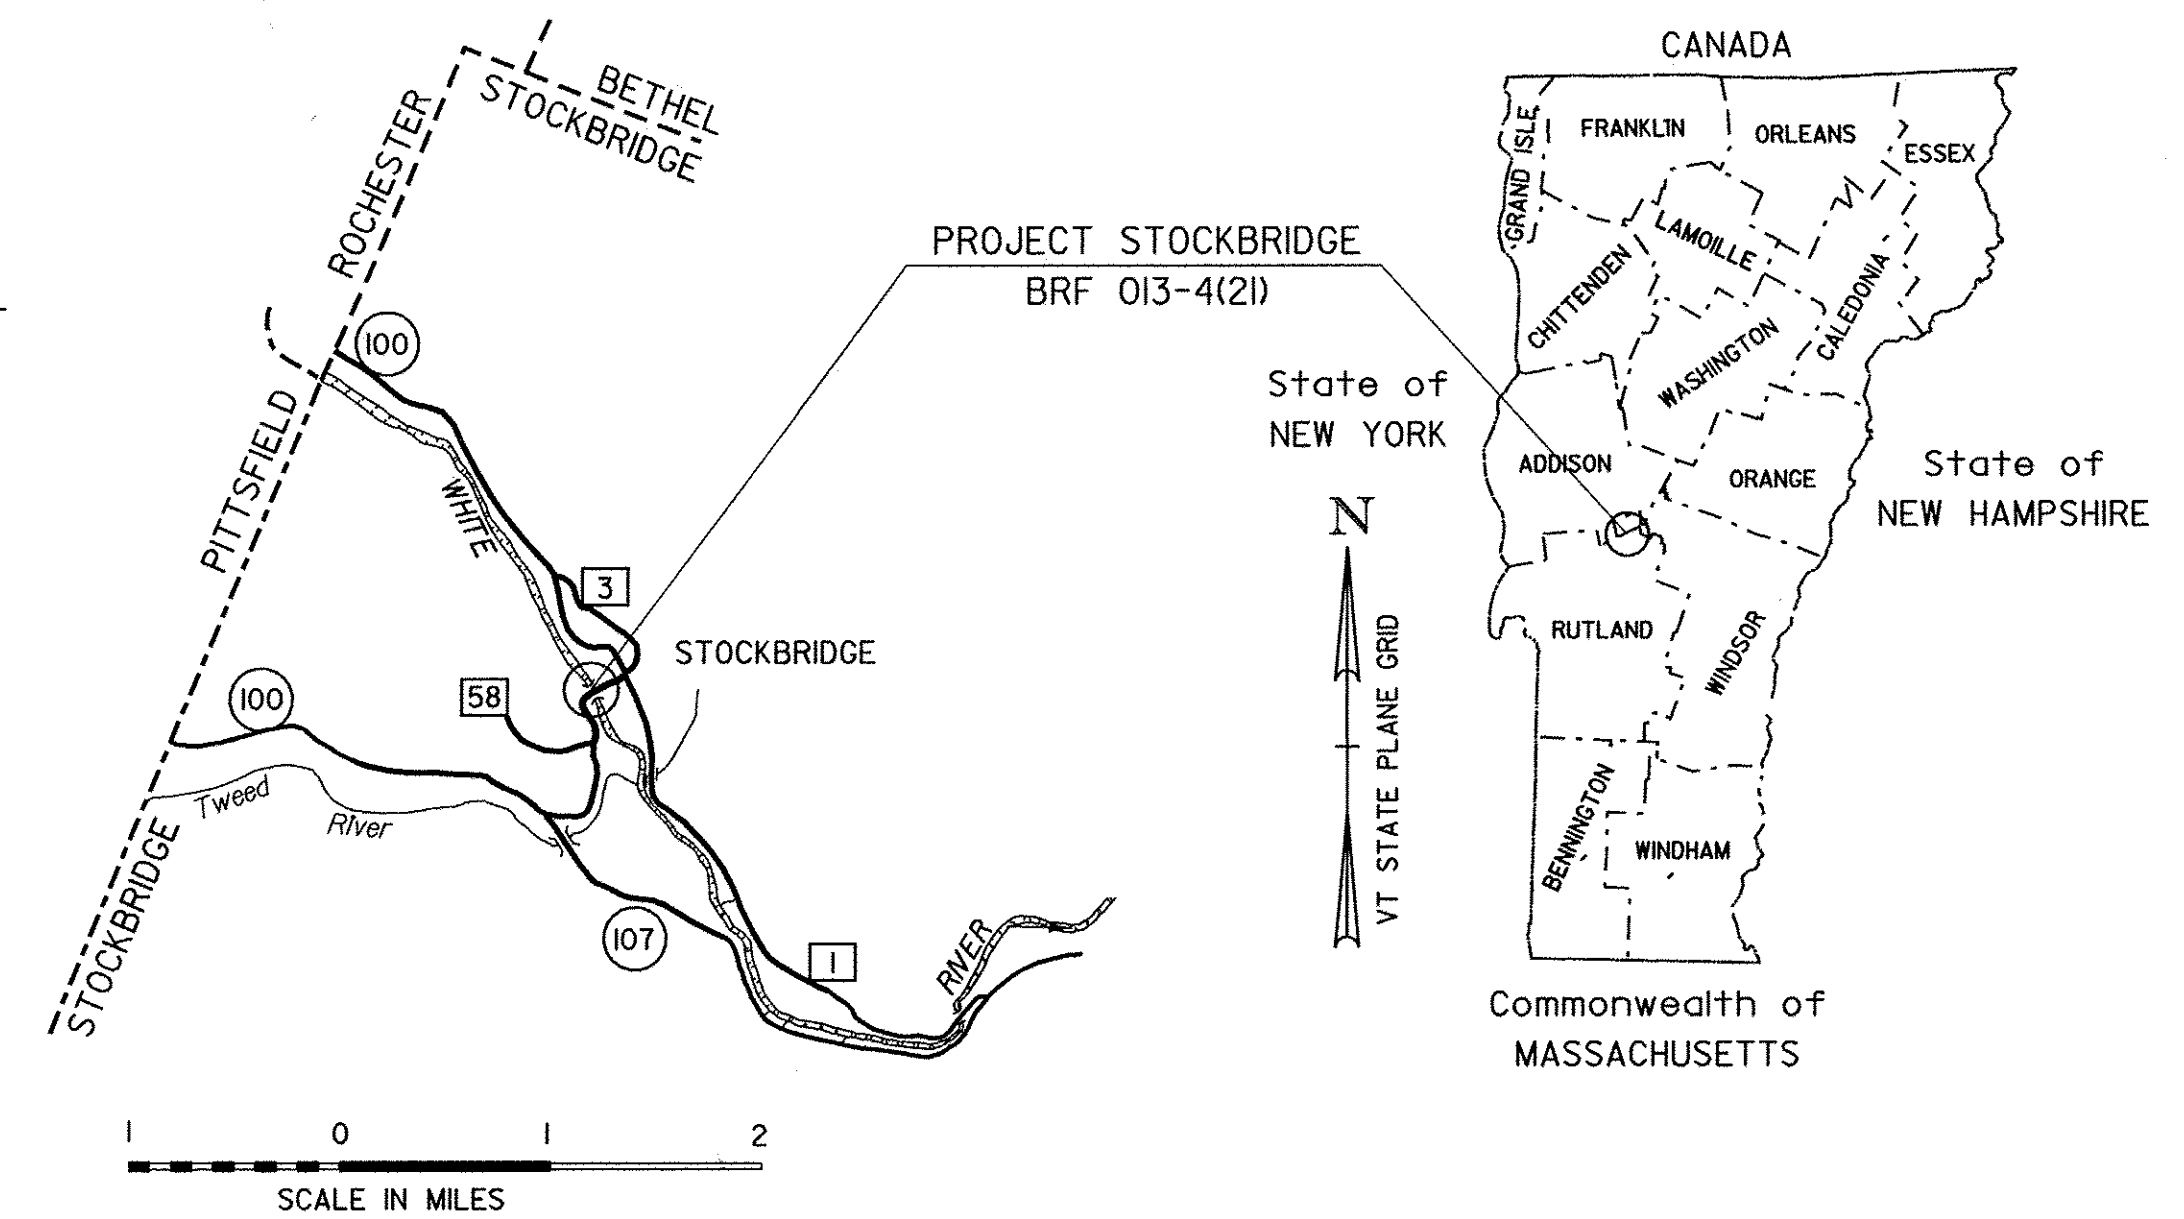

RECORD PLANS	
CONTRACTOR:	WINTERSSET, INC. - LYNDONVILLE, VT
RESIDENT ENGINEER:	DARYL BASSETT
CONSTRUCTION BEGAN:	JULY 28, 2008
CONSTRUCTION COMPLETE:	JUNE 18, 2010
RECORD PLANS BY:	DARYL BASSETT & AMOS KEMPTON
I HEREBY CERTIFY THAT ALL THE CONSTRUCTION REQUIRED BY THIS SET OF DRAWINGS HAS BEEN ACCOMPLISHED AS INDICATED HEREIN.	
BY <u>Daryl Bassett</u>	RESIDENT ENGINEER
DATE <u>4/18/12</u>	
NOTE: Any further information concerning final quantities, amounts or other details relative to this project may be found at Central Files in the electronic archives.	

VT. ROUTE 100
TO JUNCTION'S
VT 100 & VT 107

**135+00
BEGIN PROJECT**

**141+37.50
STOP ROADWAY
BEGIN BRIDGE**

**143+62.50
END BRIDGE
RESUME ROADWAY**

**146+75
END PROJECT**

CONVENTIONAL SYMBOLS

COUNTY LINE	
TOWN LINE	
LIMITS OF ACCESS	
POINT OF ACCESS	
FENCE LINE	
STONE WALL	
TRAVELED WAY	
GUARD RAIL	
RAILROAD	
SURVEY LINE	
CULVERT	
POWER POLE	
TELEPHONE POLE	
TREES	
CONTROL OF ACCESS	
PROPERTY LINE	
R.O.W. TAKING LINE	
SLOPE RIGHTS	
TOP OF CUT	
TOE OF SLOPE	

SURVEYED BY : MOREAU
SURVEYED DATE : FEB 1991

DATUM
VERTICAL NGVD 1929
HORIZONTAL ASSUMED

0 200 400
SCALE IN FEET

THESE PLANS ARE SUBJECT TO SUCH ENGINEERING CHANGES AS MAY BE REQUIRED BY THE FEDERAL HIGHWAY ADMINISTRATION OR THE DIRECTOR OF PROGRAM DEVELOPMENT.
CONSTRUCTION IS TO BE CARRIED ON IN ACCORDANCE WITH THESE PLANS AND THE STANDARD SPECIFICATIONS FOR CONSTRUCTION DATED 2006, AS APPROVED BY THE FEDERAL HIGHWAY ADMINISTRATION ON JUNE 15, 2006 FOR USE ON THIS PROJECT, INCLUDING ALL SUBSEQUENT REVISIONS AND SUCH REVISED SPECIFICATIONS AND SPECIAL PROVISIONS AS ARE INCORPORATED IN THESE PLANS.
78f238\str5\sf238bdr.dgn

DIRECTOR OF PROGRAM DEVELOPMENT
APPROVED Richard J. Stewart DATE 2-5-08
PROJECT MANAGER : **KRISTIN HIGGINS**
PROJECT NAME : **STOCKBRIDGE**
PROJECT NUMBER : **(STP) BR 013-4(21)**
SHEET 1 OF 144 SHEETS

05-FEB-2008