


TIMBER HAWK ROAD - TH#58

- 3" SUPERPAVE BITUMINOUS CONCRETE PAVEMENT (PG 58-34) (1 1/2" TYPE IVS OVER 1 1/2" TYPE IVS) OR
- 3" AGGREGATE SURFACE COURSE
- 18" SUBBASE OF DENSE GRADED CRUSHED STONE
- 24" SAND BORROW


MATERIAL ITEM	THICKNESS TOLERANCE
PAVEMENT (TOTAL DEPTH)	+/- 1/4"
SUBBASE	+/- 1"
SAND BORROW	+/- 1"
AGGREGATE SURFACE COURSE	+/- 1/2"

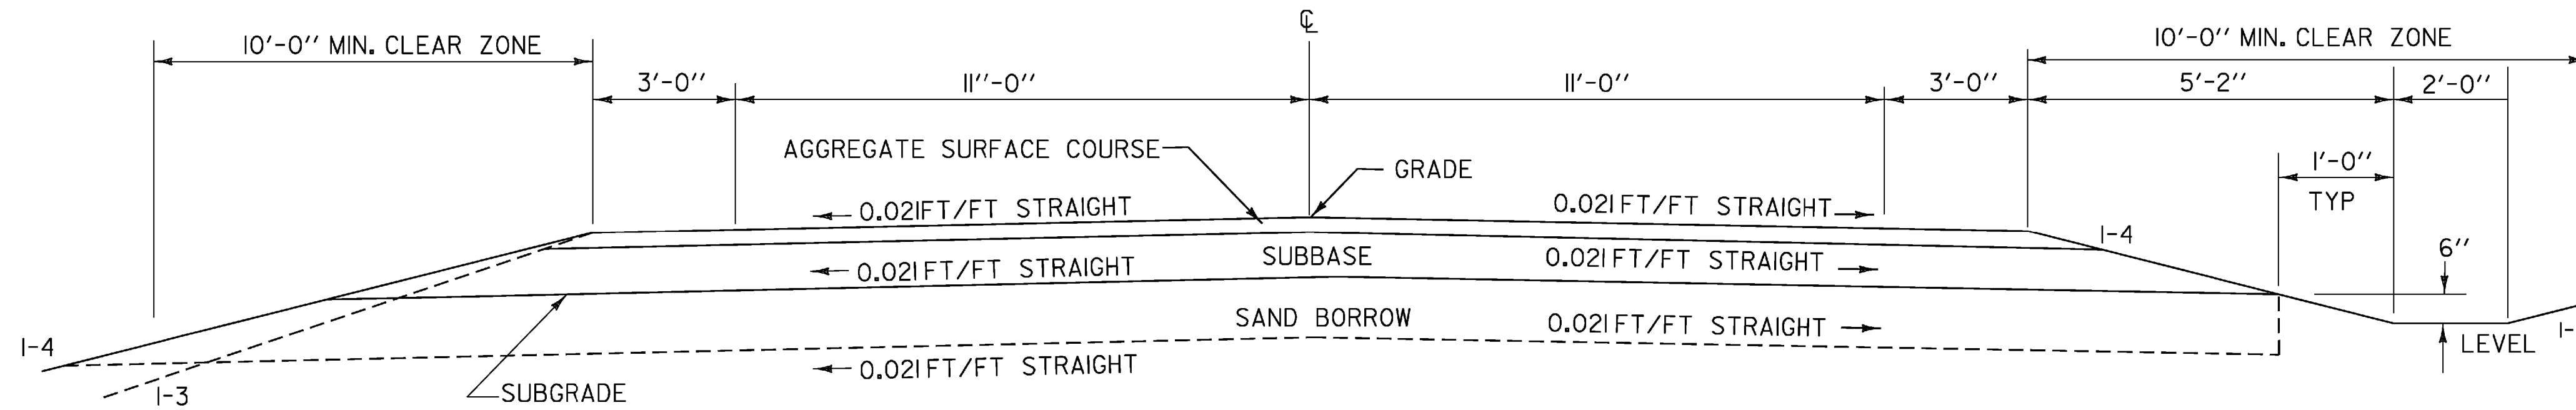


NORMAL SECTION
(NOT TO SCALE)

TIMBER RIVER ROAD SECTION

- 3" SUPERPAVE BITUMINOUS CONCRETE PAVEMENT (PG 58-34) (1 1/2" TYPE IVS OVER 1 1/2" TYPE IVS) OR
- 3" AGGREGATE SURFACE COURSE
- 18" SUBBASE OF DENSE GRADED CRUSHED STONE
- 24" SAND BORROW
- SHOULDERS SAME AS ROADWAY

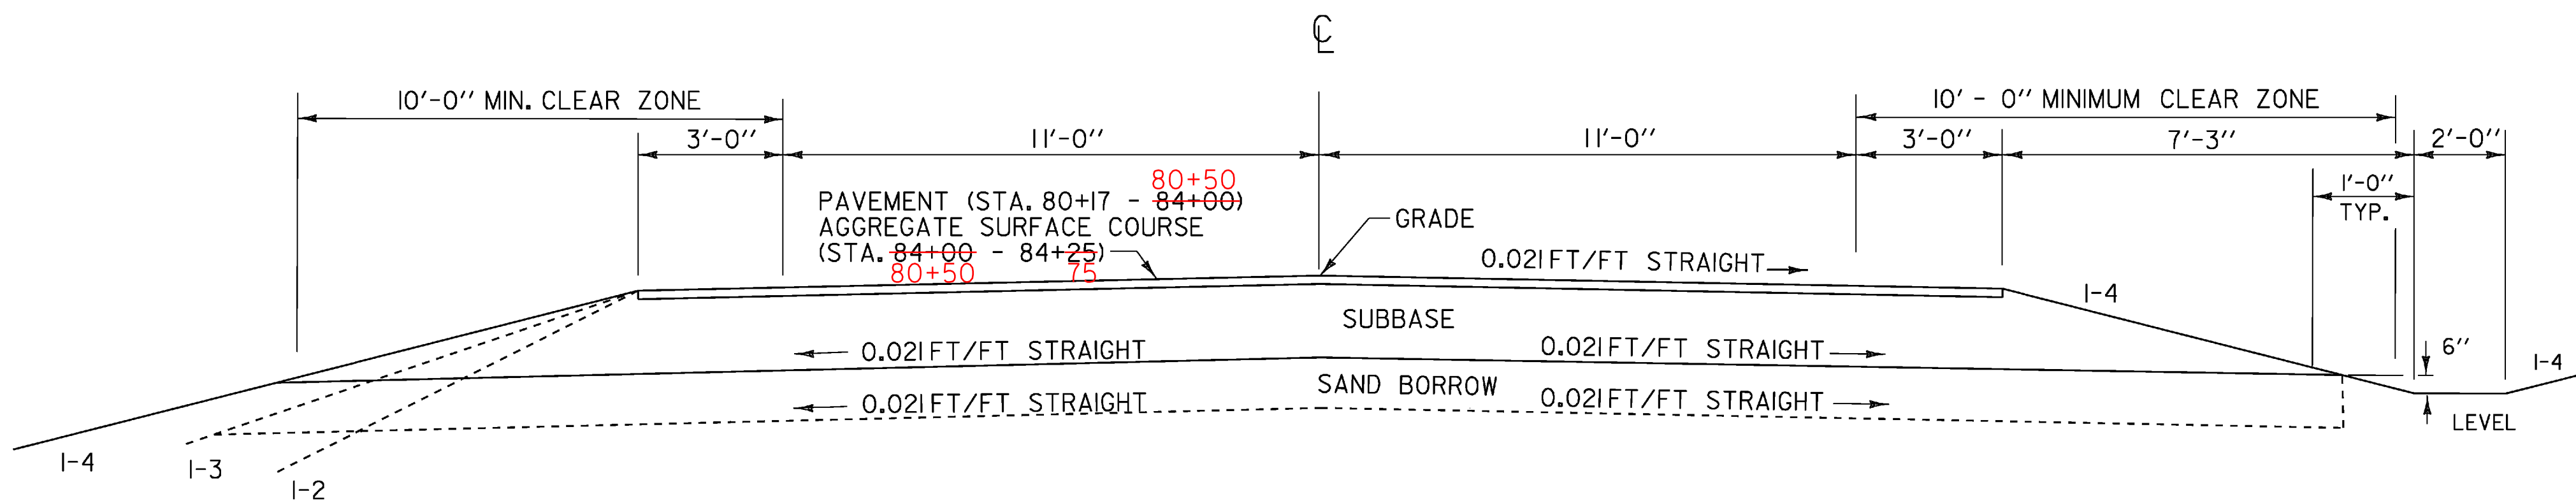

NORMAL SECTION
(NOT TO SCALE)

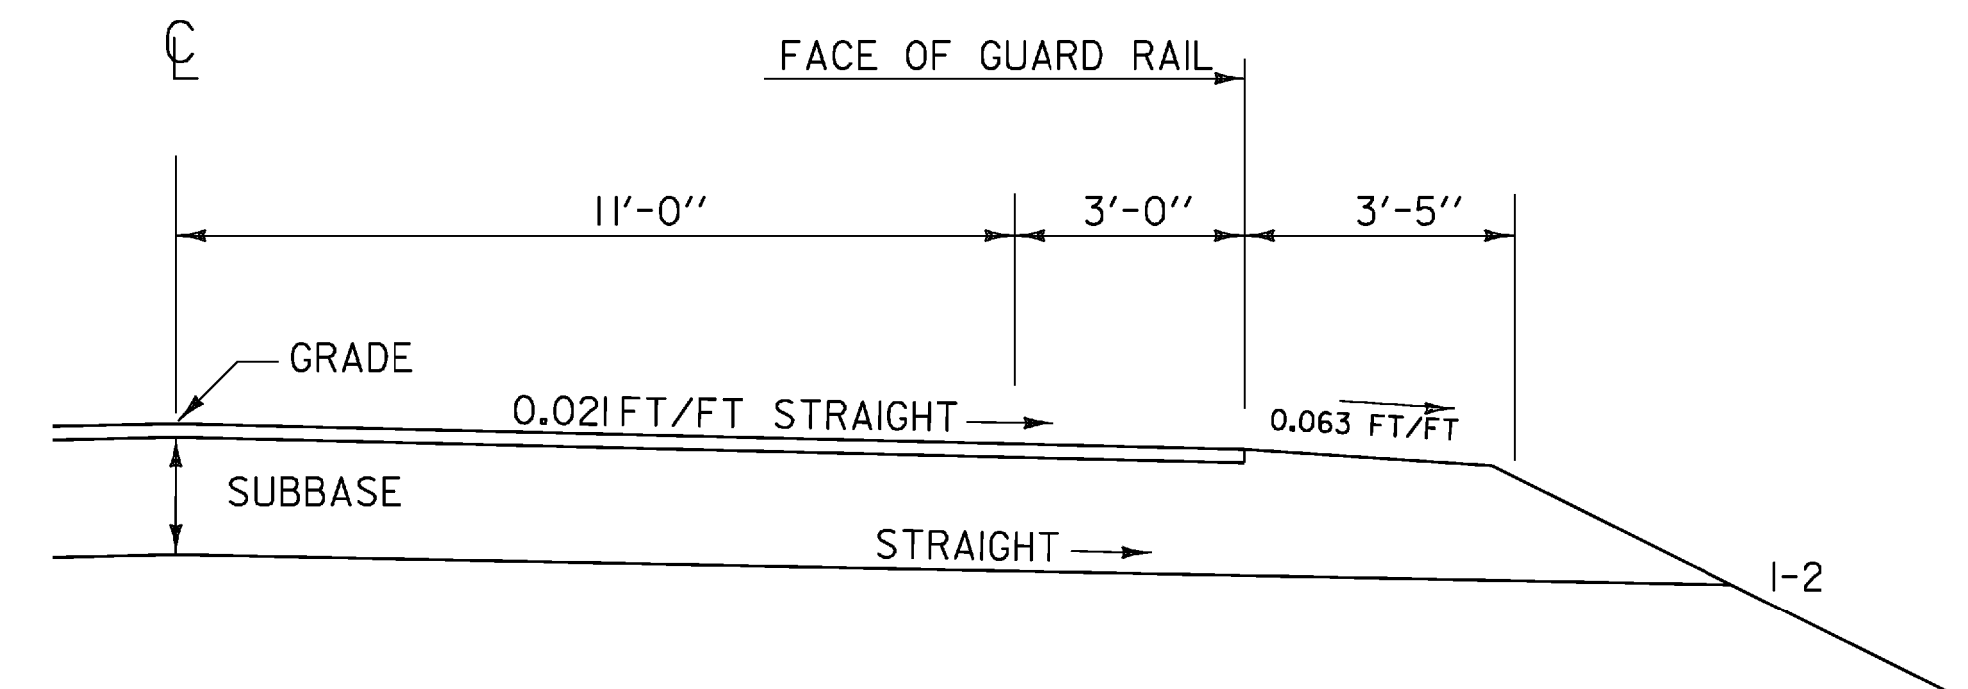

NORMAL SECTION WITH GUARDRAIL
(NOT TO SCALE)

**TOWN HIGHWAY
TYPICAL SECTIONS**

PROJECT NAME:	STOCKBRIDGE
PROJECT NUMBER:	BRF 013-4 (21)
FILE NAME: /78f238/str5/sf238typ.dgn	PLOT DATE: 06-FEB-2008
PROJECT LEADER: K. HIGGINS	DRAWN BY: G. SHANGRAW
DESIGNED BY: T. SUMNER	CHECKED BY: T. FILLBACH
sf238ty2.i	SHEET 4 OF 144