
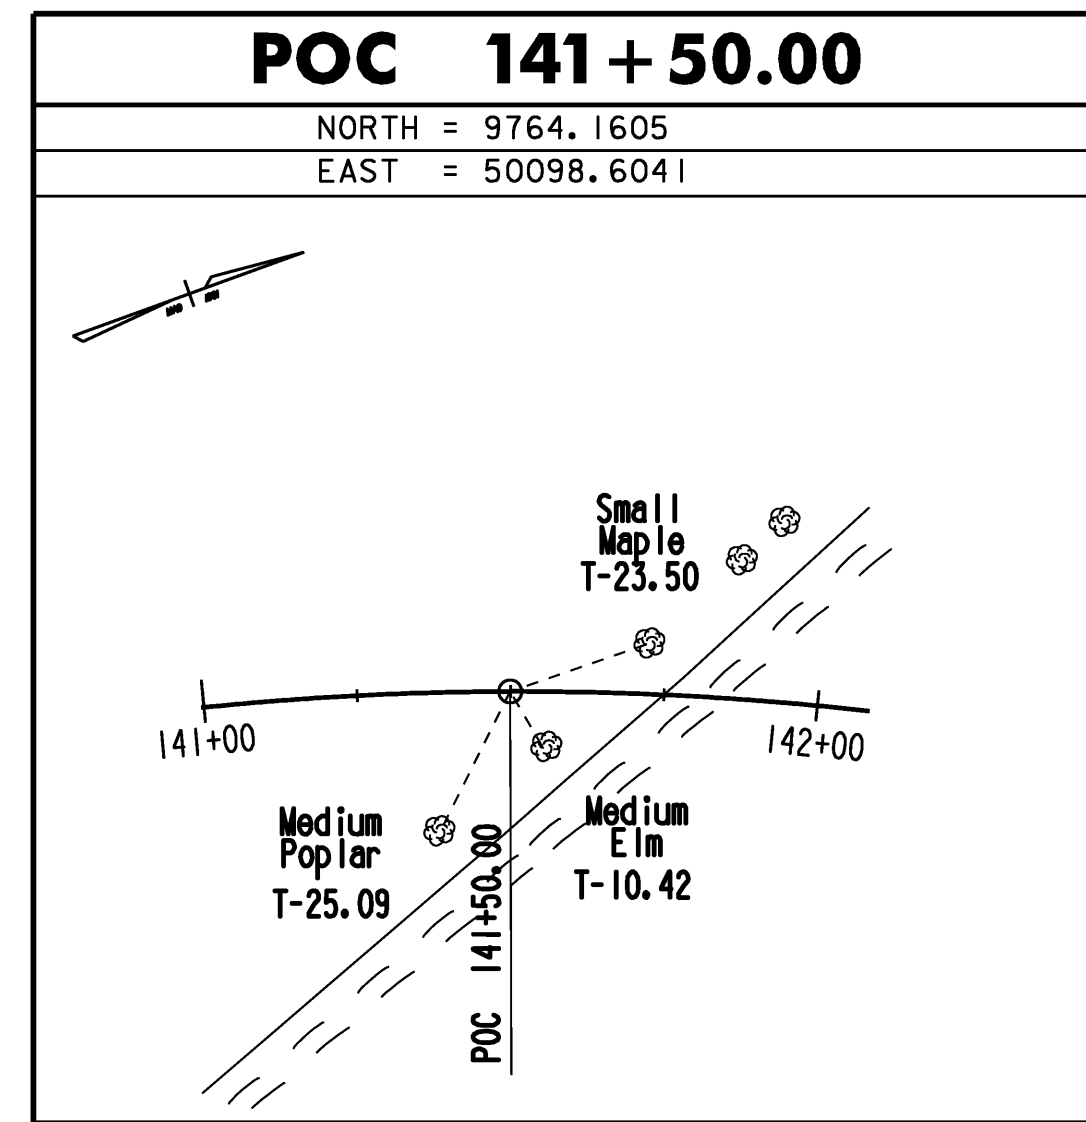
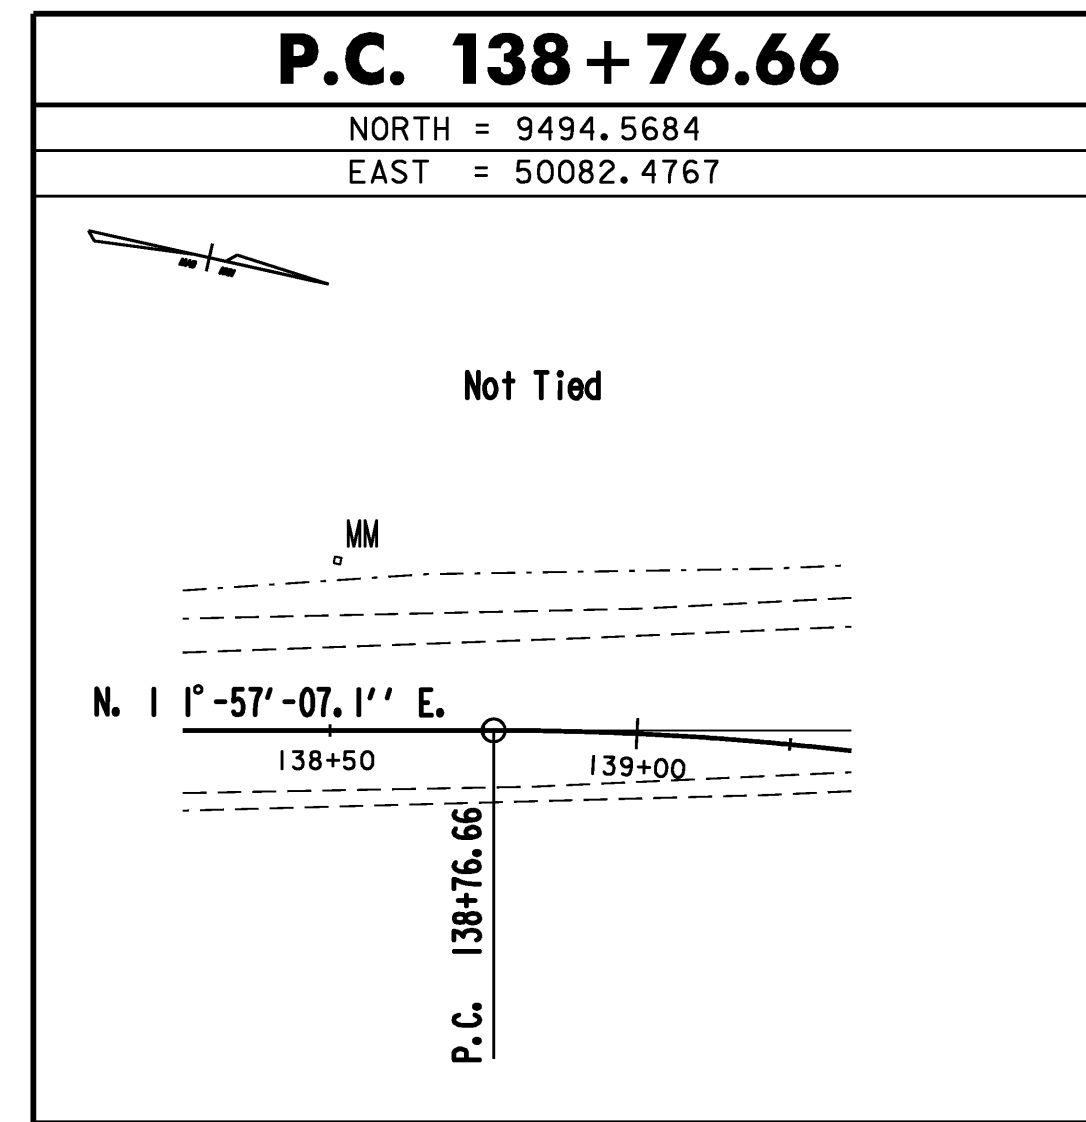
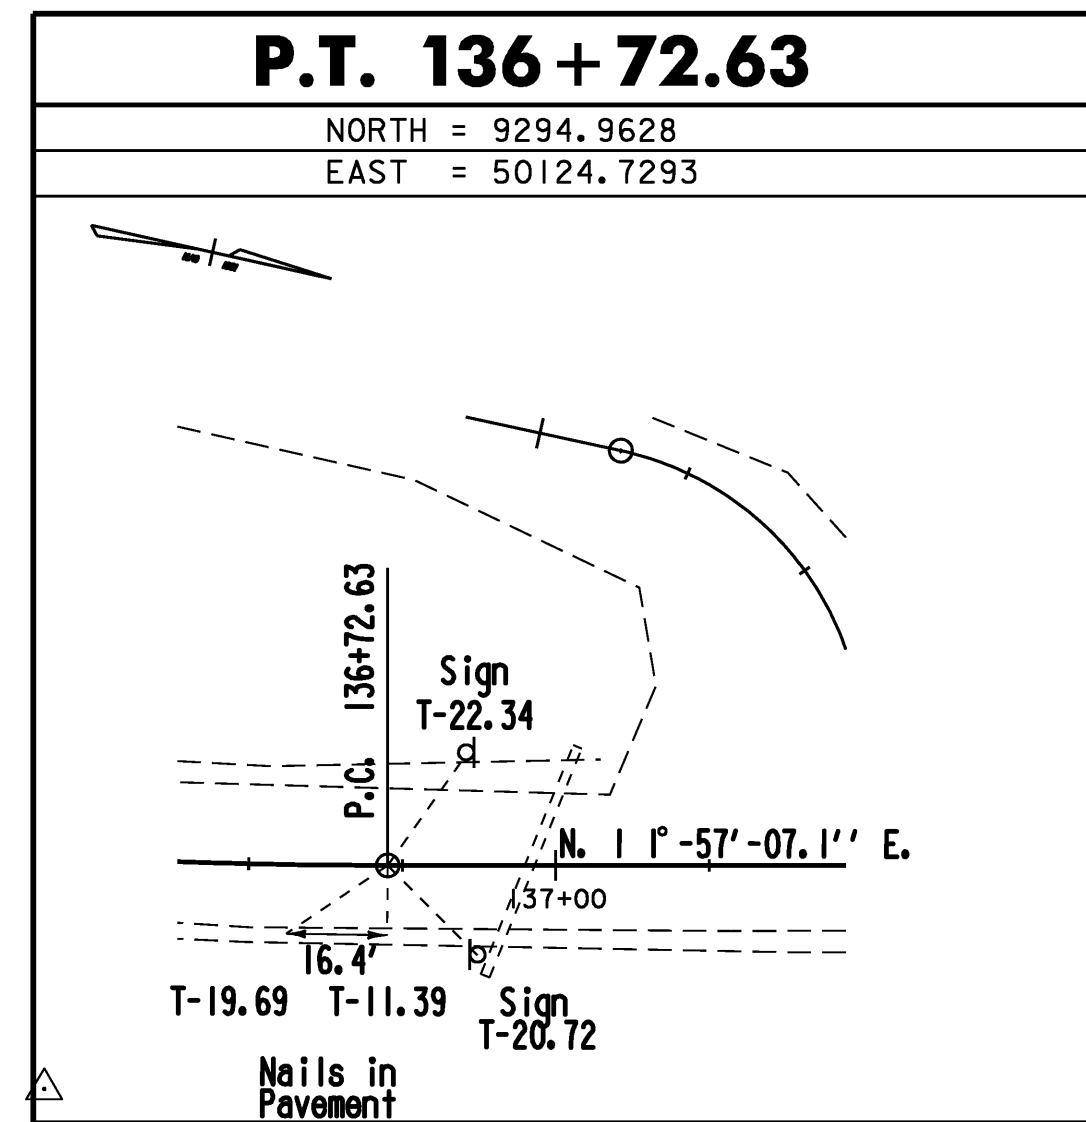
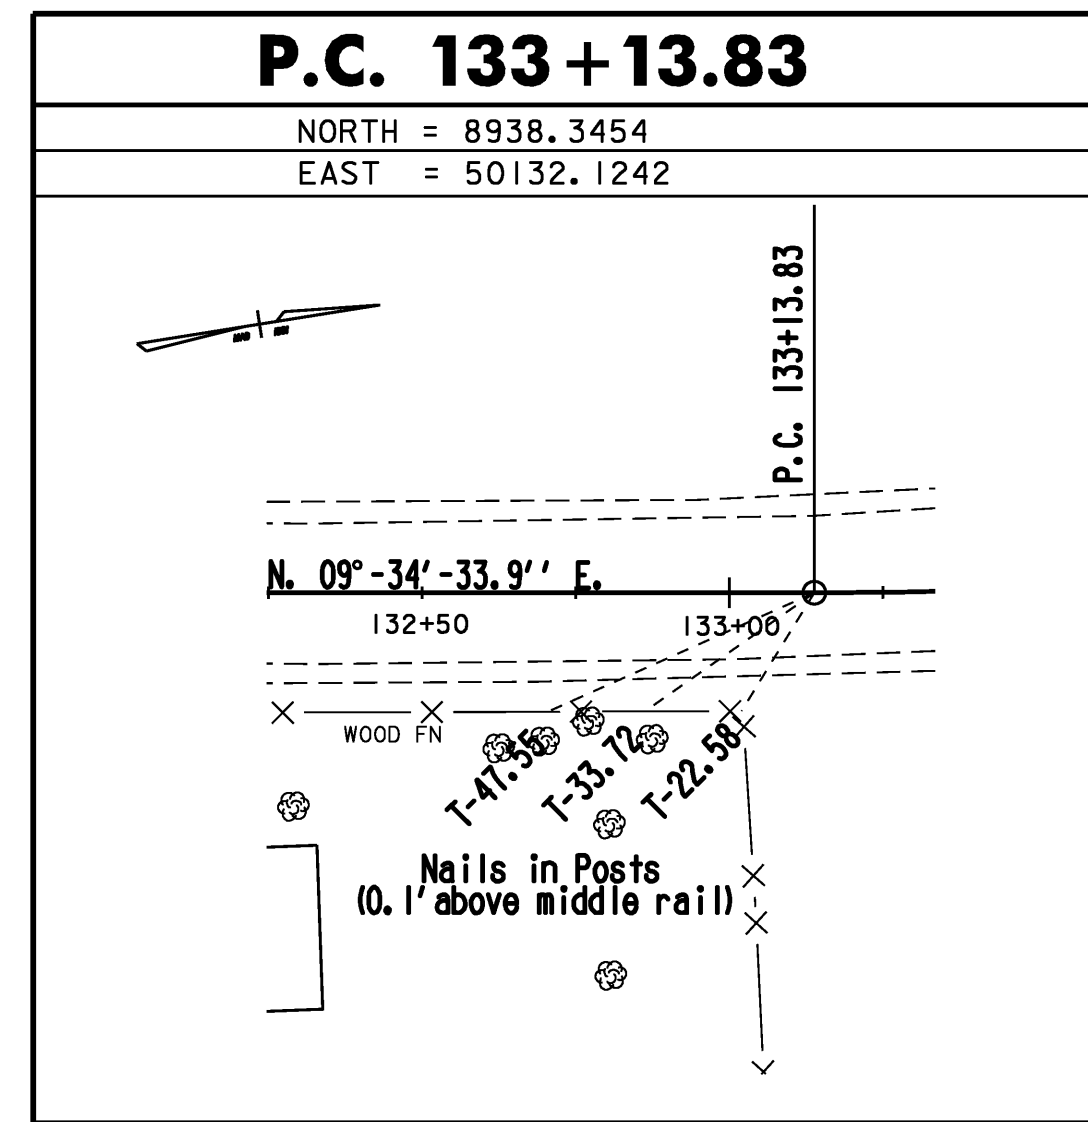




GPS CONTROL POINTS

**ALL HORIZONTAL COORDINATES ARE ASSUMED.  
THERE ARE NO TIES TO GPS CONTROL POINTS.**

ALIGNMENT TIES

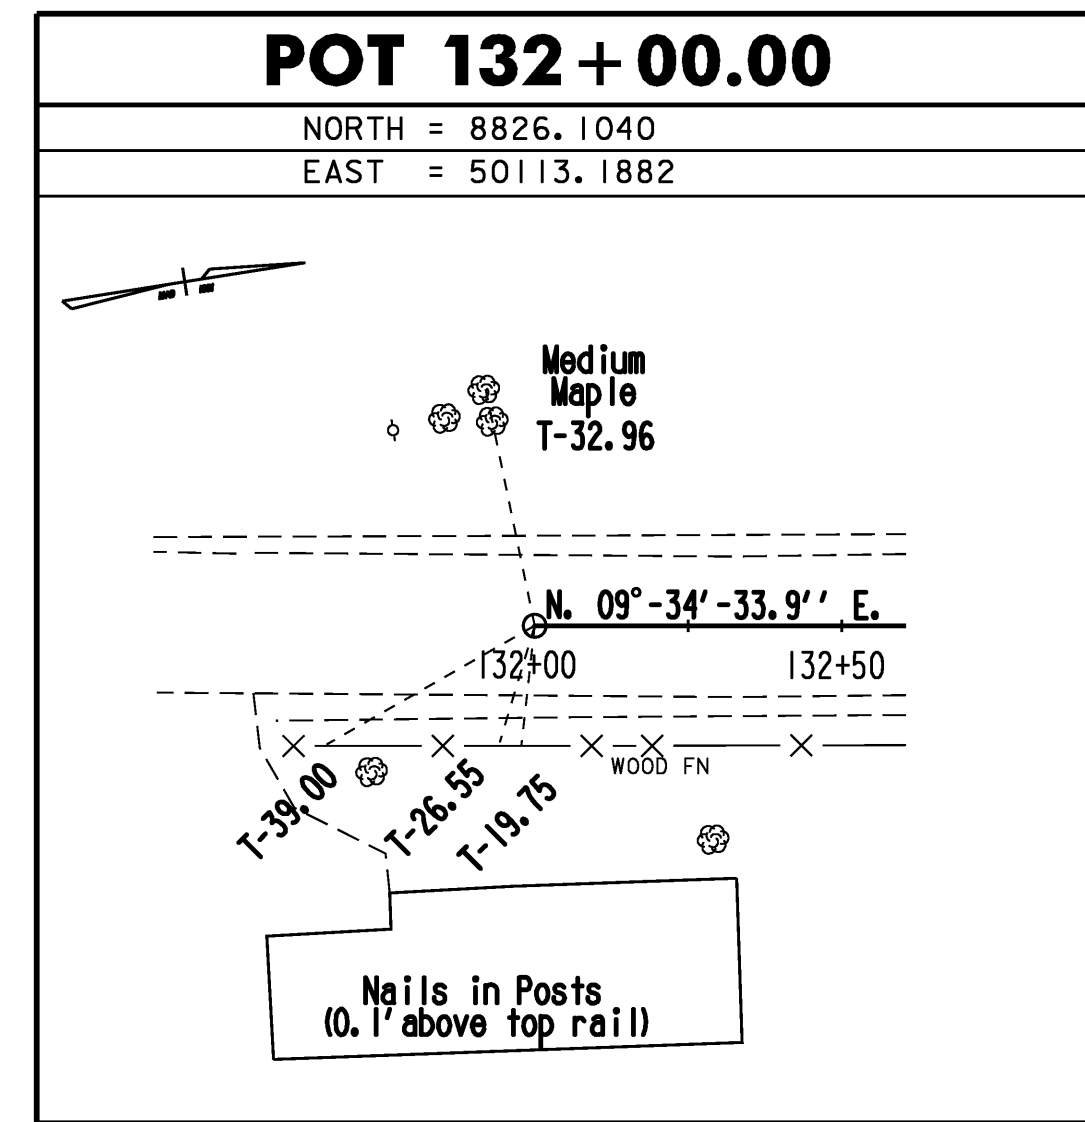

ALIGNMENT TIES

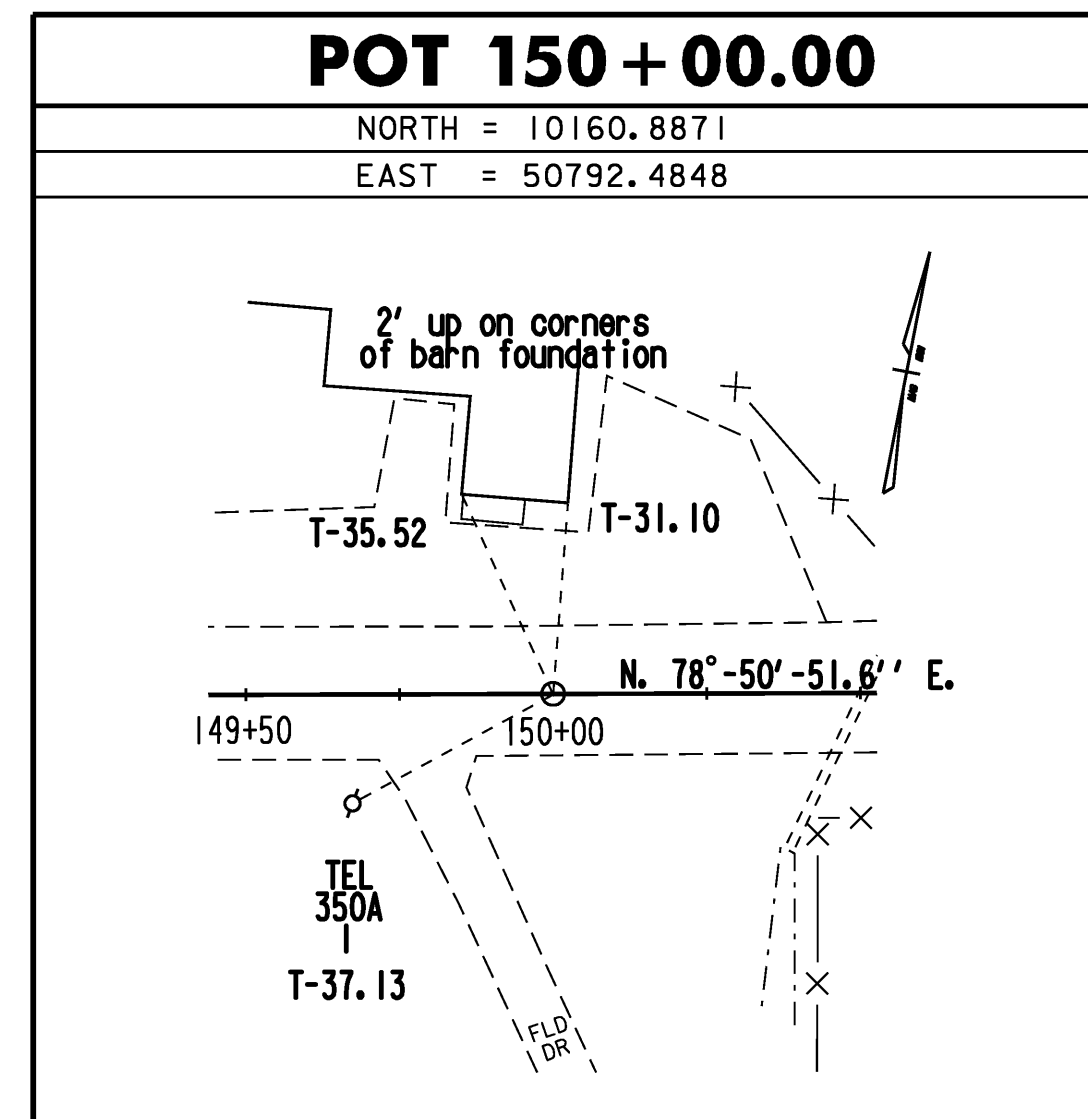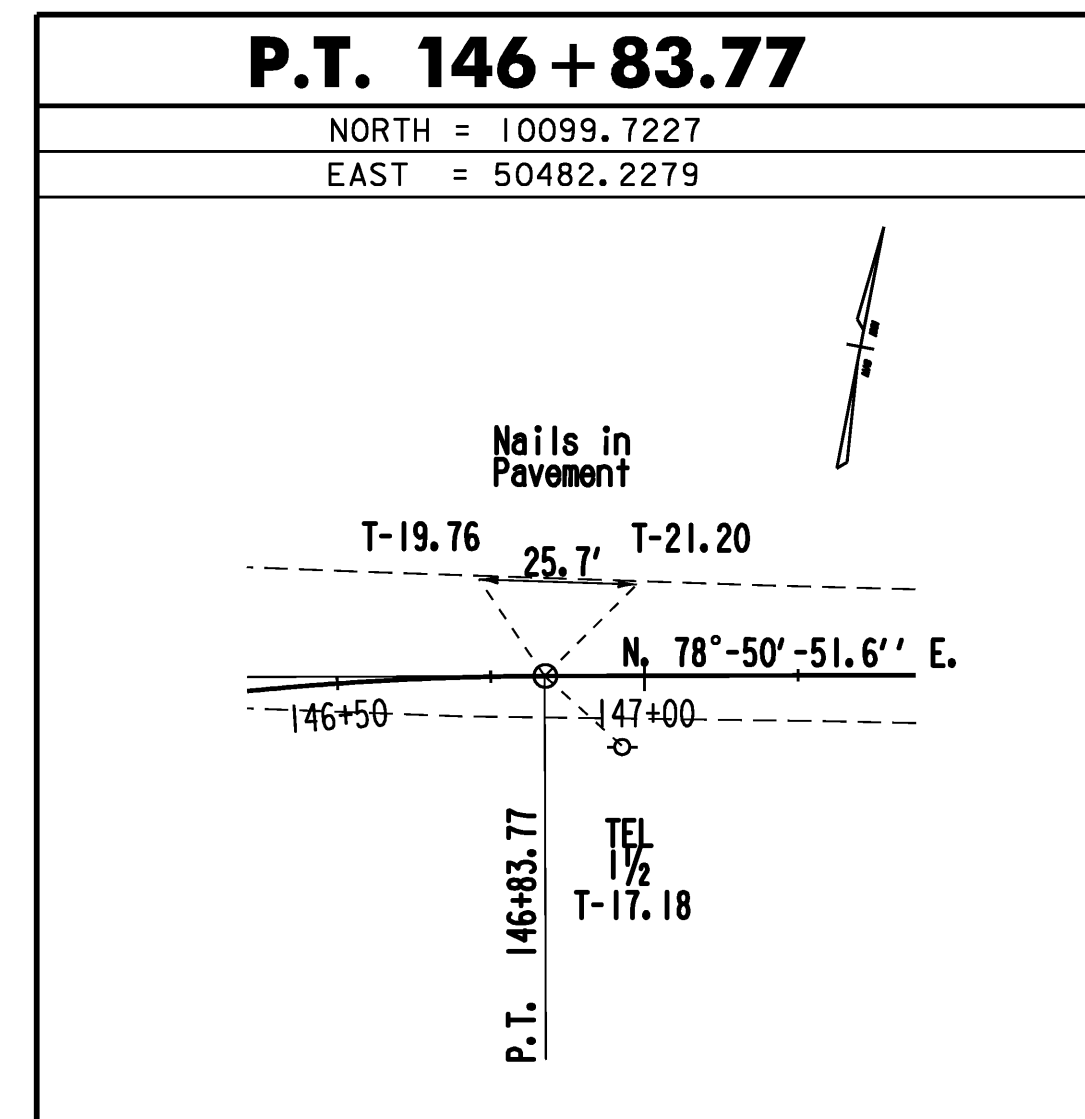

**TIE SHEET**

DATUM	
VERTICAL	NGVD 1929
HORIZONTAL	ASSUMED
ADJUSTMENT	

NOT TO SCALE

PROJECT NAME:	STOCKBRIDGE	PLOT DATE:	06-FEB-2008
PROJECT NUMBER:	BRF 013-4 (21)	DRAWN BY:	G. SHANGRAW
FILE NAME:	/78f238/str5/sf238tie.dgn	DESIGNED BY:	T. SUMNER
		CHECKED BY:	T. FILLBACH
			SHEET 18 OF 144