


STEEL BEAM GUARD RAIL, GALVANIZED
 STA 144+00 - 145+72 RT
 STA 144+00 - 145+95 LT

ANCHOR FOR STEEL BEAM GUARD RAIL
 STA 145+60 RT
 STA 145+85 LT

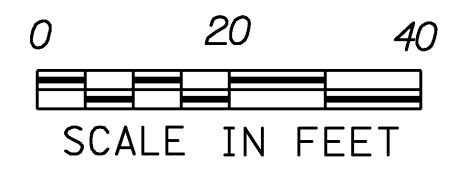

LAYOUT SHEET (4)

PROJECT NAME:	STOCKBRIDGE	FILE NAME:	/78f238/str5/sf238bdr.dgn	PLOT DATE:	06-FEB-2008
PROJECT NUMBER:	BRF 013-4 (21)	PROJECT LEADER:	K. HIGGINS	DRAWN BY:	G. SHANGRAW
		DESIGNED BY:	T. SUMNER	CHECKED BY:	T. FILLBACH
			sf2381a4.i	SHEET 22	OF 144