



STA 132+00 - BEGIN APPROACH

STA 135+00 - BEGIN PROJECT

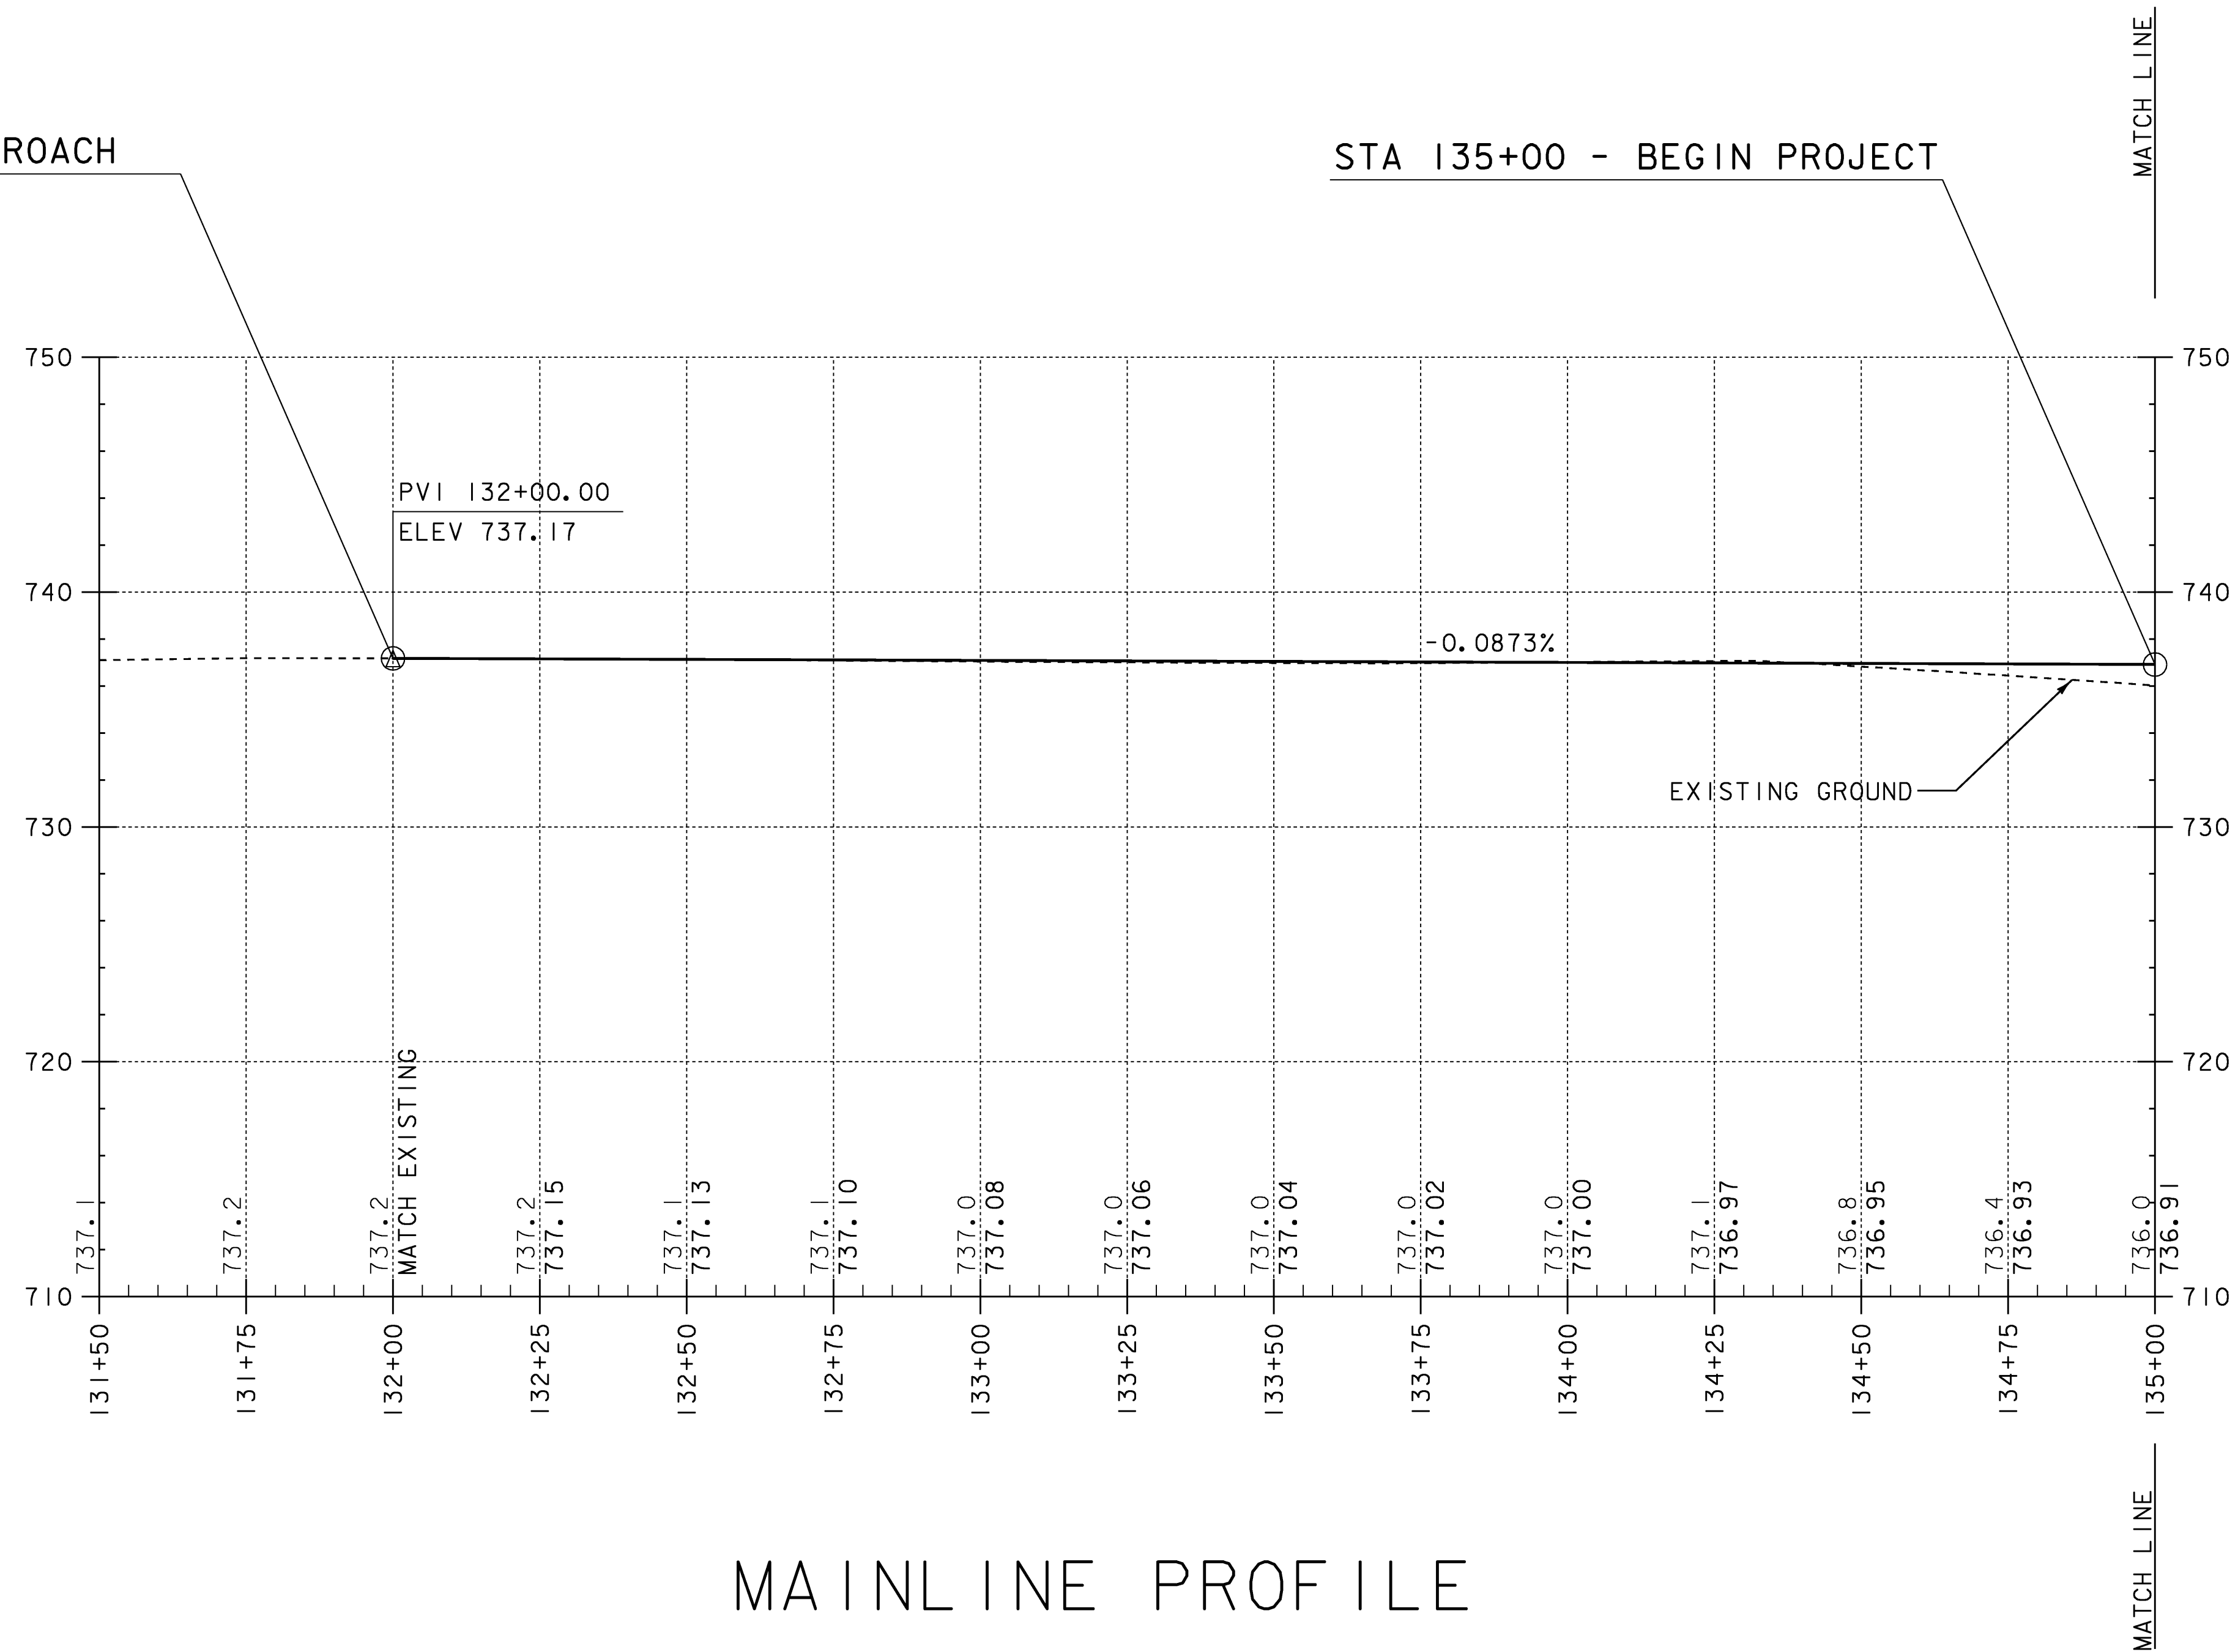

MAINLINE PROFILE

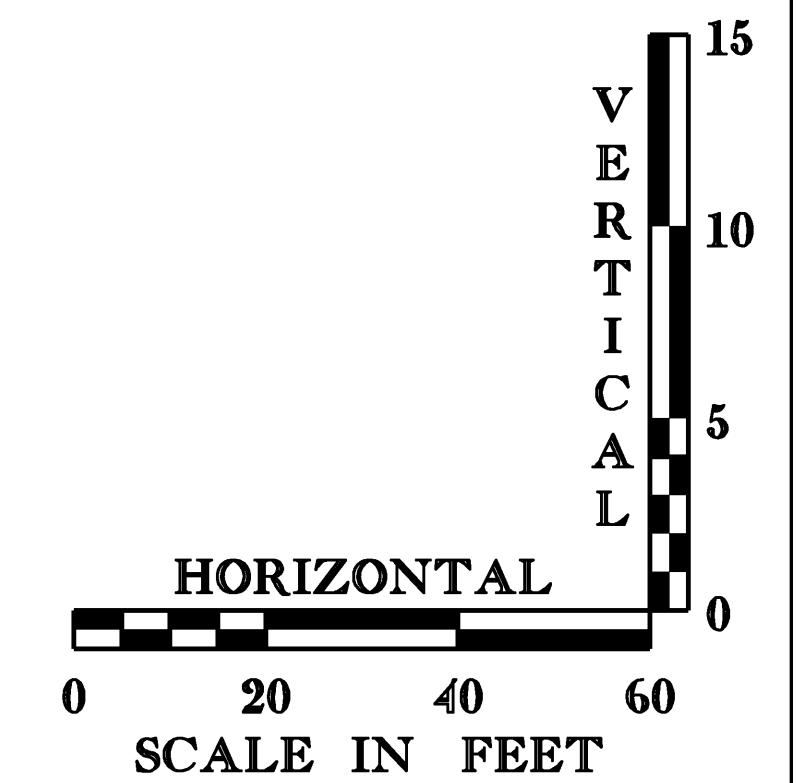

MAINLINE PROFILE 131+50 - 135+00

THE GRADES SHOWN TO THE NEAREST TENTH ARE THE ORIGINAL GROUND ELEVATIONS ALONG THE PROPOSED ALIGNMENT. THE GRADES SHOWN TO THE NEAREST HUNDREDTH ARE THE PROPOSED GRADES FOR THE NEW ALIGNMENT.

PROJECT NAME: STOCKBRIDGE	PLOT DATE: 06-FEB-2008
PROJECT NUMBER: BRF 013-4(21)	DRAWN BY: R. PELLETT
FILE NAME: /78f238/str5/df238xsl.dgn	CHECKED BY: G. SHANGRAW
DESIGNED BY: T. SUMNER	SHEET 23 OF 144