

DURABLE 4 INCH WHITE LINE,  
THERMOPLASTIC  
STA 135+00 RT - 140+00 RT  
STA 135+00 LT - 58+50 LT  
STA 58+50 RT - 140+00 LT


DURABLE 24 INCH STOP BAR,  
THERMOPLASTIC  
T.H. 58 STA 58+19 LT

DURABLE 4 INCH YELLOW LINE,  
THERMOPLASTIC  
STA 135+00 - 137+25 ¢ (DBL)  
STA 137+75 - 140+00 ¢ (DBL)  
T.H. 58 STA 58+18 - 58+50 LT (DBL)

DURABLE LETTER OR SYMBOL,  
THERMOPLASTIC  
T.H. 58 STA 58+28 LT

**SIGN LEGEND**

N	=	NEW
R	=	REMOVE
S	=	SALVAGE

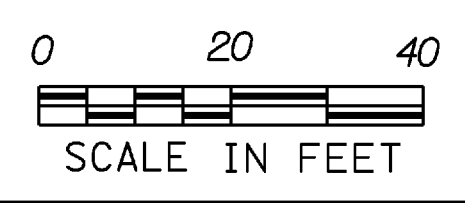

### SIGNS & PAVEMENT MARKINGS LAYOUT (2)

PROJECT NAME:	STOCKBRIDGE
PROJECT NUMBER:	BRF 013-4 (21)
FILE NAME: /78 f238/str/sf238sgnldr.dgn	PLOT DATE: 06-FEB-2008
PROJECT LEADER: K. HIGGINS	DRAWN BY: G. SHANGRAW
DESIGNED BY: T. SUMNER	CHECKED BY: T. FILLBACH
sf238sign2.1	SHEET 32 OF 144