

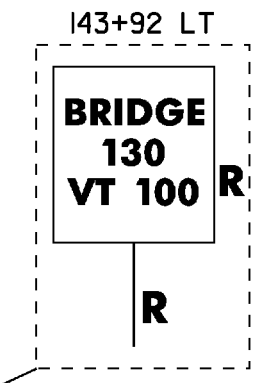
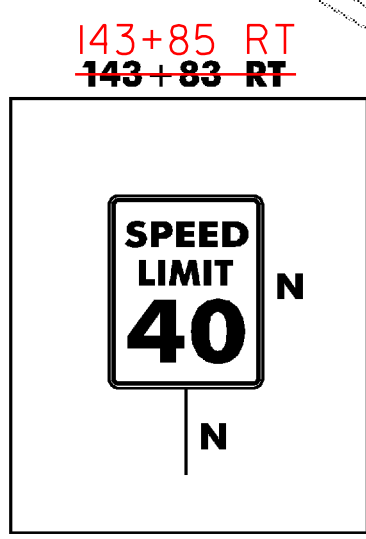
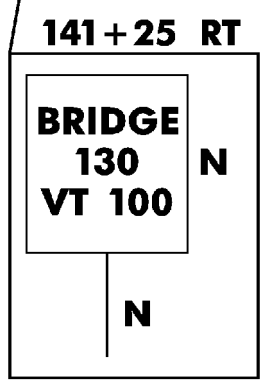
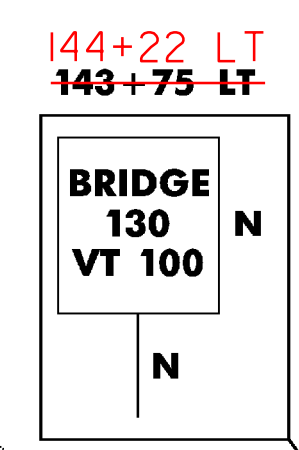
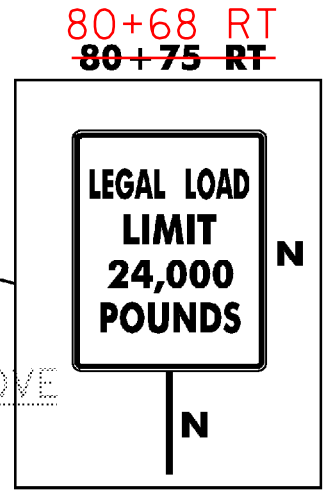
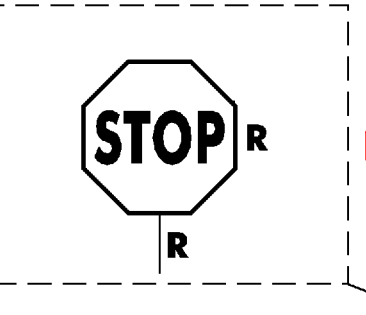


- DURABLE 4 INCH WHITE LINE, THERMOPLASTIC  
 STA 140+00 RT - 144+00 RT  
 STA 140+00 LT - 80+50 LT  
 STA 80+50 RT - 144+00 LT
- DURABLE 4 INCH YELLOW LINE, THERMOPLASTIC  
 STA 140+00 - 140+75¢ (DBL)  
 STA 141+25 - 144+00 ¢ (DBL)  
 TIM. RIV. RD. 80+18 - 80+50 (DBL)
- DURABLE 24 INCH STOP BAR, THERMOPLASTIC  
 TIM. RIV. RD. STA 80+19 LT
- DURABLE LETTER OR SYMBOL, THERMOPLASTIC  
 TIM. RIV. RD. STA 80+25 LT

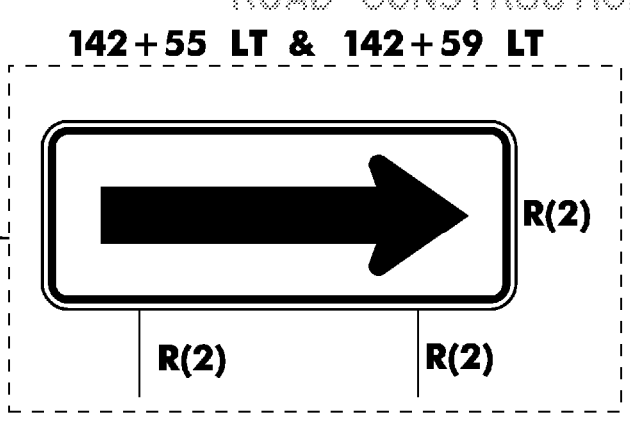

**SIGN LEGEND**

N	=	NEW
R	=	REMOVE
S	=	SALVAGE

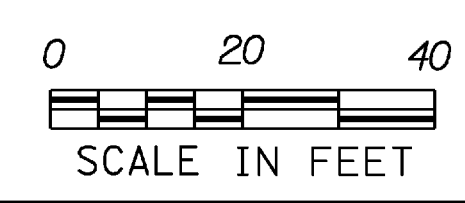

**SIGNS & PAVEMENT MARKINGS LAYOUT (3)**

PROJECT NAME:	STOCKBRIDGE
PROJECT NUMBER:	BRF 013-4 (21)
FILE NAME: /78 f238/sfr/sf238sgnldr.dgn	PLOT DATE: 06-FEB-2008
PROJECT LEADER: K. HIGGINS	DRAWN BY: G. SHANGRAW
DESIGNED BY: T. SUMNER	CHECKED BY: T. FILLBACH
sf238sign3.i	SHEET 33 OF 144