


SIGN LEGEND

N	=	NEW
R	=	REMOVE
S	=	SALVAGE

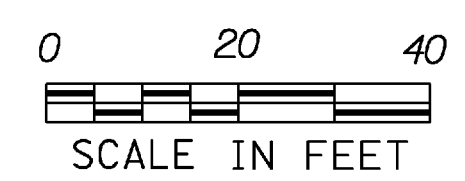

DURABLE 4 INCH WHITE LINE, THERMOPLASTIC
STA 144+00 - 149+00 RT & LT

DURABLE 4 INCH YELLOW LINE, THERMOPLASTIC
STA 144+00 - 149+00 & (DBL)

SIGNS & PAVEMENT MARKINGS LAYOUT (4)

PROJECT NAME:	STOCKBRIDGE
PROJECT NUMBER:	BRF 013-4 (21)
FILE NAME: /78 f238/str/sf238sgnldr.dgn	PLOT DATE: 06-FEB-2008
PROJECT LEADER: K. HIGGINS	DRAWN BY: G. SHANGRAW
DESIGNED BY: T. SUMNER	CHECKED BY: T. FILLBACH
sf238sign4.i	SHEET 34 OF 144