
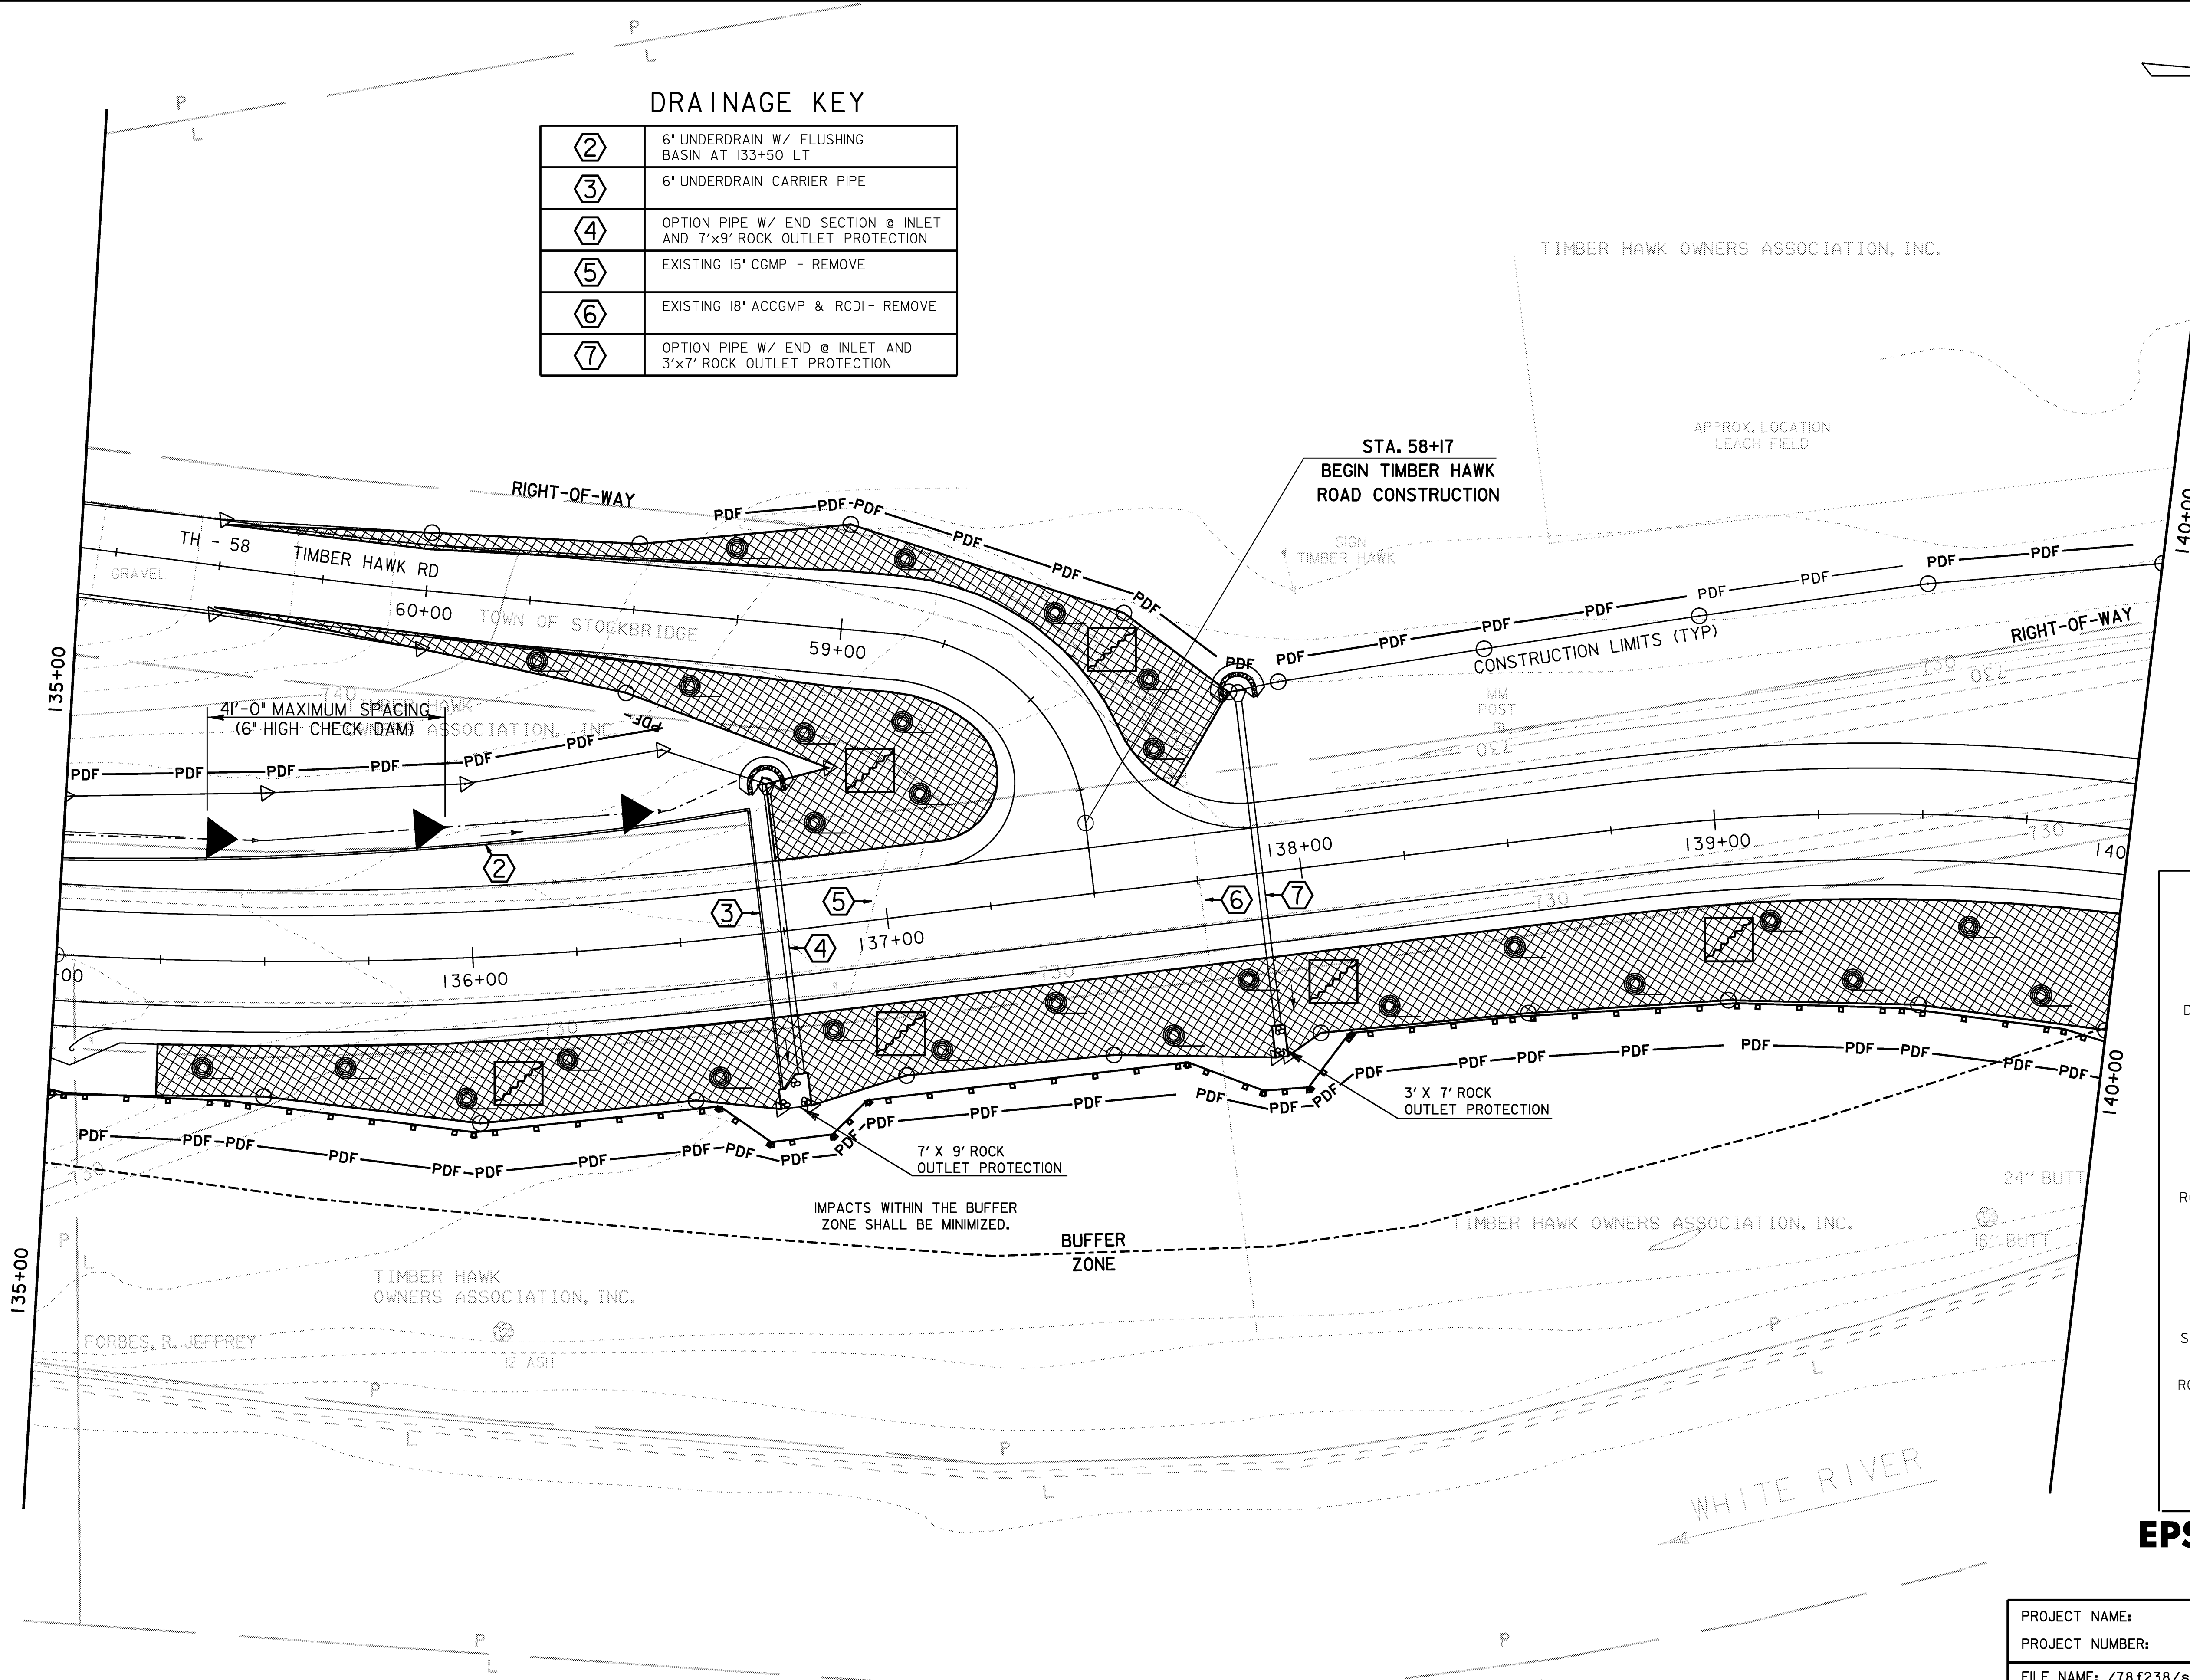


**DRAINAGE KEY**

②	6" UNDERDRAIN W/ FLUSHING BASIN AT 133+50 LT
③	6" UNDERDRAIN CARRIER PIPE
④	OPTION PIPE W/ END SECTION @ INLET AND 7'x9' ROCK OUTLET PROTECTION
⑤	EXISTING 15" CGMP - REMOVE
⑥	EXISTING 18" ACCGMP & RCDD - REMOVE
⑦	OPTION PIPE W/ END @ INLET AND 3'x7' ROCK OUTLET PROTECTION

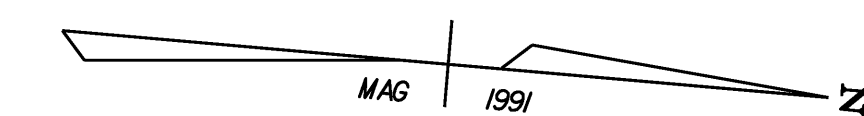

**LEGEND**

CHECK DAM	
DUST CONTROL	
DROP INLET PROTECTION	
FILTER BAGS	
LIVE FASCINE	
PROJECT DEMARCATION FENCE	
ROLLED EROSION CONTROL PRODUCT (RECP)	
TEMPORARY INLET PROTECTION	
SILT FENCE	
STABILIZED CONSTRUCTION ENTRANCE	
ROCK OUTLET PROTECTION	
SURFACE ROUGHENING	
TURBIDITY CURTAIN	

**EPSC CONSTRUCTION PLAN SHEET (2)**

PROJECT NAME:	STOCKBRIDGE
PROJECT NUMBER:	BRF 013-4 (21)
FILE NAME: /78f238/str5/sf238epsbdr	PLOT DATE: 06-FEB-2008
PROJECT LEADER: K. HIGGINS	DRAWN BY: J. SALVATORI
DESIGNED BY: J. LACROIX	CHECKED BY: T. FILLBACH
sf238ec_dur2.i	SHEET 43 OF 144

EXISTING CONTOURS ARE SHOWN. SEE CROSS SECTIONS FOR FINAL CONTOURS.

