


**LEGEND**

CHECK DAM	
DUST CONTROL	
DROP INLET PROTECTION	
FILTER BAGS	
LIVE FASCINE	
PROJECT DEMARCATION FENCE	
ROLLED EROSION CONTROL PRODUCT (RECP)	
TEMPORARY INLET PROTECTION	
SILT FENCE	
STABILIZED CONSTRUCTION ENTRANCE	
CONCRETE WALL	
ROCK OUTLET PROTECTION	
SURFACE ROUGHENING	
TURBIDITY CURTAIN	

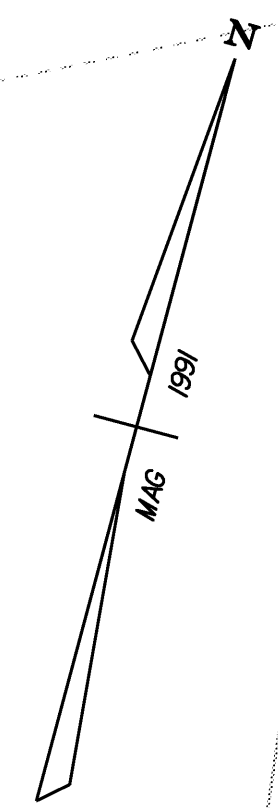

KETCHUM, ROBERT A. & GAIL J.

GREEN, THEODORE J.W. JR. & BARBARA S.

UNITED STATES OF AMERICA  
DEPARTMENT OF AGRICULTURE  
FOREST SERVICE

GRAVEL DRIVE  
RIGHT-OF-WAY

**DRAINAGE KEY**

	SPECIAL DITCH - PAID UNDER COMMON EXCAVATION
--	--

**STAGE 1 - CONSTRUCTION**  
INSTALL CONSTRUCTION ENTRANCE IN THIS AREA PRIOR TO BEGINNING CONSTRUCTION OF NEW BRIDGE, ALIGNMENT AND OTHER CONSTRUCTION ACTIVITIES ACCESSED FROM THIS POINT.

**STAGE 2 - REMOVAL**  
INSTALL CONSTRUCTION ENTRANCE IN THIS AREA PRIOR TO BEGINNING DEMOLITION OF EXISTING BRIDGE, ALIGNMENT AND OTHER CONSTRUCTION ACTIVITIES ACCESSED FROM THIS POINT

**EPSC CONSTRUCTION PLAN SHEET (4)**

PROJECT NAME: STOCKBRIDGE  
PROJECT NUMBER: BRF 013-4 (21)

FILE NAME: /78f238/str5/sf238ec.dgn PLOT DATE: 06-FEB-2008  
PROJECT LEADER: K. HIGGINS DRAWN BY: J. SALVATORI  
DESIGNED BY: J. LACROIX CHECKED BY: T. FILLBACH  
sf238ec\_dur4.i SHEET 45 OF 144



EXISTING CONTOURS ARE SHOWN. SEE CROSS SECTIONS FOR FINAL CONTOURS.