


PLAN
SCALE: 1" = 10'-0"

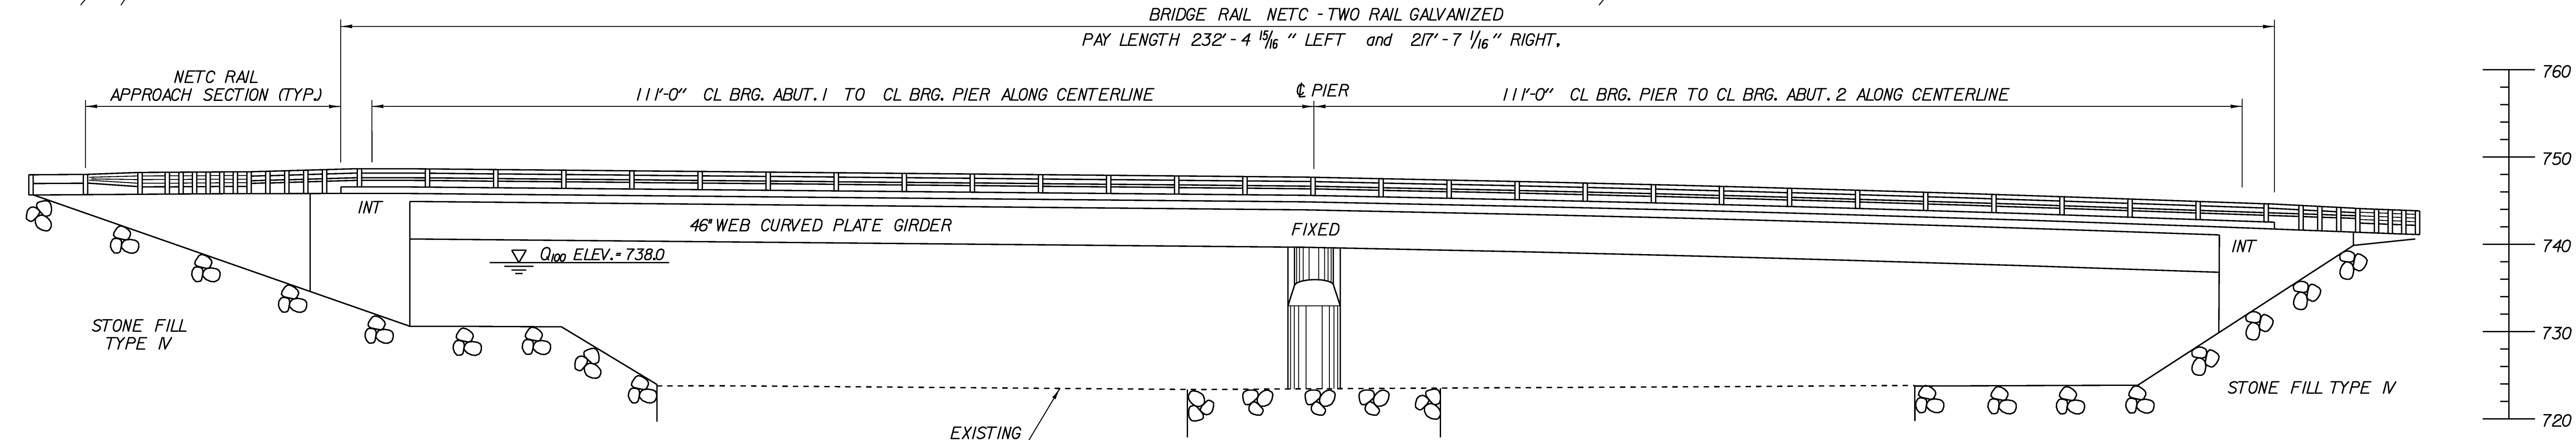

ELEVATION
SCALE: 1" = 10'-0"

PLAN AND ELEVATION

PROJECT NAME:	STOCKBRIDGE	PLOT DATE:	06-FEB-2008
PROJECT NUMBER:	BRF 013-4 (21)	DRAWN BY:	G. SHANGRAW
FILE NAME:	/78f238/str5/sf238pe.dgn	DESIGNED BY:	T. SUMNER
		CHECKED BY:	T. FILLBACH
			SHEET 70 OF 144