



APPROACH SLAB NO. 1

SCALE 1/4" = 1'-0"
1 0 2 4 6

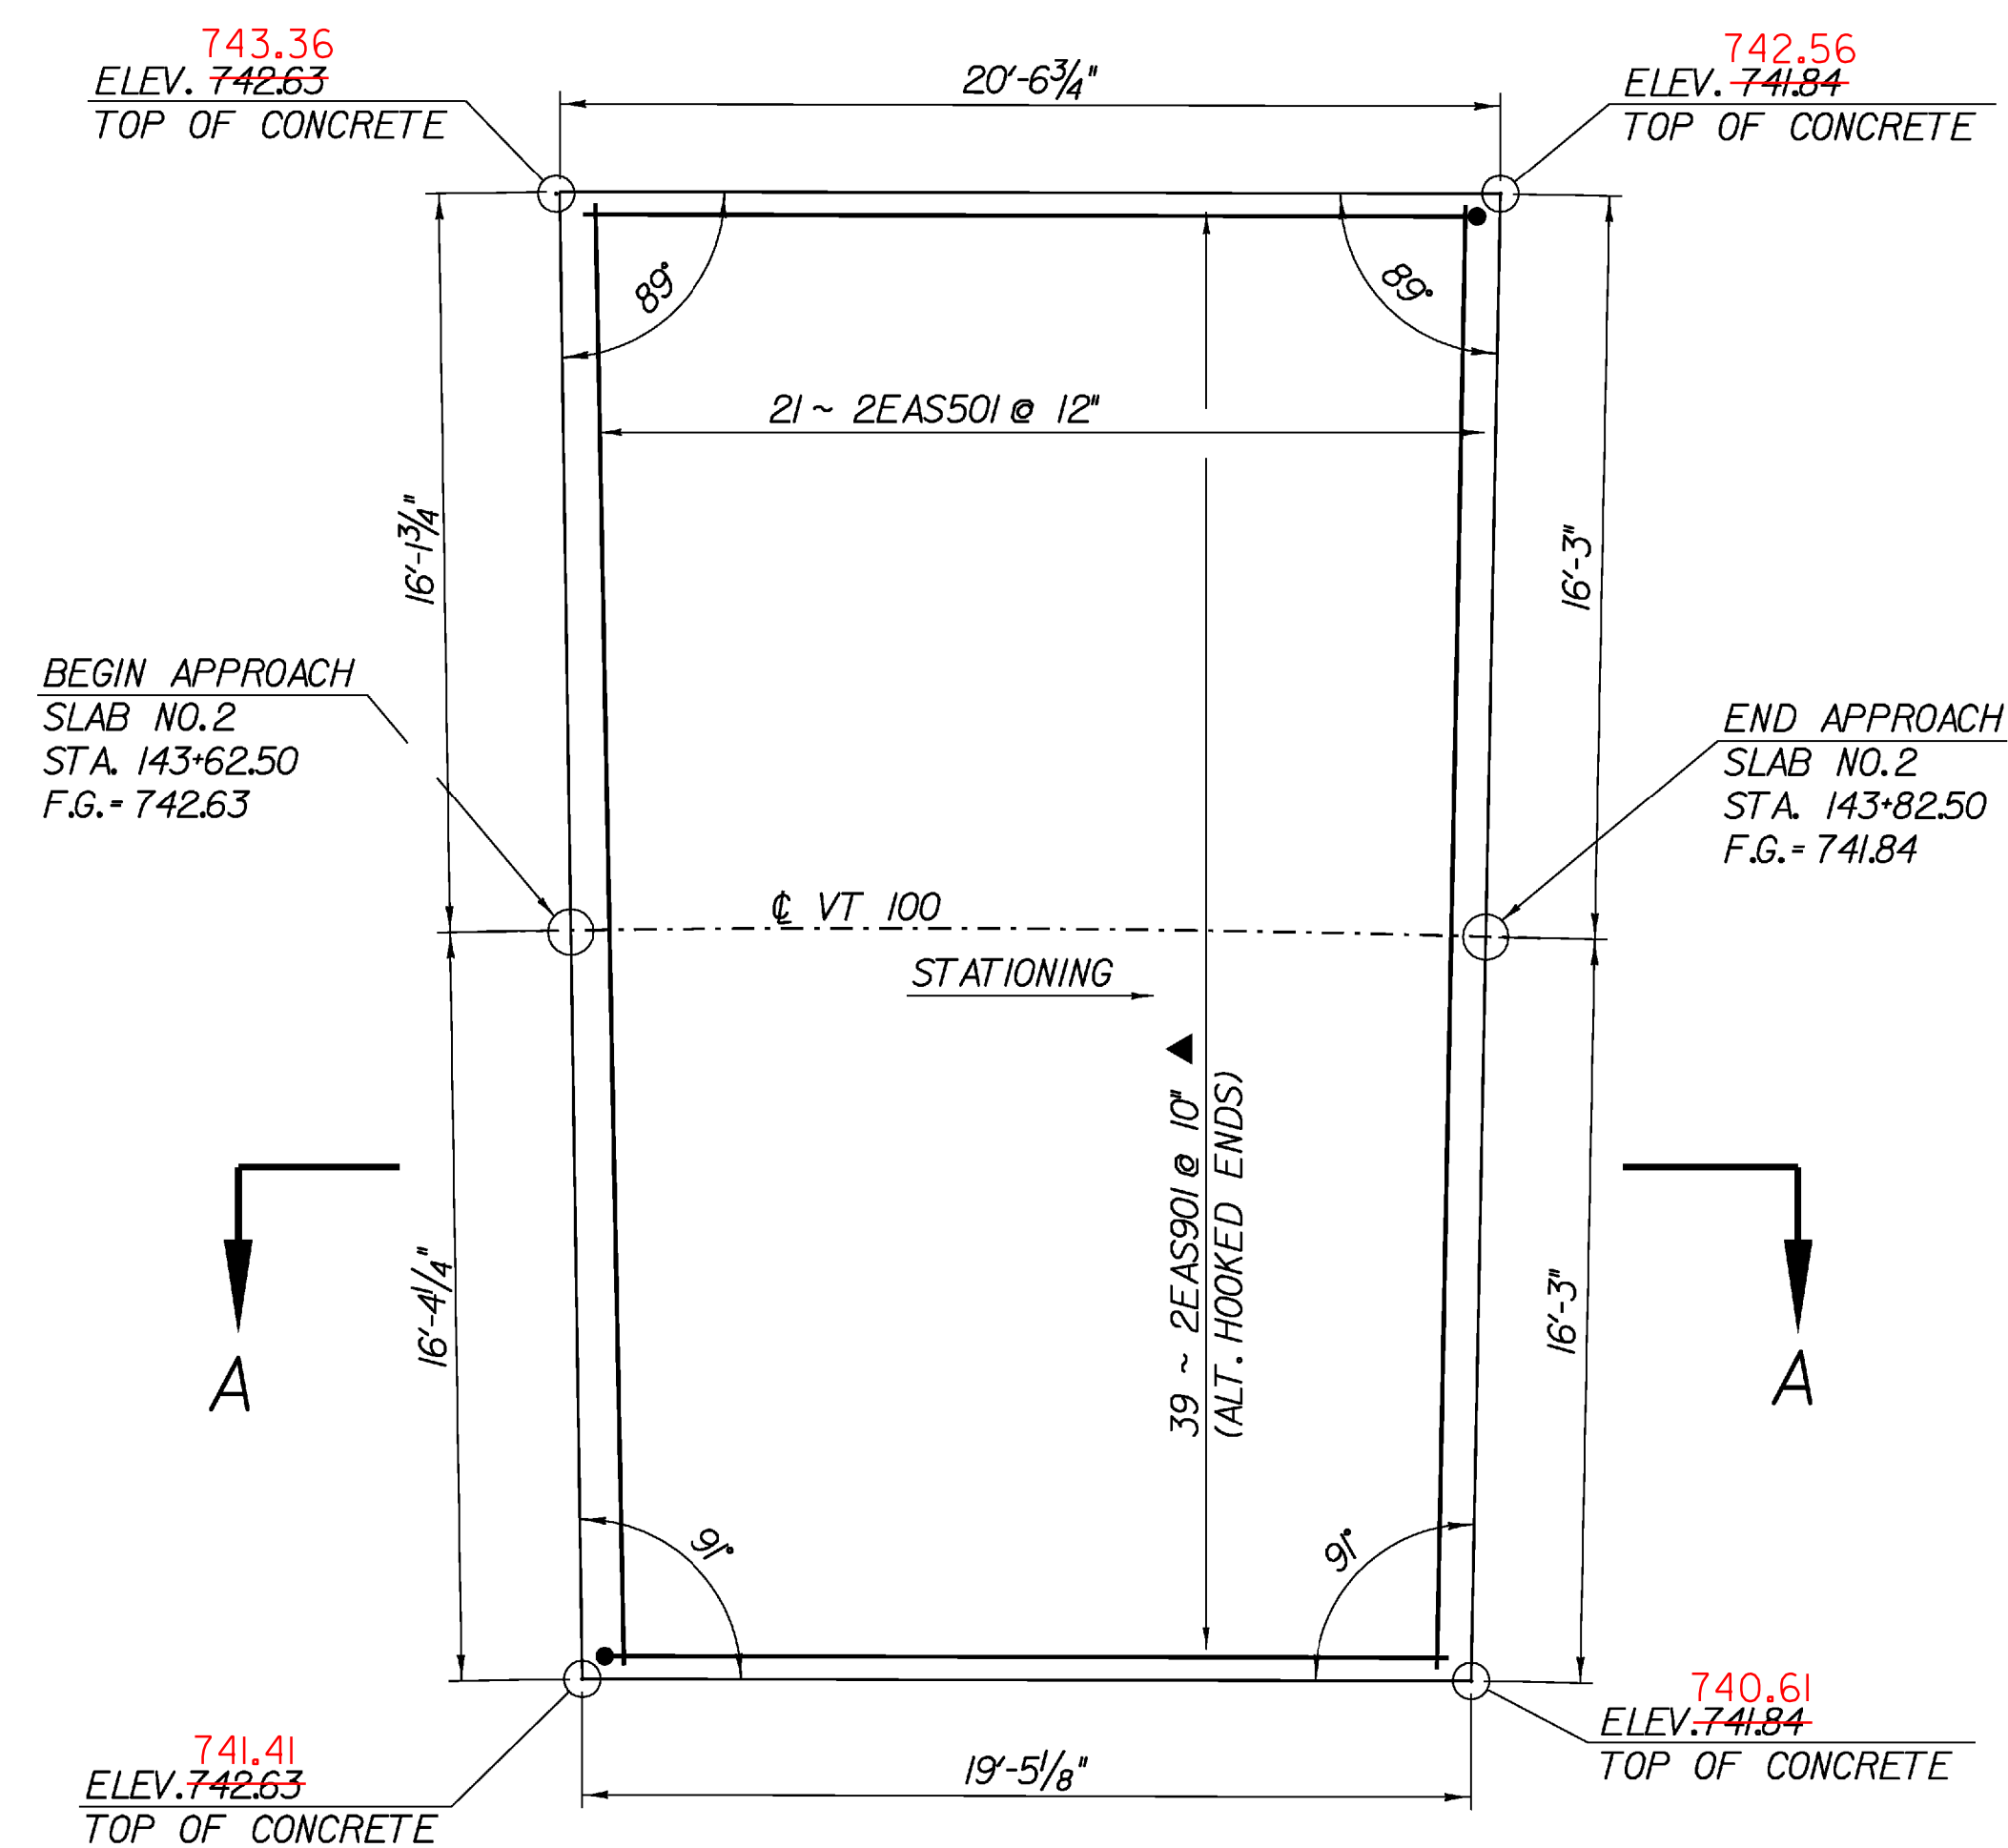


APPROACH SLAB NO. 2

SCALE 1/4" = 1'-0"
1 0 2 4 6

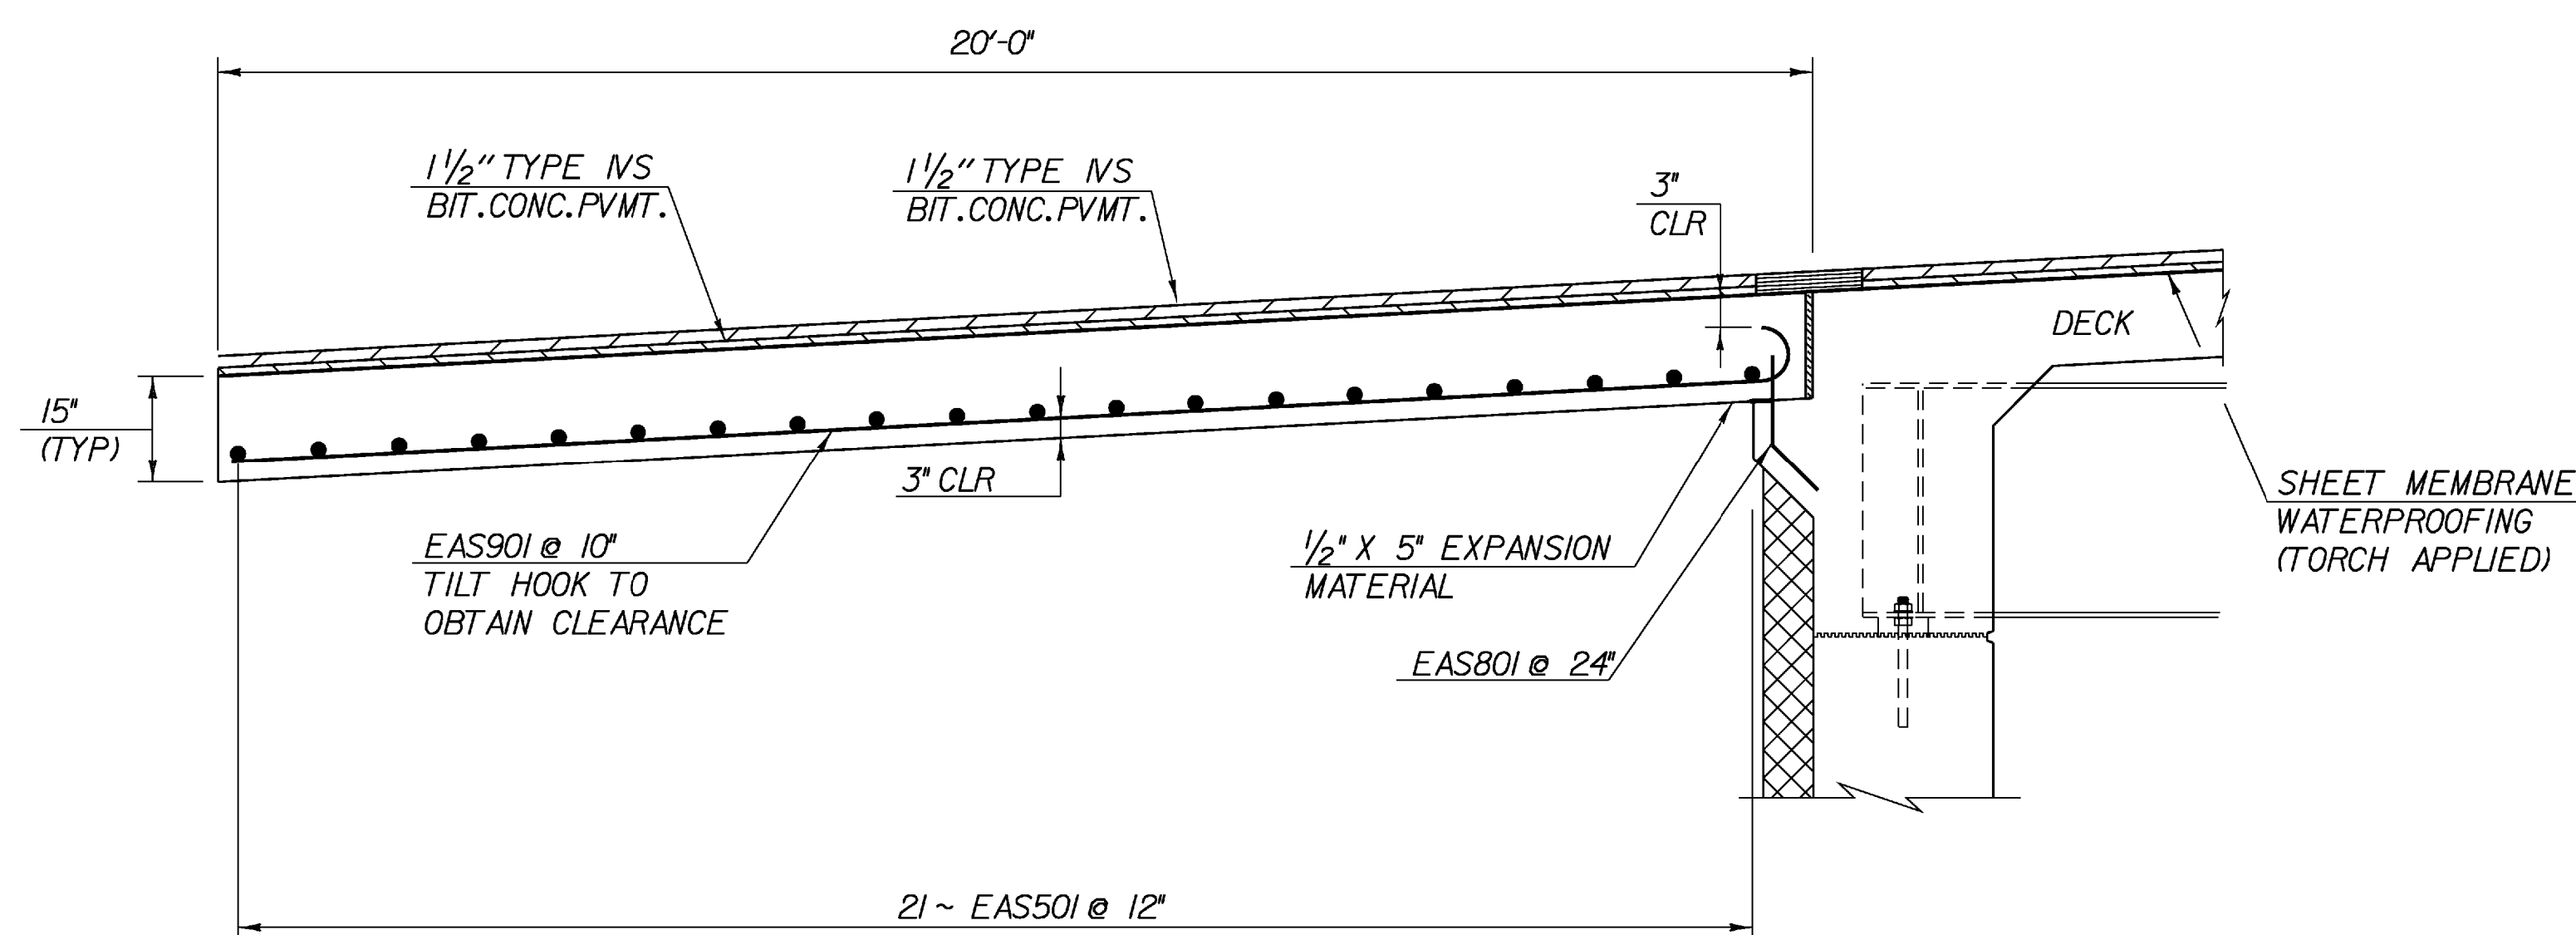

SECTION A-A
APPROACH SLAB
ELEVATION (TYP)

SCALE 1/2" = 1'-0"
1 0 1 2

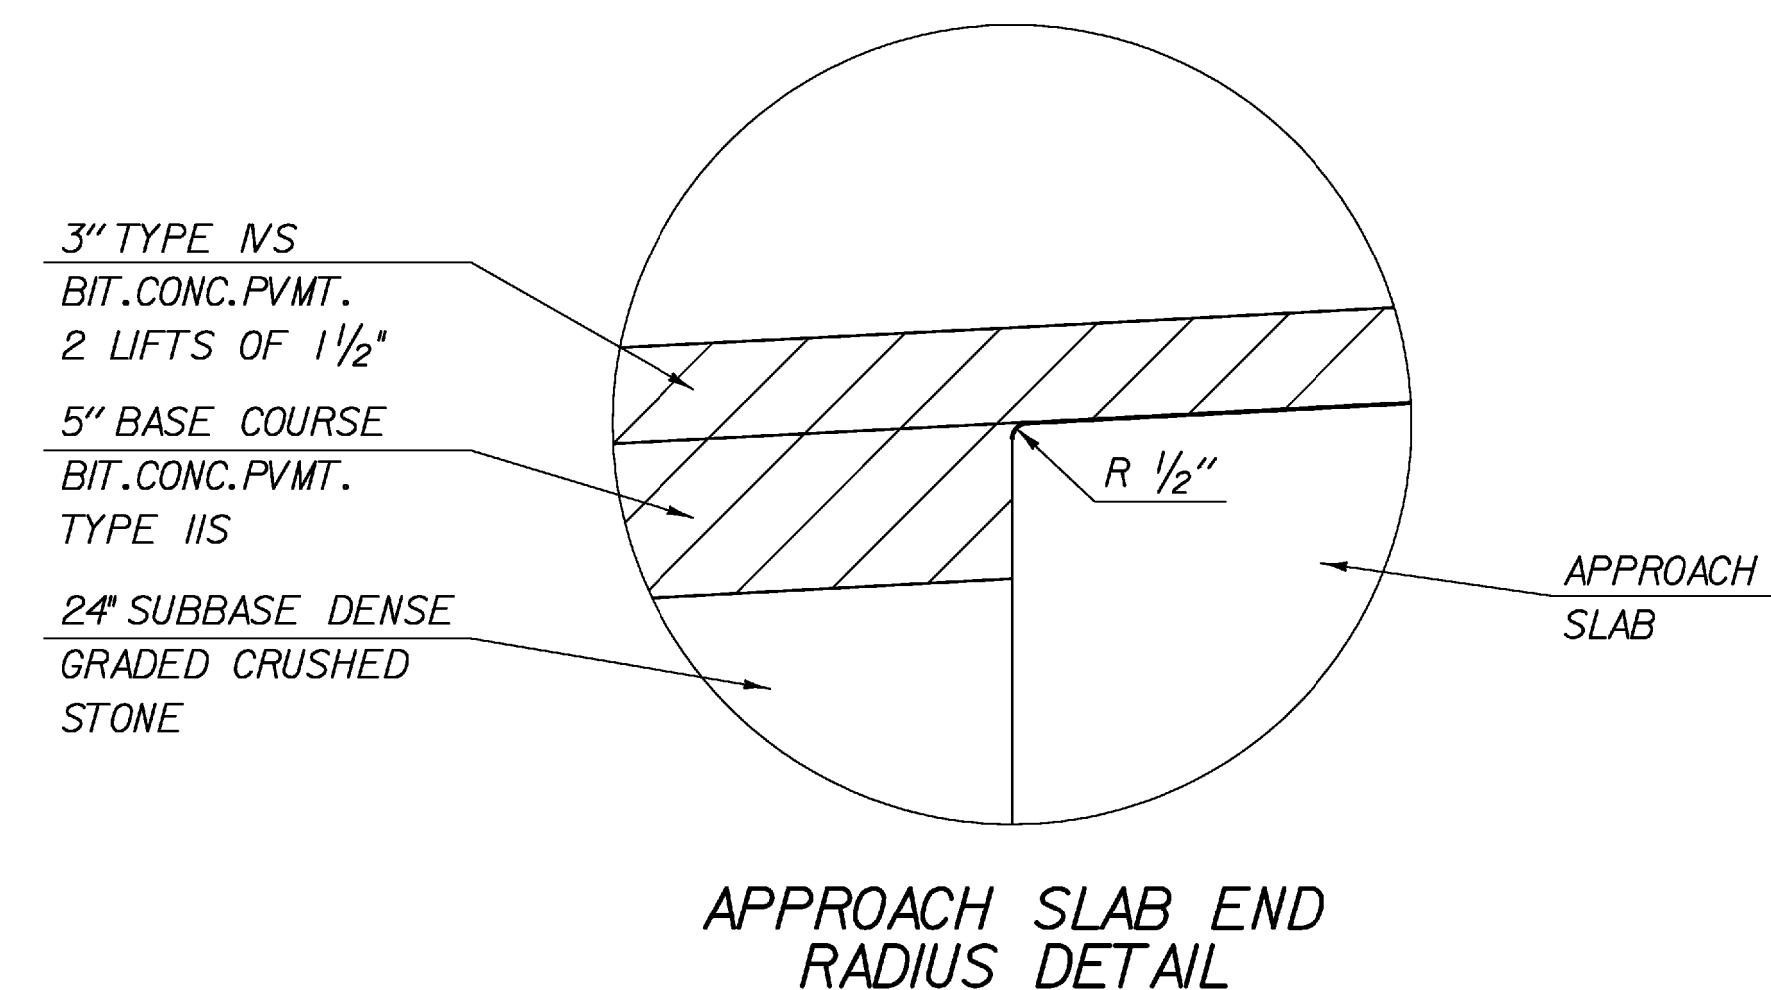

NOTE:

NF = NEAR FACE
FF = FAR FACE
EF = EACH FACE
▲ = CUT TO FIT IN FIELD
3" CLR. UNLESS OTHERWISE
SPECIFIED ON THE PLANS.

APPROACH SLAB DETAILS

PROJECT NAME: STOCKBRIDGE
PROJECT NUMBER: BRF 013-4(21)

FILE NAME: /78f238/s+r5/sf238sup.dgn
PROJECT LEADER: K. HIGGINS
DESIGNED BY: T. SUMNER
sf238asd.1

PLOT DATE: 06-FEB-2008
DRAWN BY: R. PELLETT
CHECKED BY: T. FILLBACH
SHEET 87 OF 144