


PIER ELEVATION

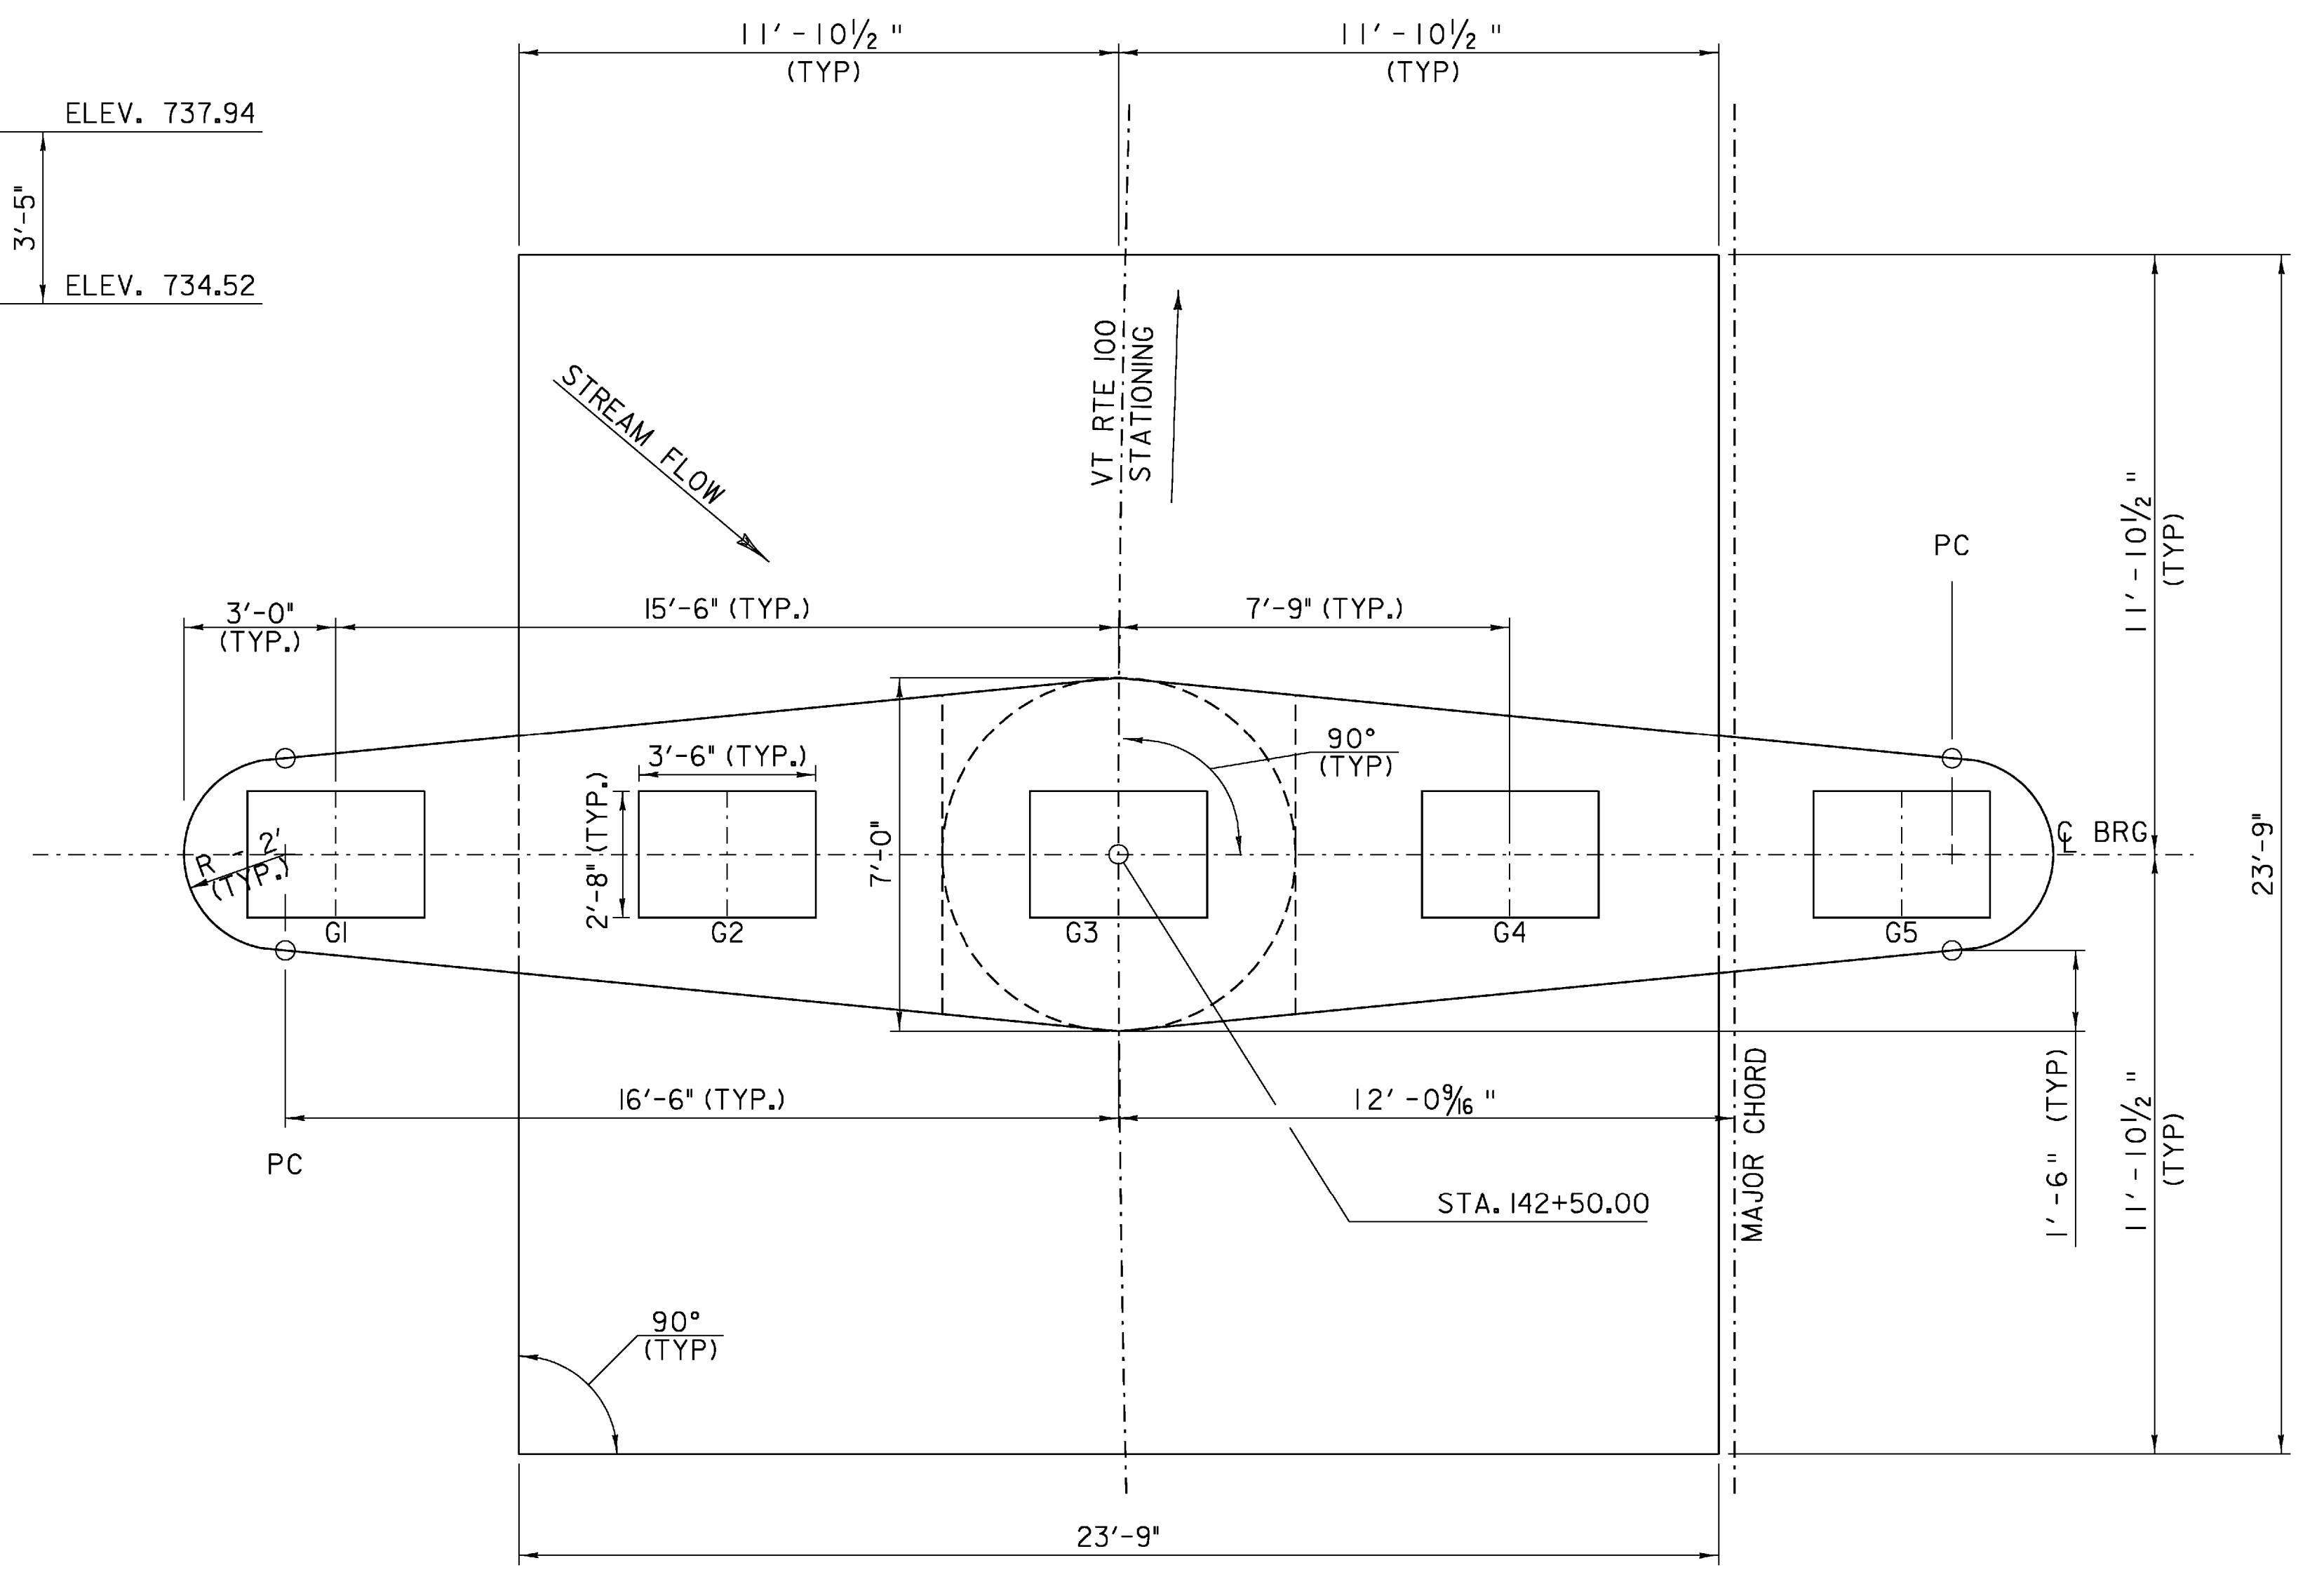

PIER PLAN

PIER DIMENSION PLAN

PROJECT NAME:	STOCKBRIDGE	FILE NAME:	/78f238/s+r5/sf238sub.dgn	PLOT DATE:	06-FEB-2008
PROJECT NUMBER:	BRF 013-4(21)	PROJECT LEADER:	K. HIGGINS	DRAWN BY:	R. PELLETT
		DESIGNED BY:	T. FILLBACH	CHECKED BY:	J. LACROIX
			sf238ppe.1	SHEET 91	OF 144

