


EB = 11.04 ft<sup>2</sup>  
 CE = 12.95 ft<sup>2</sup>

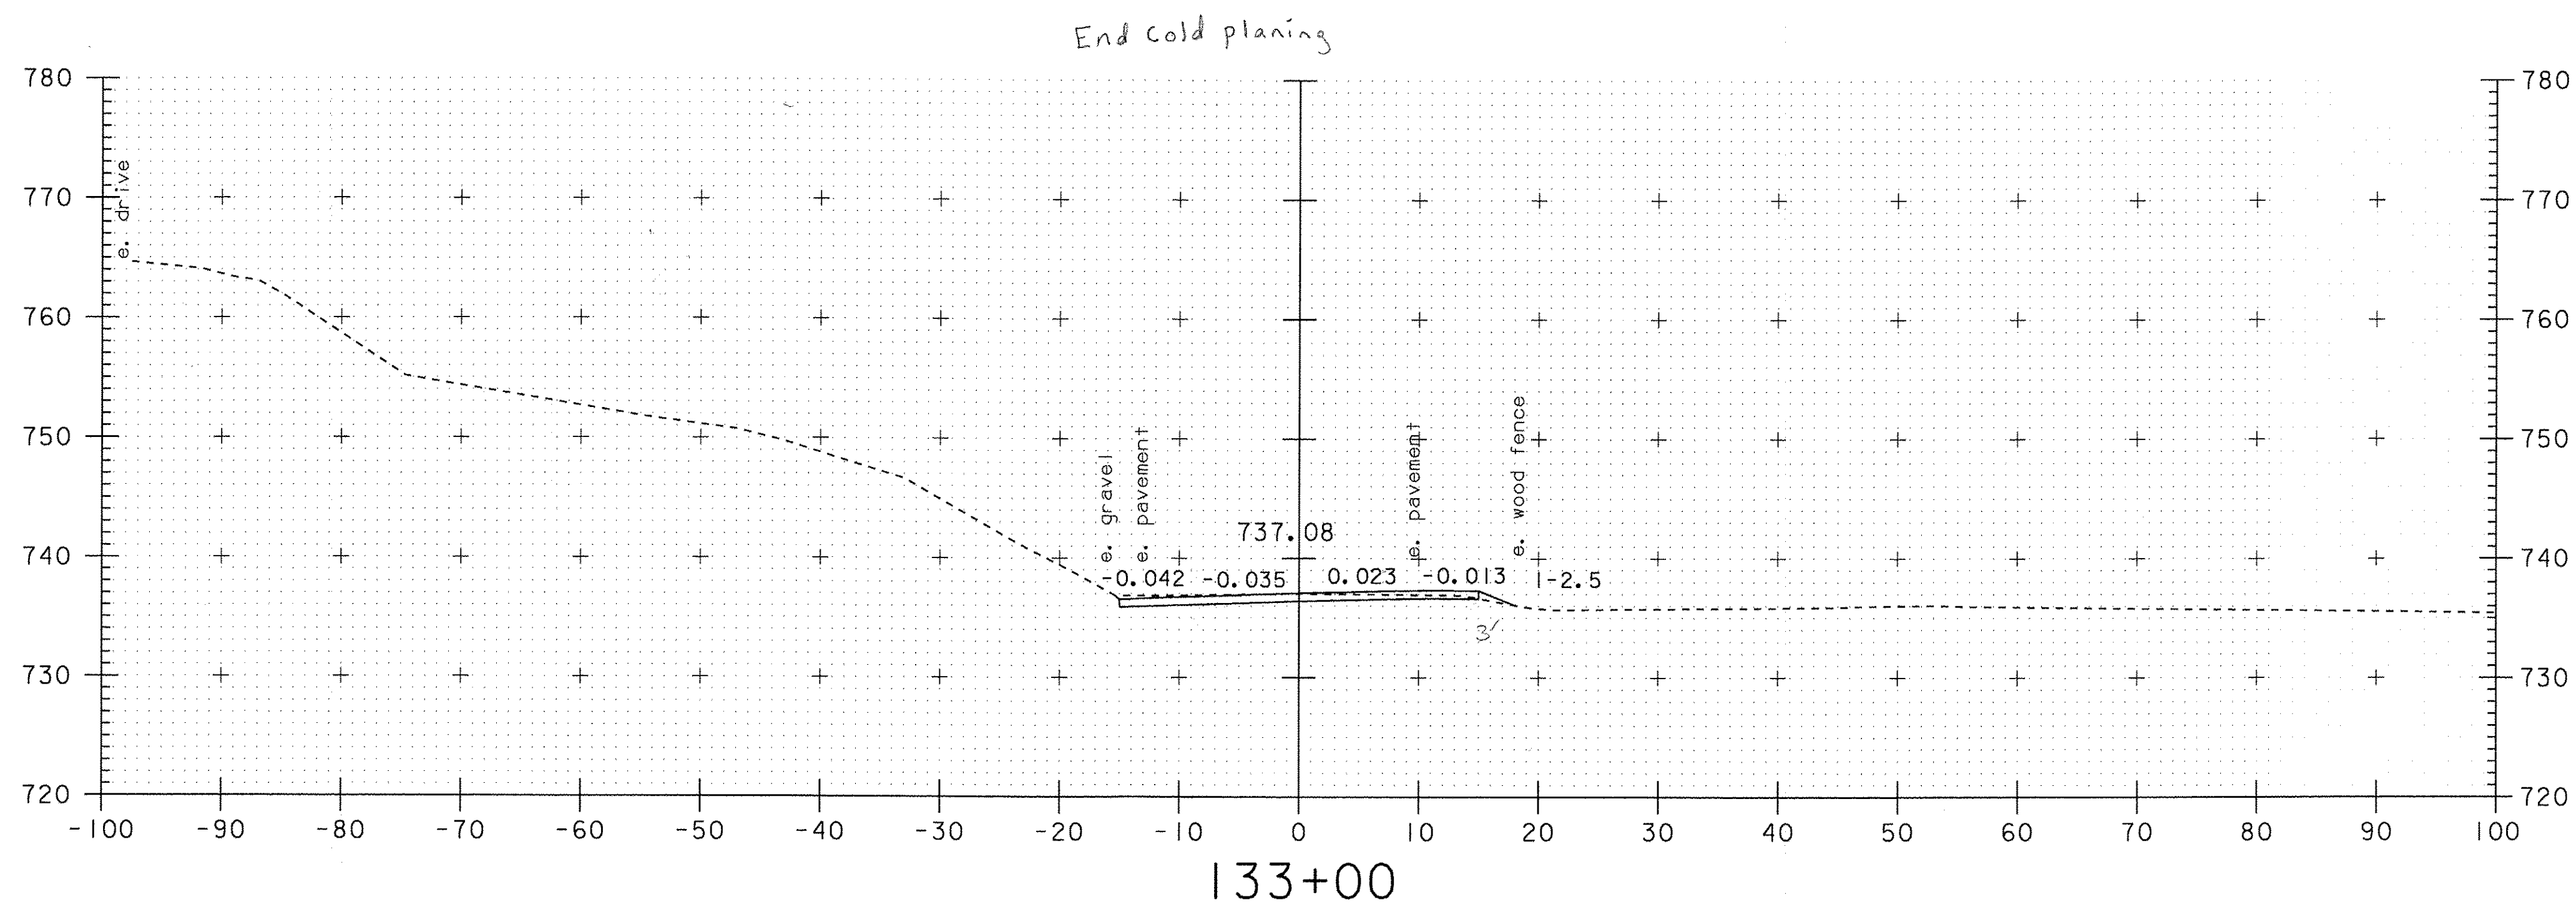

EB = 0.84 ft<sup>2</sup>  
 Common Ex = 12.45 ft<sup>2</sup>

NRC 12/16/09  
 DGB 1/19/11

**MAINLINE CROSS SECTIONS  
 STA. 133+00 - STA. 133+50**

PROJECT NAME-	STOCKBRIDGE
PROJECT NUMBER-	BRF 013-4 (21)
FILE NAME-	/78f238/str5/df268xs1.dgn
PROJECT LEADER-	K. HIGGINS
DESIGNED BY-	T. SUMNER
df238x02.i	
PLOT DATE-	06-FEB-2008
DRAWN BY-	G. SHANGRAW
CHECKED BY-	T. FILLBACH
SHEET	110 OF 144

