


Common 98.38 ft²
 EB 0.286 ft² + 15.67 ft² = 16.0 ft²
 DGCS 76.71 ft²
 Underdrain 6.61 ft²

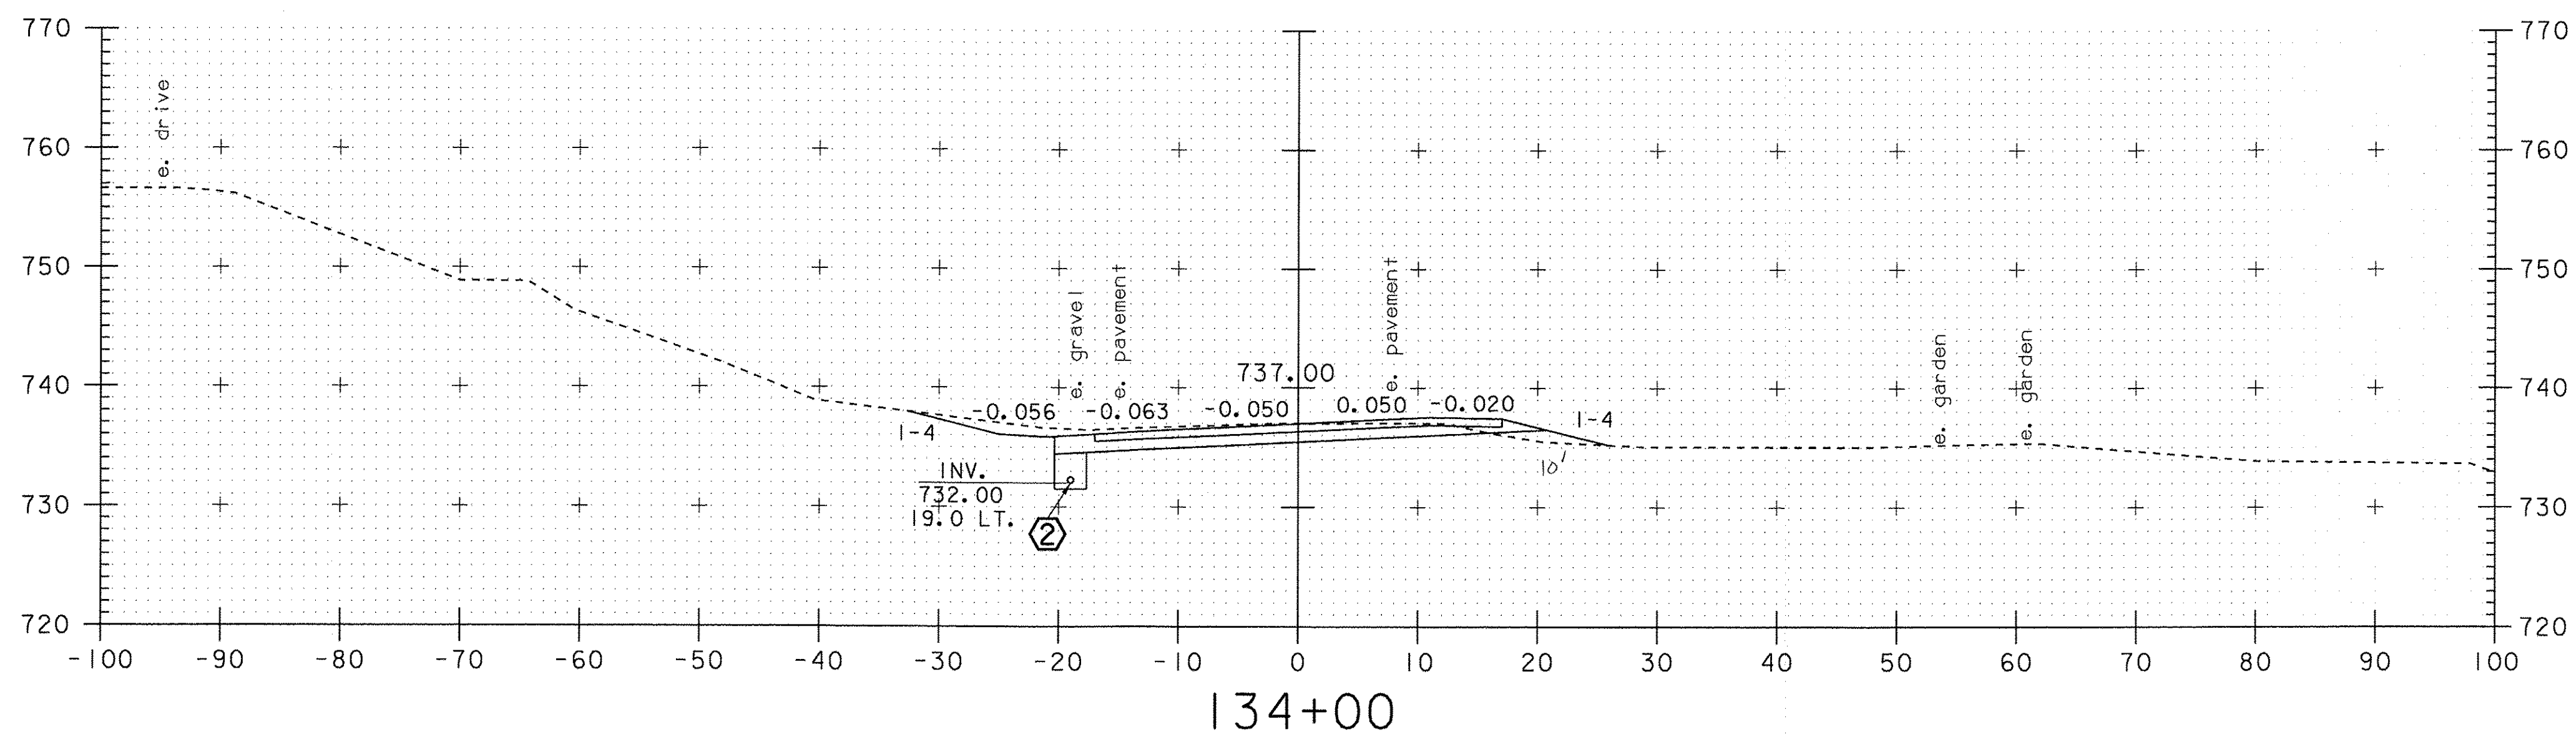

Common ex 62.03 ft²
 EB 5.28 ft²
 DGCS 35.55 ft²
 Underdrain 7.99 ft²

NRC 12/16/09
 DEB 1/19/11

**MAINLINE CROSS SECTIONS
 STA. 134+00 - STA. 134+50**

PROJECT NAME-	STOCKBRIDGE
PROJECT NUMBER-	BRF 013-4 (21)
FILE NAME- /78f238/str5/df268xs1.dgn	PLOT DATE- 06-FEB-2008
PROJECT LEADER- K. HIGGINS	DRAWN BY- G. SHANGRAW
DESIGNED BY- T. SUMNER	CHECKED BY- T. FILLBACH
df238x03.1	SHEET 111 OF 144

