


Common ex 9.72 + 65.72 = 75.44 ft²
 EB 17.81 ft²
 DGCS 95.82 ft²
 Underdrain 7.84 ft²
 Sand 48.46 ft²

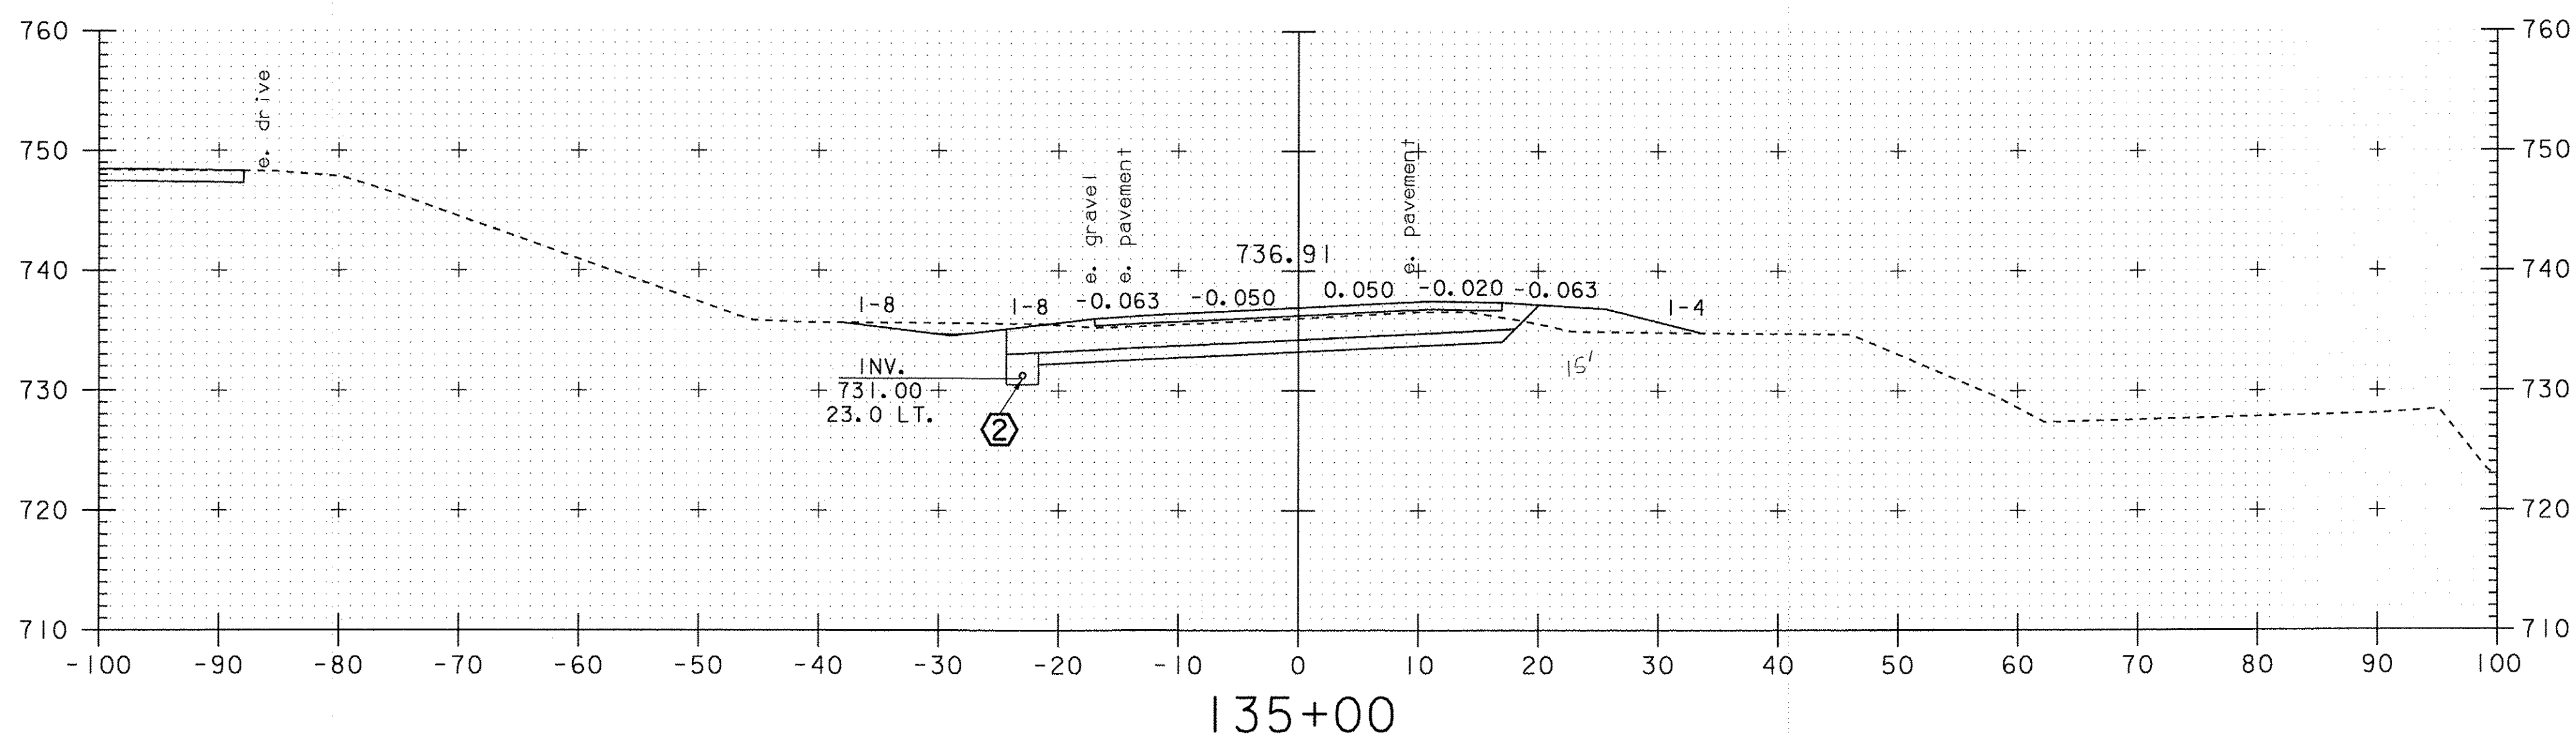


Common ex 8.52 + 112.96 = 121.48 ft²
 EB 19.14 ft²
 DGCS 82.67 ft²
 Underdrain 6.89 ft²
 Sand 39.24 ft²

NRC 12/16/09
 DGB 1/19/11

**MAINLINE CROSS SECTIONS
 STA. 135+00 - STA. 135+50**

PROJECT NAME-	STOCKBRIDGE
PROJECT NUMBER-	BRF 013-4 (21)
FILE NAME- /78f238/str5/df268xsl.dgn	PLOT DATE- 06-FEB-2008
PROJECT LEADER- K. HIGGINS	DRAWN BY- G. SHANGRAW
DESIGNED BY- T. SUMNER	CHECKED BY- T. FILLBACH
df238x04.1	SHEET 112 OF 144

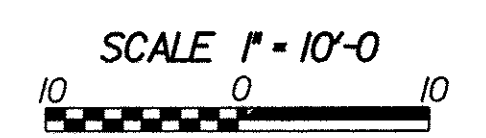

135+00
 END APPROACH
 BEGIN PROJECT