


Common ex 2.32 ft²
 EB 143.62 ft²
 DGCS 91.35 ft²
 underdrain 11.24 ft²
 Sand 52.76 ft²

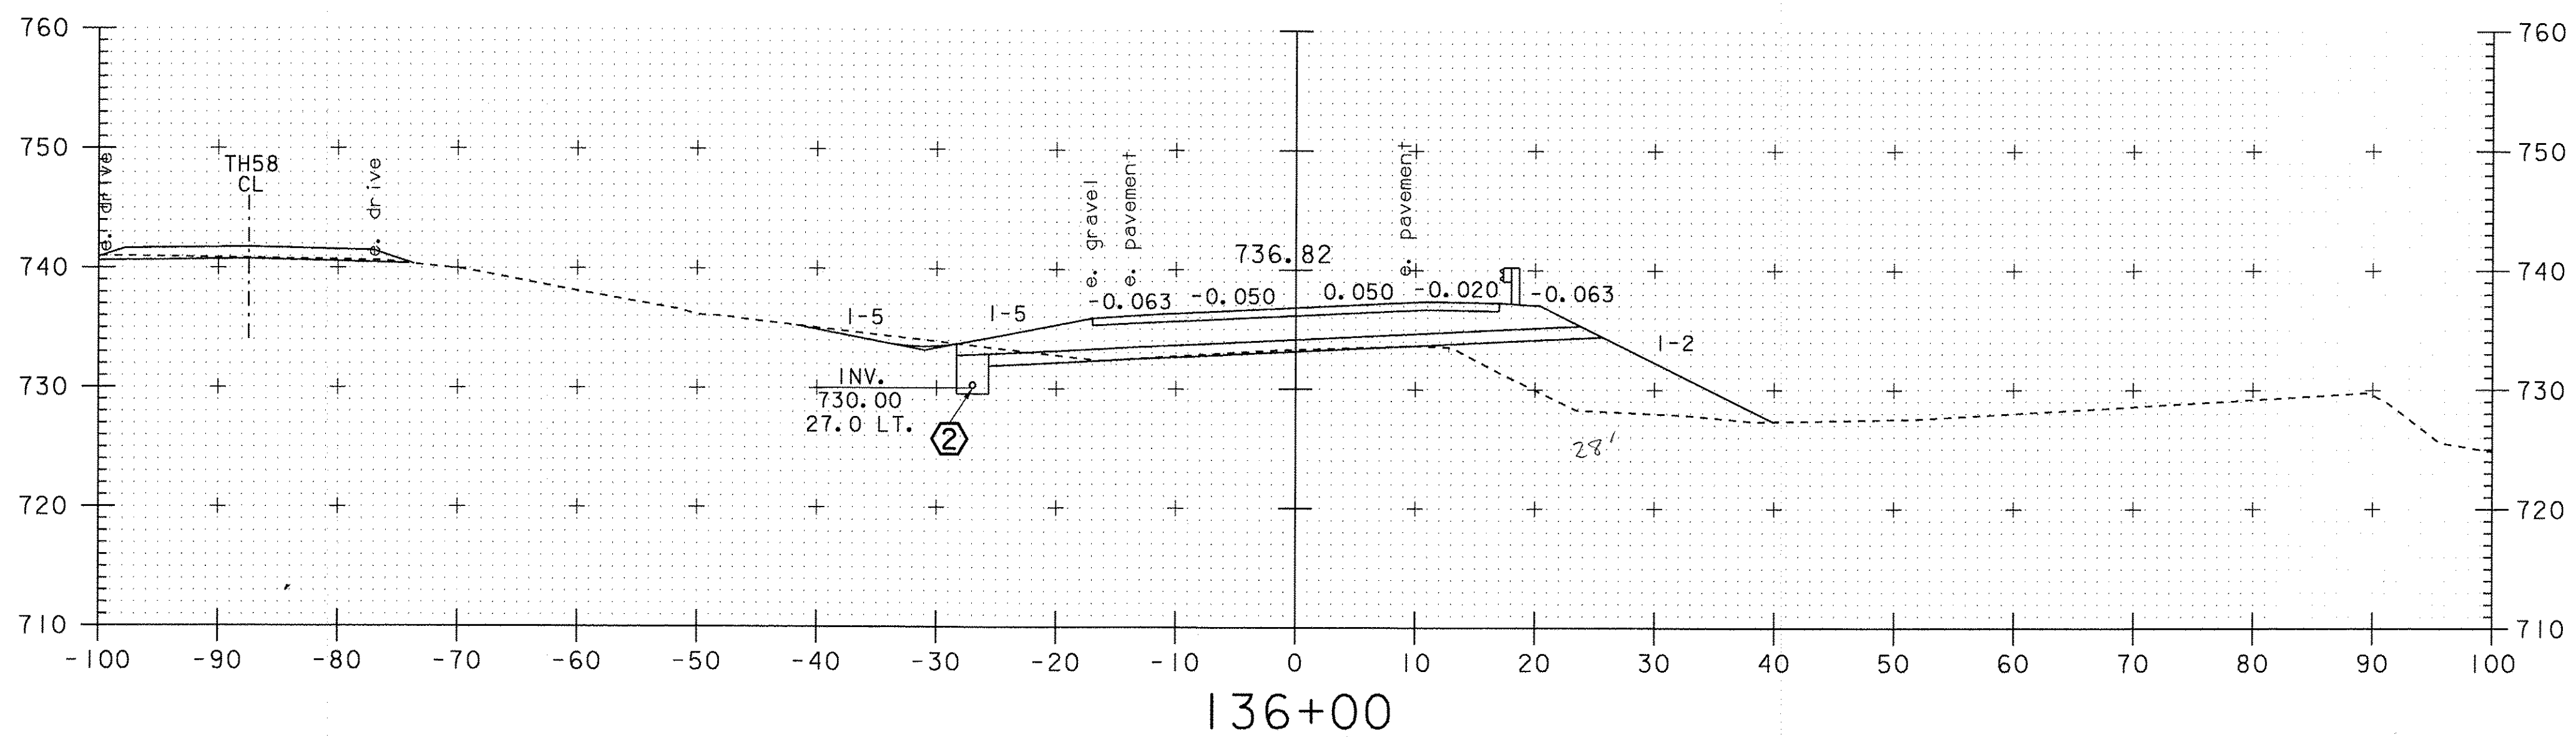

Common ex 5.74 + 9.17 = 14.91 ft²
 EB 91.13 ft²
 DGCS 97.28 ft²
 underdrain 8.79 ft²
 Sand 50.50 ft²

NRC 12/16/09
 DGB 1/19/11

**MAINLINE CROSS SECTIONS
 STA. 136+00 - STA. 136+50**

SCALE 1" = 10'-0"

PROJECT NAME-	STOCKBRIDGE
PROJECT NUMBER-	BRF 013-4 (21)
FILE NAME-	/78f238/str5/df268xsl.dgn
PROJECT LEADER-	K. HIGGINS
DESIGNED BY-	T. SUMNER
df238x05.i	
PLOT DATE-	06-FEB-2008
DRAWN BY-	G. SHANGRAW
CHECKED BY-	T. FILLBACH
SHEET	113 OF 144