


Common ex 0 ft²
 EB 594.02 ft²
 DGCS 91.81 ft²
 Sand 53.70 ft²

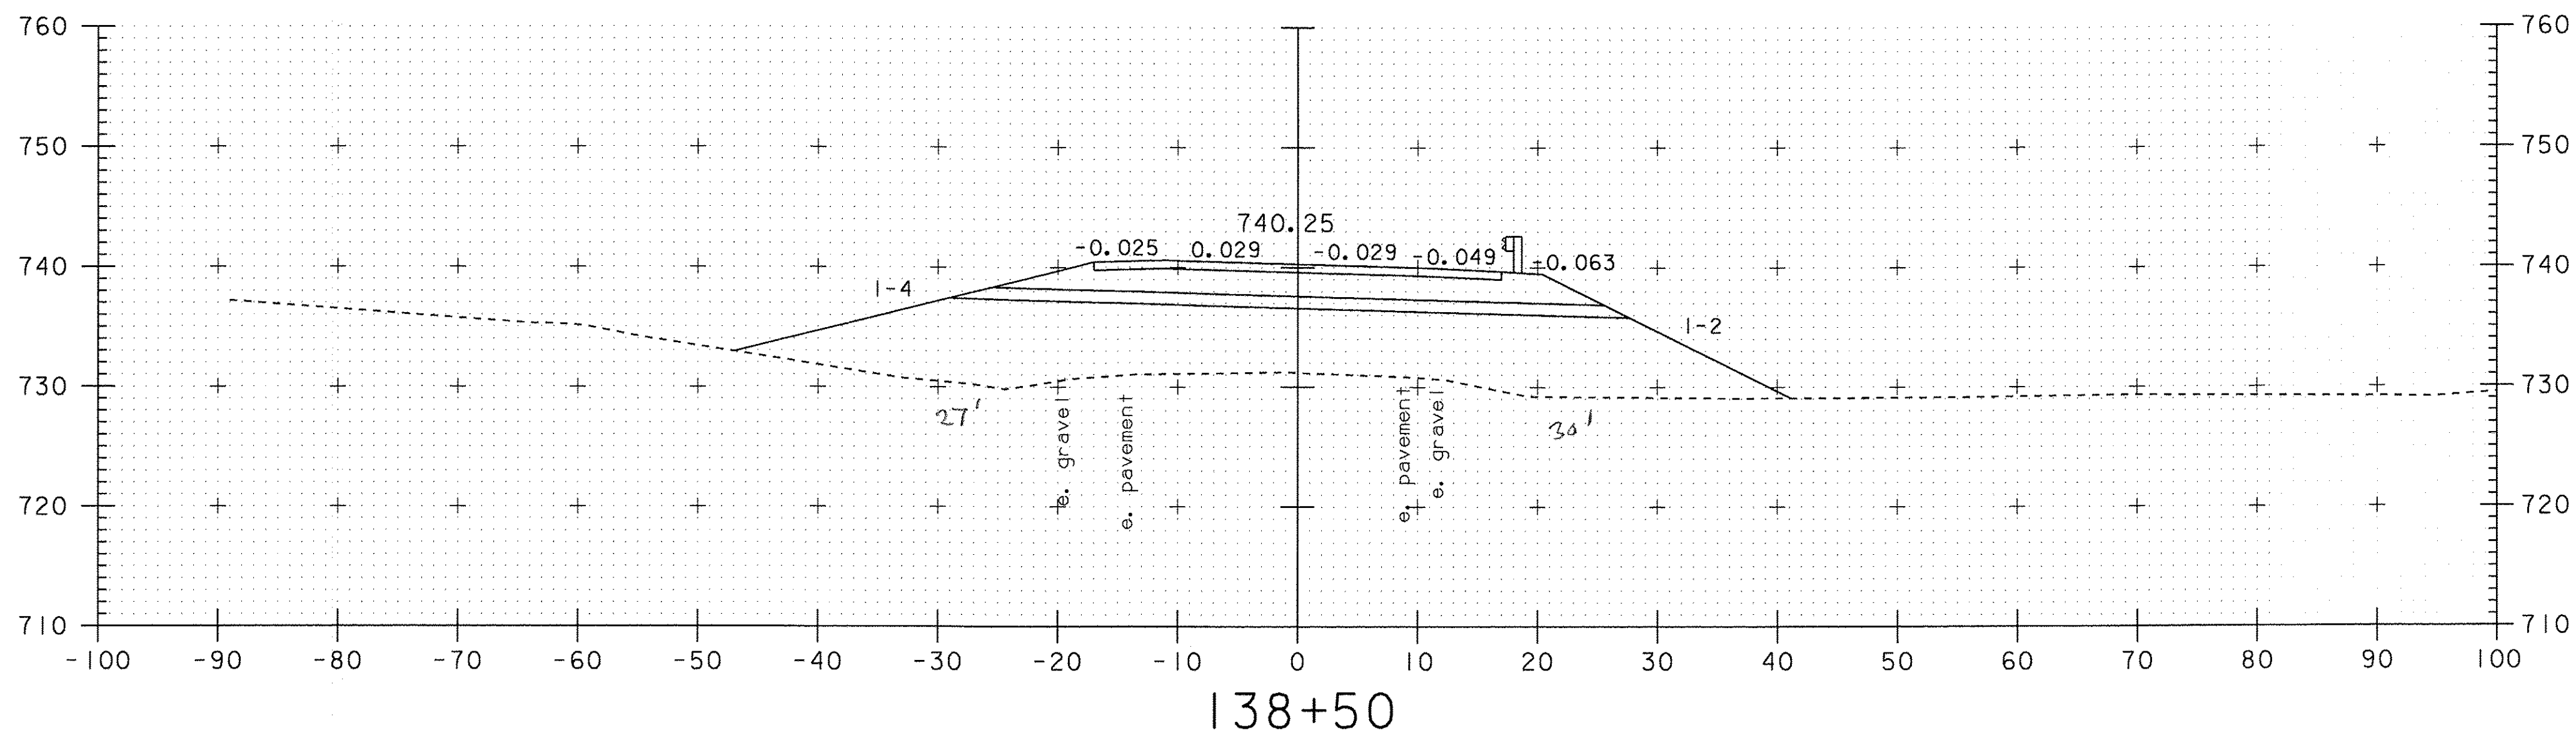

Common ex 0 ft²
 EB 459.18 ft²
 DGCS 91.47 ft²
 Sand 53.91 ft²

NRC12/15/09
 D/B 1/15/11

**MAINLINE CROSS SECTIONS
 STA. 138 + 50 - STA. 139 + 00**

PROJECT NAME-	STOCKBRIDGE
PROJECT NUMBER-	BRF 013-4 (21)
FILE NAME- /78f238/str5/df268xsl.dgn	PLOT DATE- 06-FEB-2008
PROJECT LEADER- K. HIGGINS	DRAWN BY- G. SHANGRAW
DESIGNED BY- T. SUMNER	CHECKED BY- T. FILLBACH
df238x08.i	SHEET 116 OF 144

