


Common Ex 0 ft²
 EB 965.29 ft²
 DGCS 92.12 ft²
 Sand 53.57 ft²

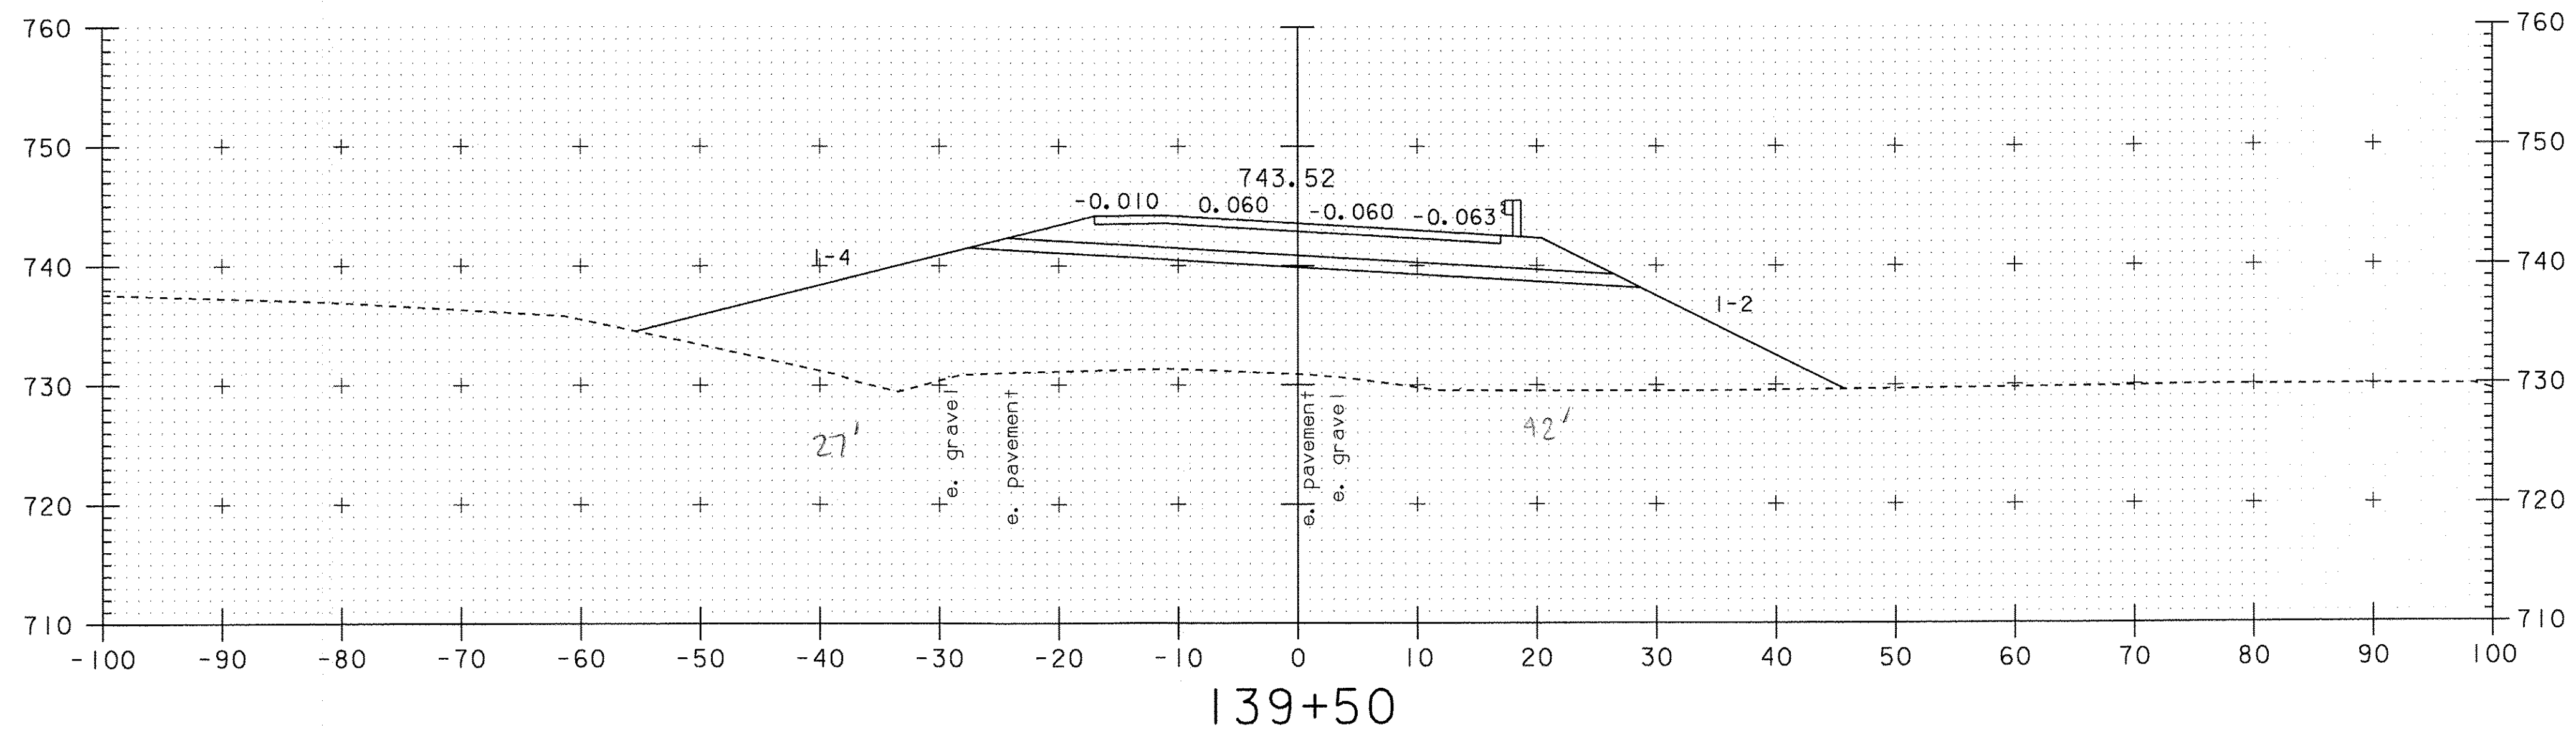

Common Ex 0 ft²
 EB 775.37 ft²
 DGCS 92.12
 Sand 53.57 ft²

NRC 12/16/09
 060/11/11

**MAINLINE CROSS SECTIONS
 STA. 139+50 - STA. 140+00**

PROJECT NAME-	STOCKBRIDGE
PROJECT NUMBER-	BRF 013-4 (21)
FILE NAME- /78f238/str5/df268xs1.dgn	PLOT DATE- 06-FEB-2008
PROJECT LEADER- K. HIGGINS	DRAWN BY- G. SHANGRAW
DESIGNED BY- T. SUMNER	CHECKED BY- T. FILLBACH
df238x09.1	SHEET 117 OF 144

