



Common Ex 125.77 ft² w/o Ditch
 EB 0 ft²
 DGCS 79.19 ft²
 Sand 58.48 ft²
 SD 26.75 ft²

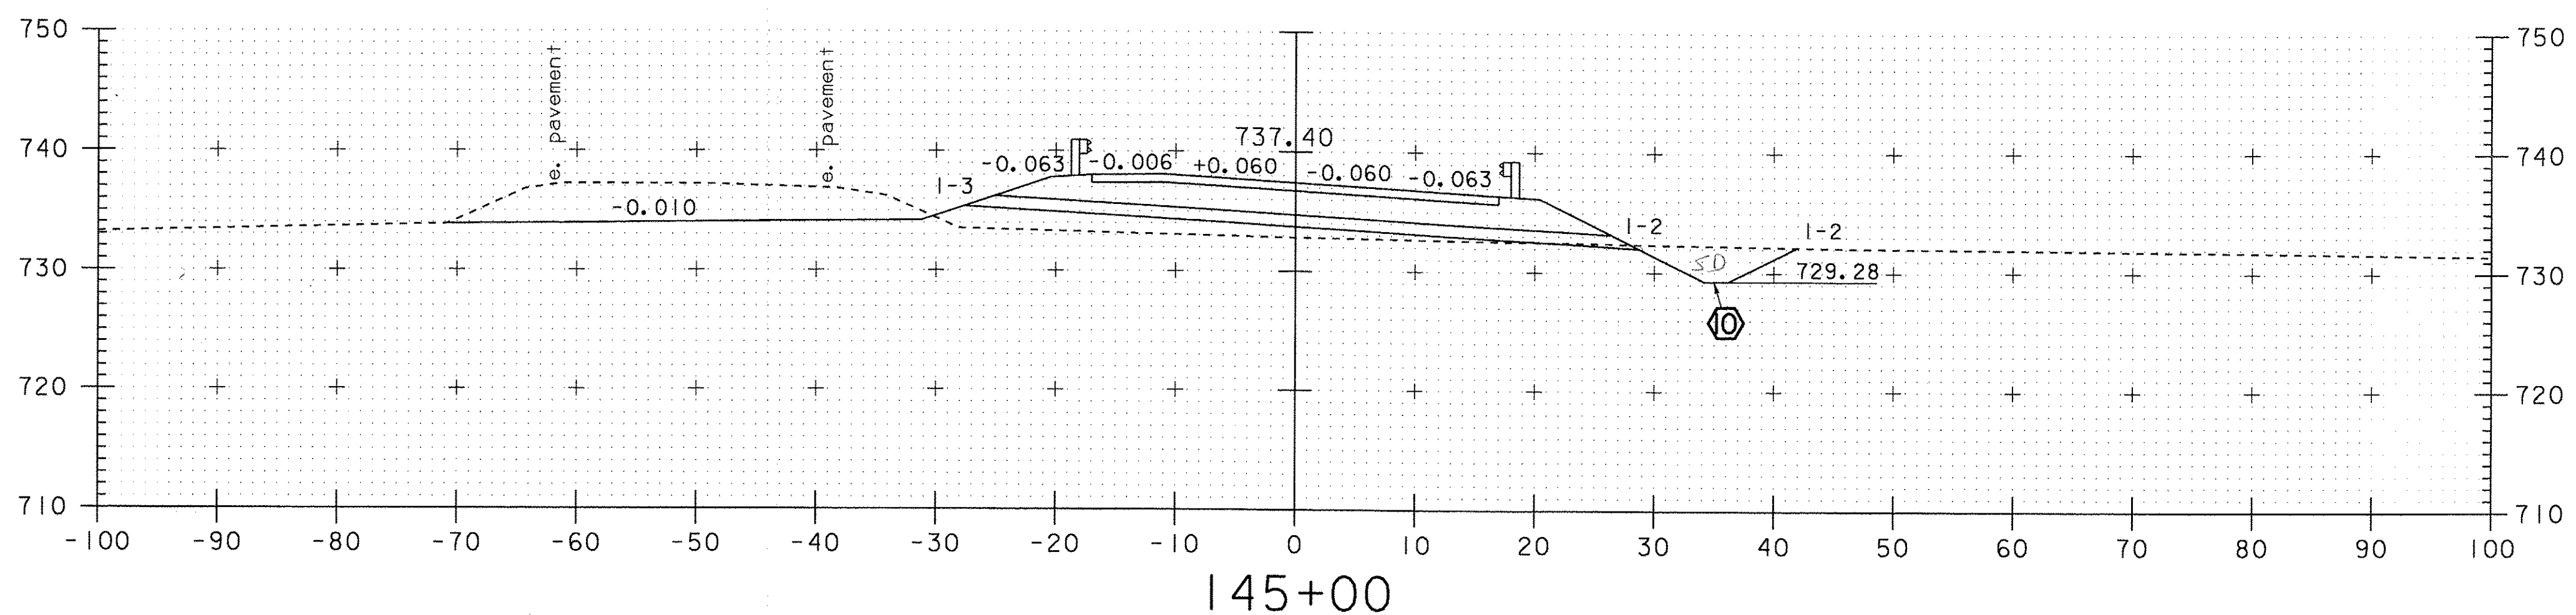

Common Ex 104.78 + 1.25 ft²
 EB 50.94 ft²
 DGCS 95.19 ft²
 Sand 54.04 ft²
 SD 23.58 ft²

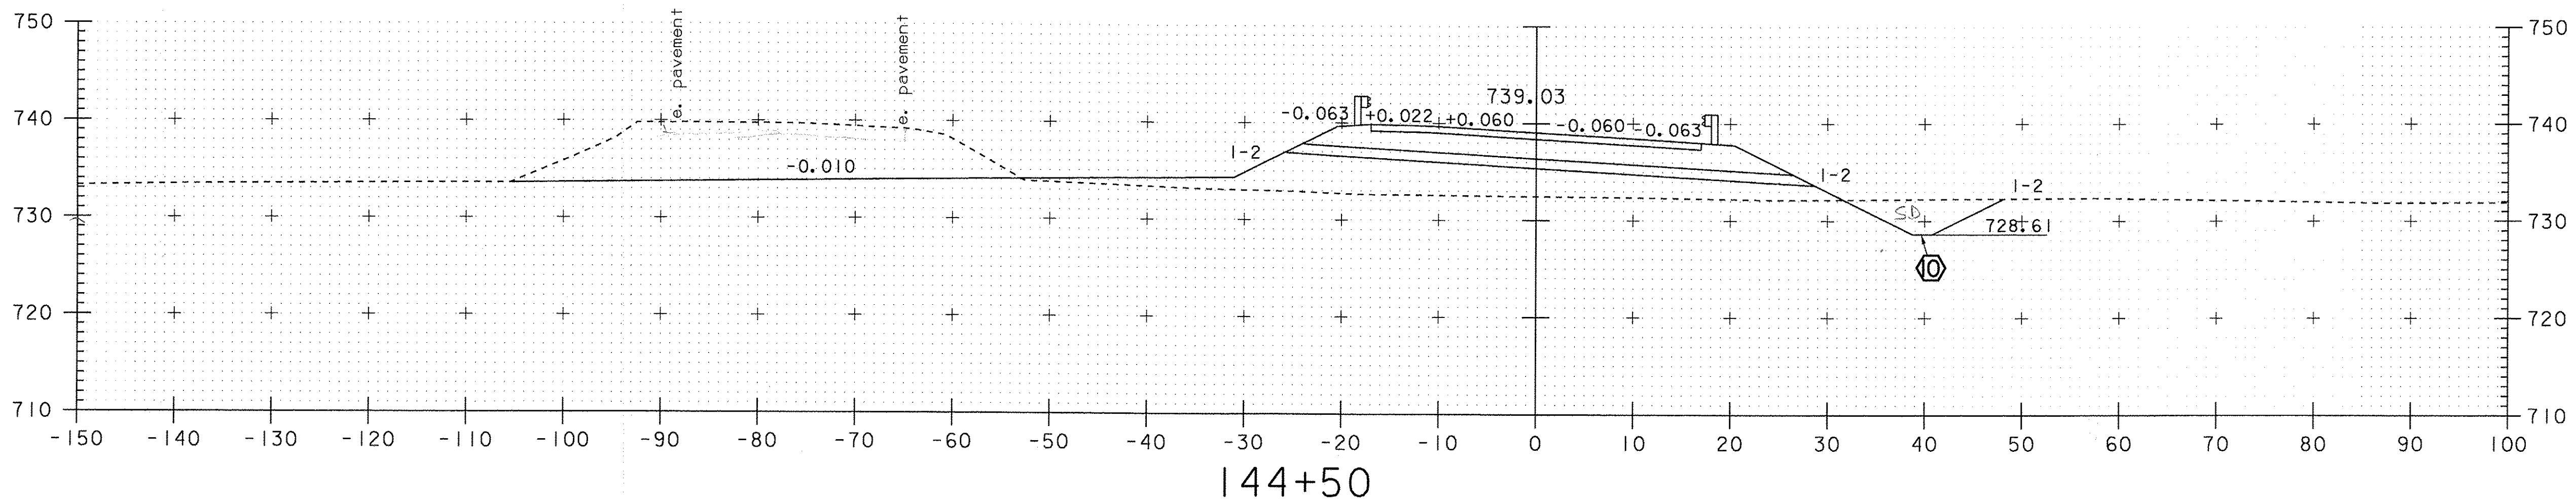

Common Ex 232.05 ft²
 EB 186.83 ft²
 DGCS 95.64 ft²
 Sand 52.46 ft²
 SD 33.49 ft²

NRC 12/16/09
 DBB 1/19/11

MAINLINE CROSS SECTIONS STA. 144 + 50 - STA. 145 + 50

SCALE 1" = 10'-0"

PROJECT NAME-	STOCKBRIDGE	PLOT DATE-	06-FEB-2008
PROJECT NUMBER-	BRF 013-4 (21)	DRAWN BY-	G. SHANGRAW
FILE NAME-	/78 f238/str5/df268xsl.dgn	CHECKED BY-	T. FILLBACH
PROJECT LEADER-	K. HIGGINS	SHEET	122 OF 144
DESIGNED BY-	T. SUMNER		