



Common Ex 50.27 ft²
 EB 0 ft²
 DGCS 29.39 ft²

147+00
 146+75 END PROJECT
 BEGIN APPROACH
 End Sand box cut at 146+75
 Begin DGCS Taper at 146+75

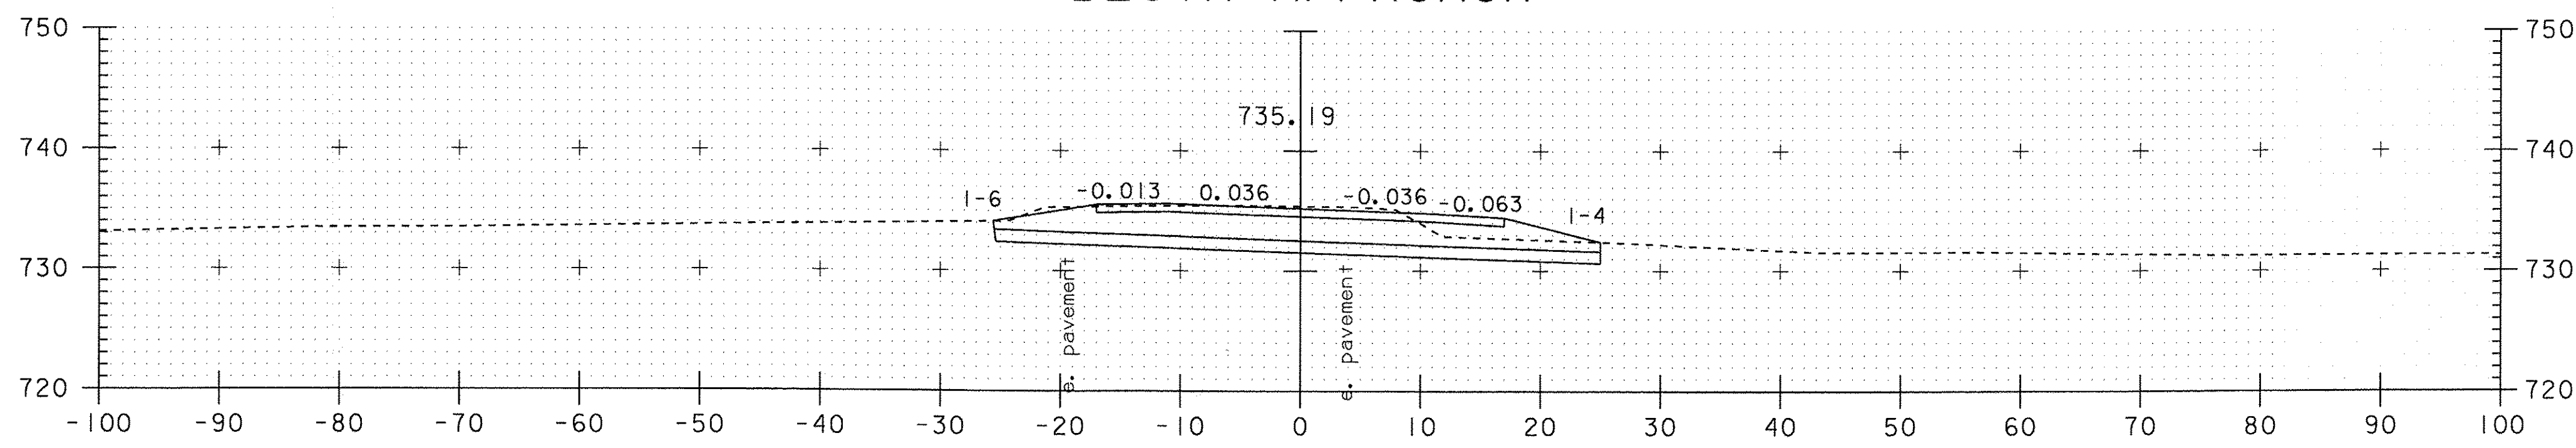

Common Ex 149.29 ft²
 EB 0 ft²
 DGCS 93.19 ft²
 Sand 50.50 ft²

146+50

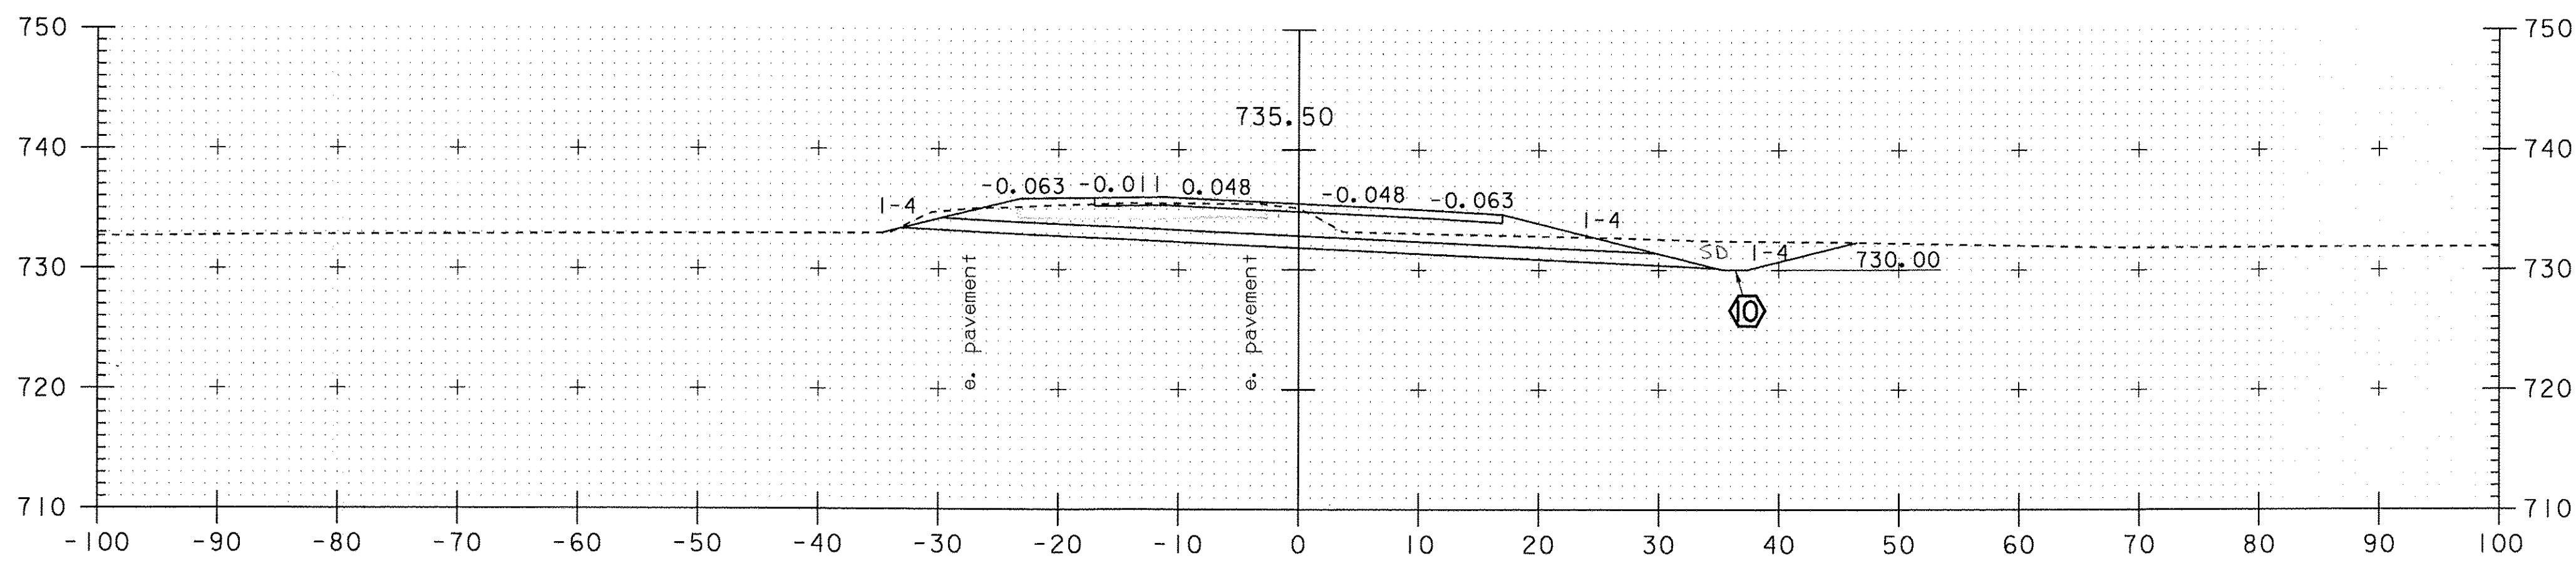

Common Ex 143.49 ft²
 EB 0.10 ft²
 DGCS 102.98 ft²
 Sand 63.78 ft²
 SD 28.62 ft²

146+00

NRC 12/16/09
 DGB 1/19/11

**MAINLINE CROSS SECTIONS
 STA. 146+00 - STA. 147+00**

SCALE 1" = 10'-0"

PROJECT NAME-	STOCKBRIDGE
PROJECT NUMBER-	BRF 013-4 (21)
FILE NAME- /78 f238/str5/df268xs1.dgn	PLOT DATE- 06-FEB-2008
PROJECT LEADER- K. HIGGINS	DRAWN BY- G. SHANGRAW
DESIGNED BY- T. SUMNER	CHECKED BY- T. FILLBACH
df238x15.1	SHEET 123 OF 144