


WIDTH TRANSITION

**MAINLINE CROSS SECTIONS
STA. 147+50 - STA. 148+50**

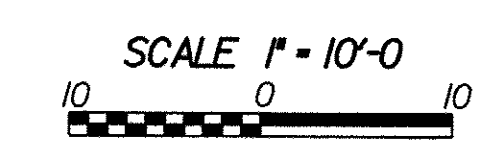

PROJECT NAME-	STOCKBRIDGE
PROJECT NUMBER-	BRF 013-4 (21)
FILE NAME- /78f238/s+5/df268x1.dgn	PLOT DATE- 06-FEB-2008
PROJECT LEADER- K. HIGGINS	DRAWN BY- G. SHANGRAW
DESIGNED BY- T. SUMNER	CHECKED BY- T. FILLBACH
df238x16.1	SHEET 124 OF 144