


Common EX = $664.49 + 126.15 = 791.29 \text{ ft}^2$
 EB = 0 ft^2
 DGCS = 50.53 ft^2
 Sand = 78.42 ft^2
 Agg Surface = 8.17 ft^2

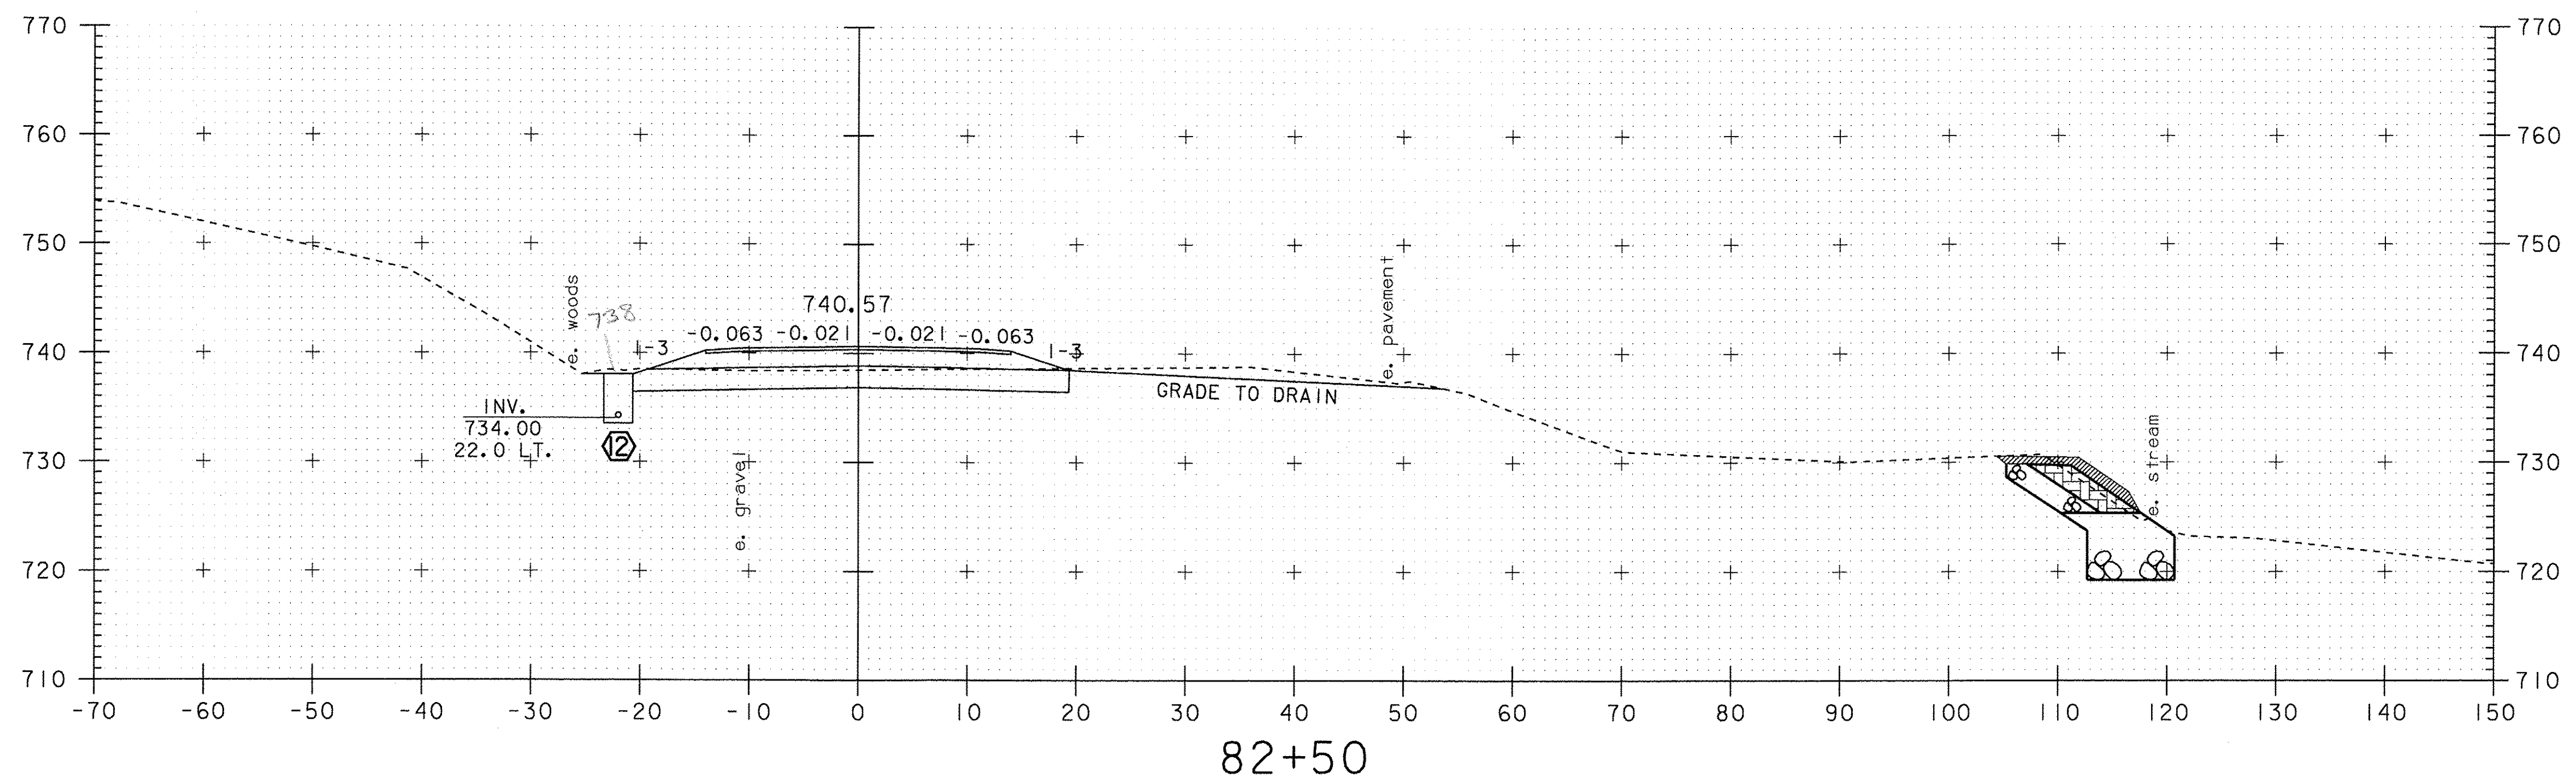

Common EX = $1.68 + 21.48 + 72.65 = 95.81 \text{ ft}^2$
 EB = 0 ft^2
 DGCS = 50.53 ft^2
 Sand = 79.72 ft^2
 Agg Surface = 8.17 ft^2

NRC 12/16/09
 DCB 1/19/11

**TIMBER RIVER ROAD
 CROSS SECTIONS
 STA. 82+50 - STA. 83+00**

SCALE 1" = 10'-0"

PROJECT NAME-	STOCKBRIDGE
PROJECT NUMBER-	BRF 013-4 (21)
FILE NAME-	/78f238/str5/df268xs1.dgn
PROJECT LEADER-	K. HIGGINS
DESIGNED BY-	T. SUMNER
df23rx2.i	
PLOT DATE-	06-FEB-2008
DRAWN BY-	C. SHANGRAW
CHECKED BY-	T. FILLBACH
SHEET	130 OF 144