


PLOTTED: 6/25/2008  
3:40:18 PM

BY: MKreidel

SHIPMENT 01 PM&ENG: 5004327 PRC

60

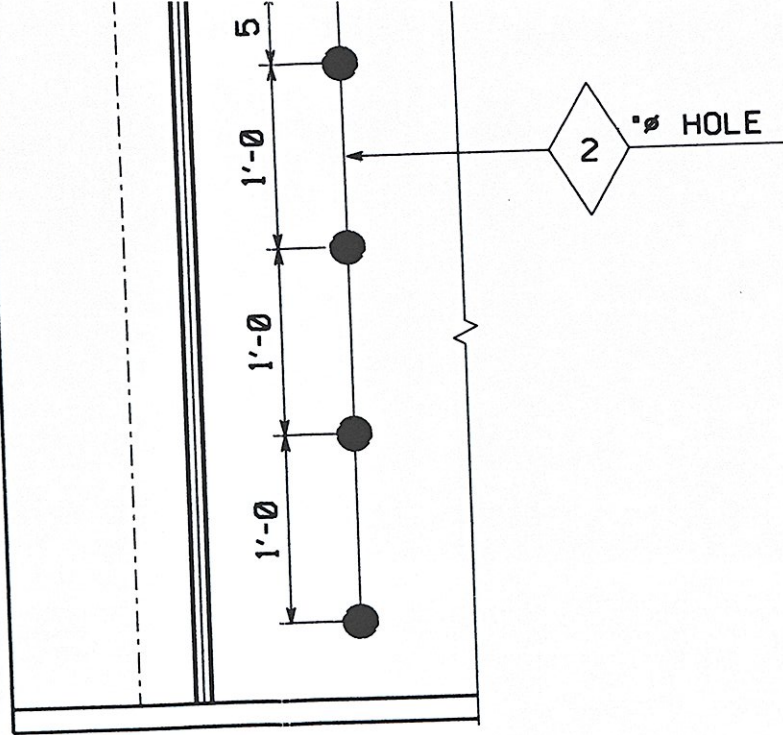

**WEB LAYOUT**  
(ABUT. 1 SHOWN, ABUT. 2 SIMILAR)

LINE	RADIUS	A	B	C	D	E	F
G1	524'-9 <sup>5</sup> / <sub>8</sub>	82'-1 <sup>9</sup> / <sub>16</sub>	32'-2 <sup>15</sup> / <sub>16</sub>	32'-2 <sup>15</sup> / <sub>16</sub>	82'-1 <sup>15</sup> / <sub>16</sub>	.0179	.0371
G2	517'-0 <sup>5</sup> / <sub>8</sub>	81'-5 <sup>13</sup> / <sub>16</sub>	31'-2 <sup>7</sup> / <sub>16</sub>	31'-2 <sup>3</sup> / <sub>8</sub>	81'-6 <sup>3</sup> / <sub>16</sub>	.0182	.0377
G3	509'-3 <sup>5</sup> / <sub>8</sub>	79'-7 <sup>13</sup> / <sub>16</sub>	31'-4 <sup>1</sup> / <sub>8</sub>	31'-4 <sup>3</sup> / <sub>16</sub>	79'-8 <sup>3</sup> / <sub>16</sub>	.0185	.0383
G4	501'-6 <sup>5</sup> / <sub>8</sub>	78'-2 <sup>3</sup> / <sub>16</sub>	31'-0 <sup>7</sup> / <sub>8</sub>	31'-0 <sup>7</sup> / <sub>8</sub>	78'-3 <sup>3</sup> / <sub>16</sub>	.0187	.0389
G5	493'-9 <sup>5</sup> / <sub>8</sub>	77'-3 <sup>3</sup> / <sub>8</sub>	30'-4 <sup>1</sup> / <sub>8</sub>	30'-4 <sup>1</sup> / <sub>16</sub>	77'-3 <sup>3</sup> / <sub>4</sub>	.0190	.0395