
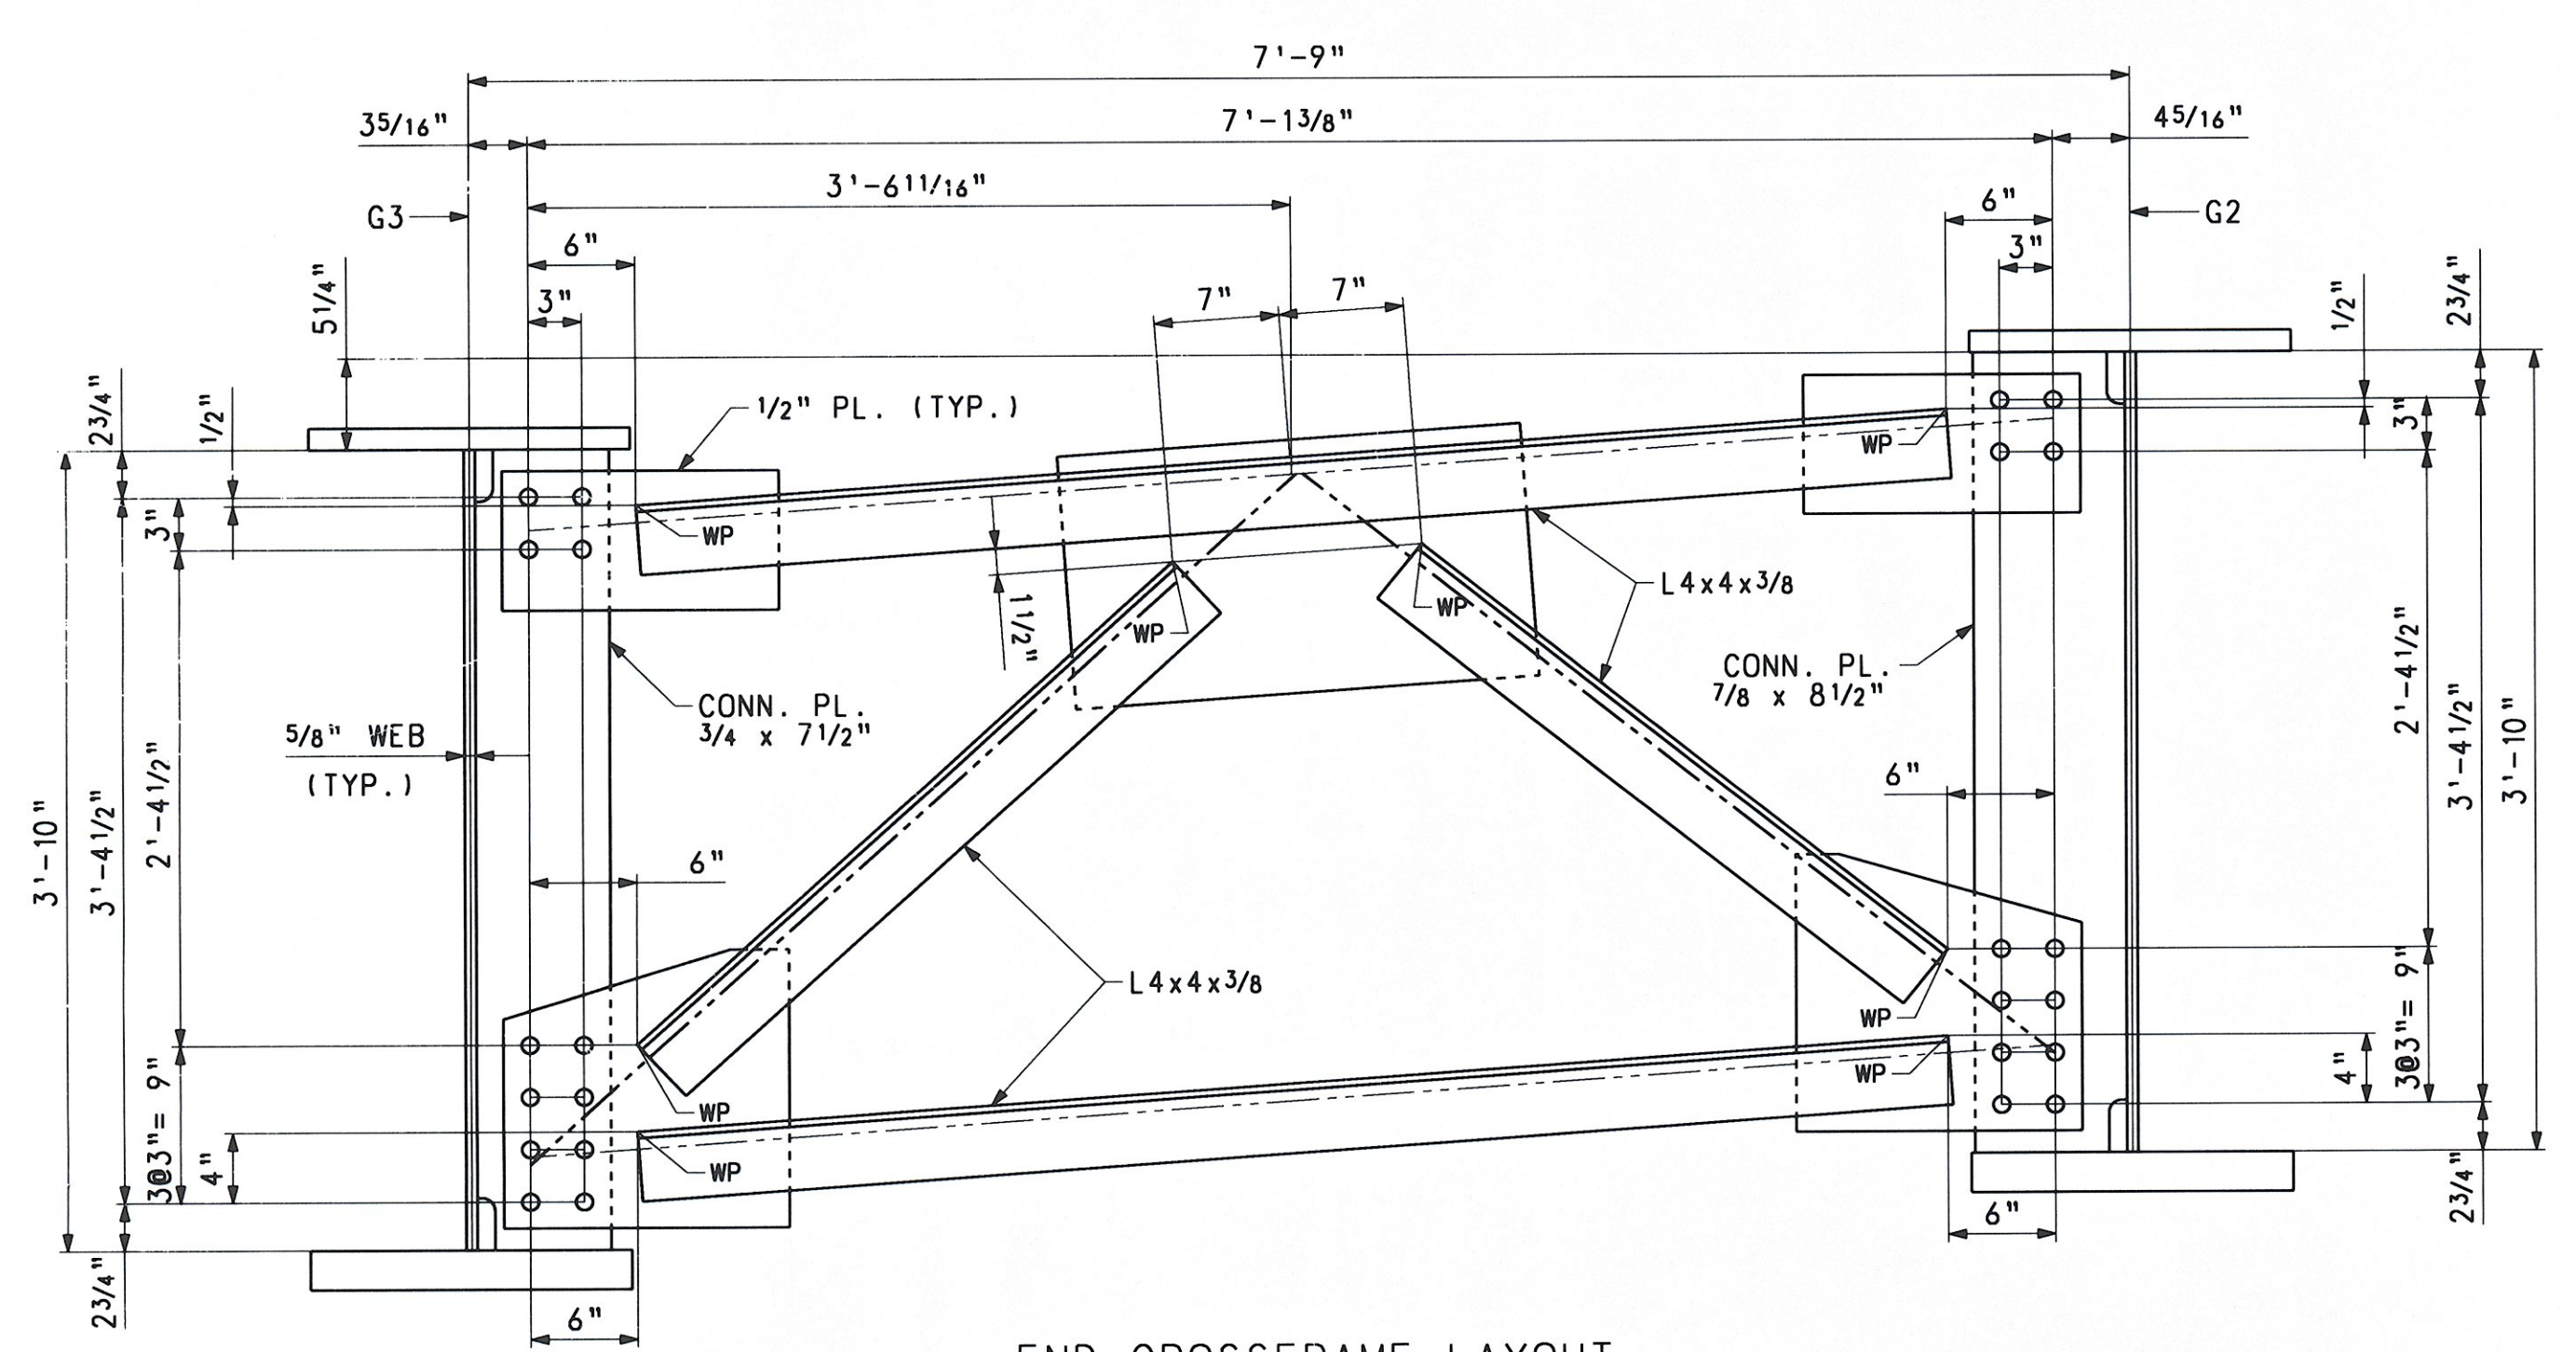
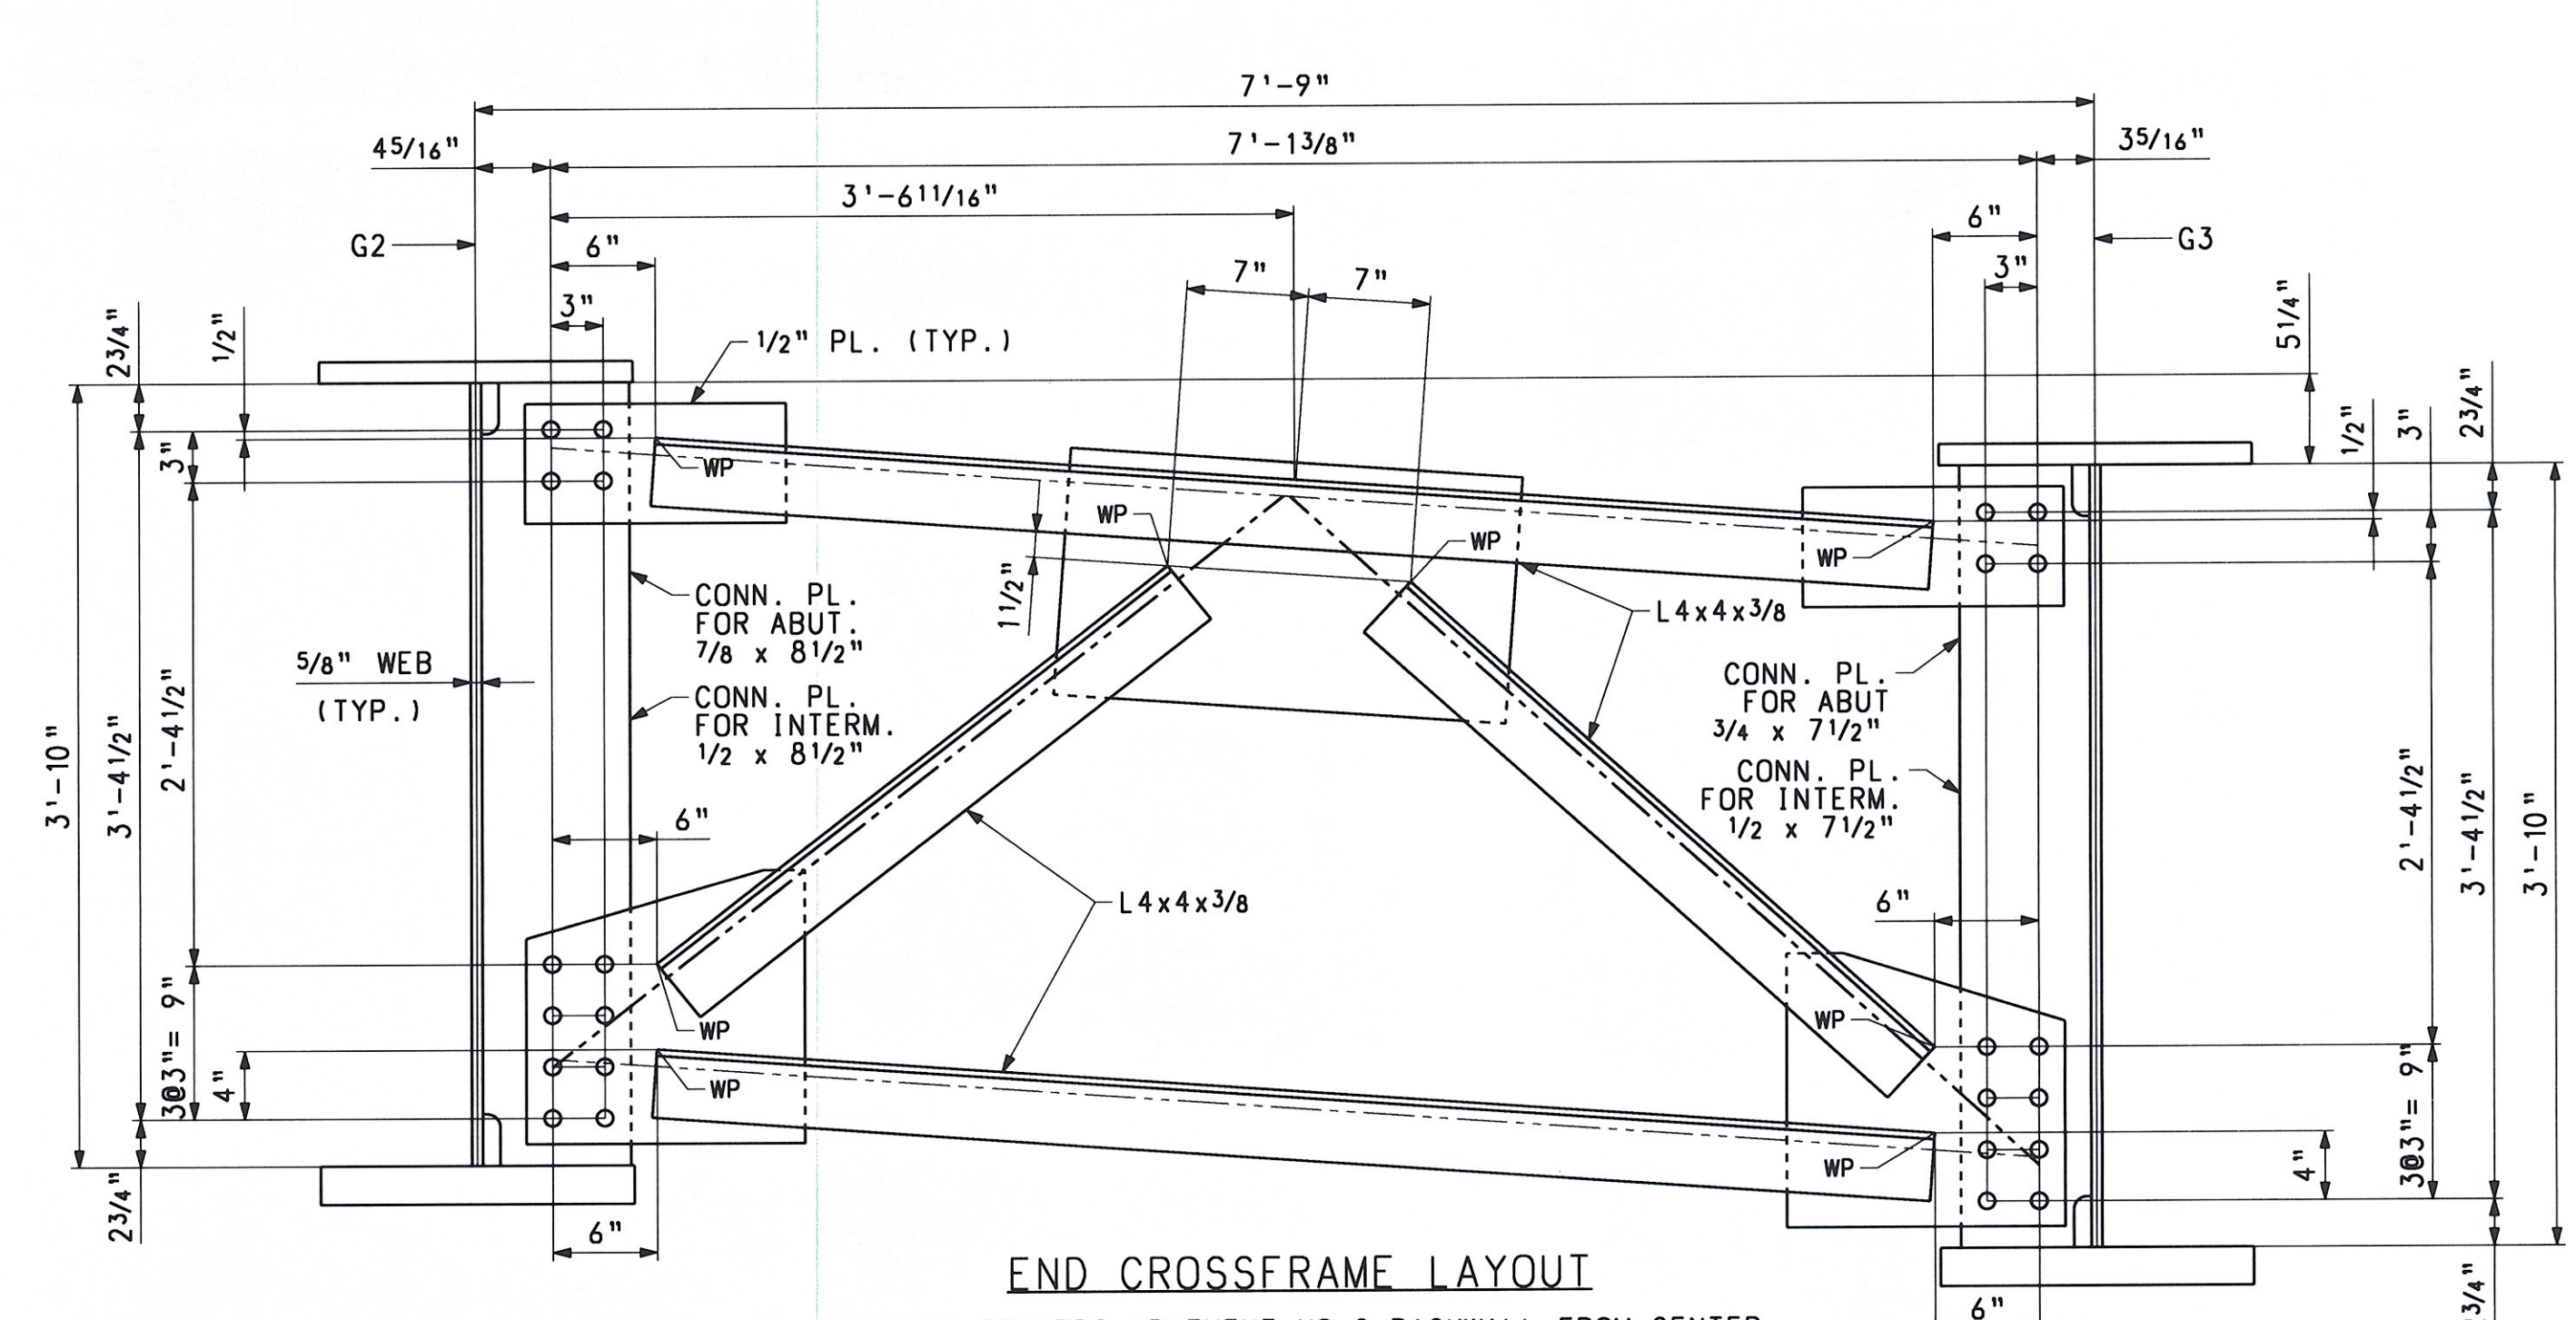


SHIPMENT 1 PMENG: XXXXXXXX PRD: XXXXXXXX SHIPRECT: XXXXXXXX

PLOTTED: 06/26/08 15:45:01 P1: Mfr:el:de

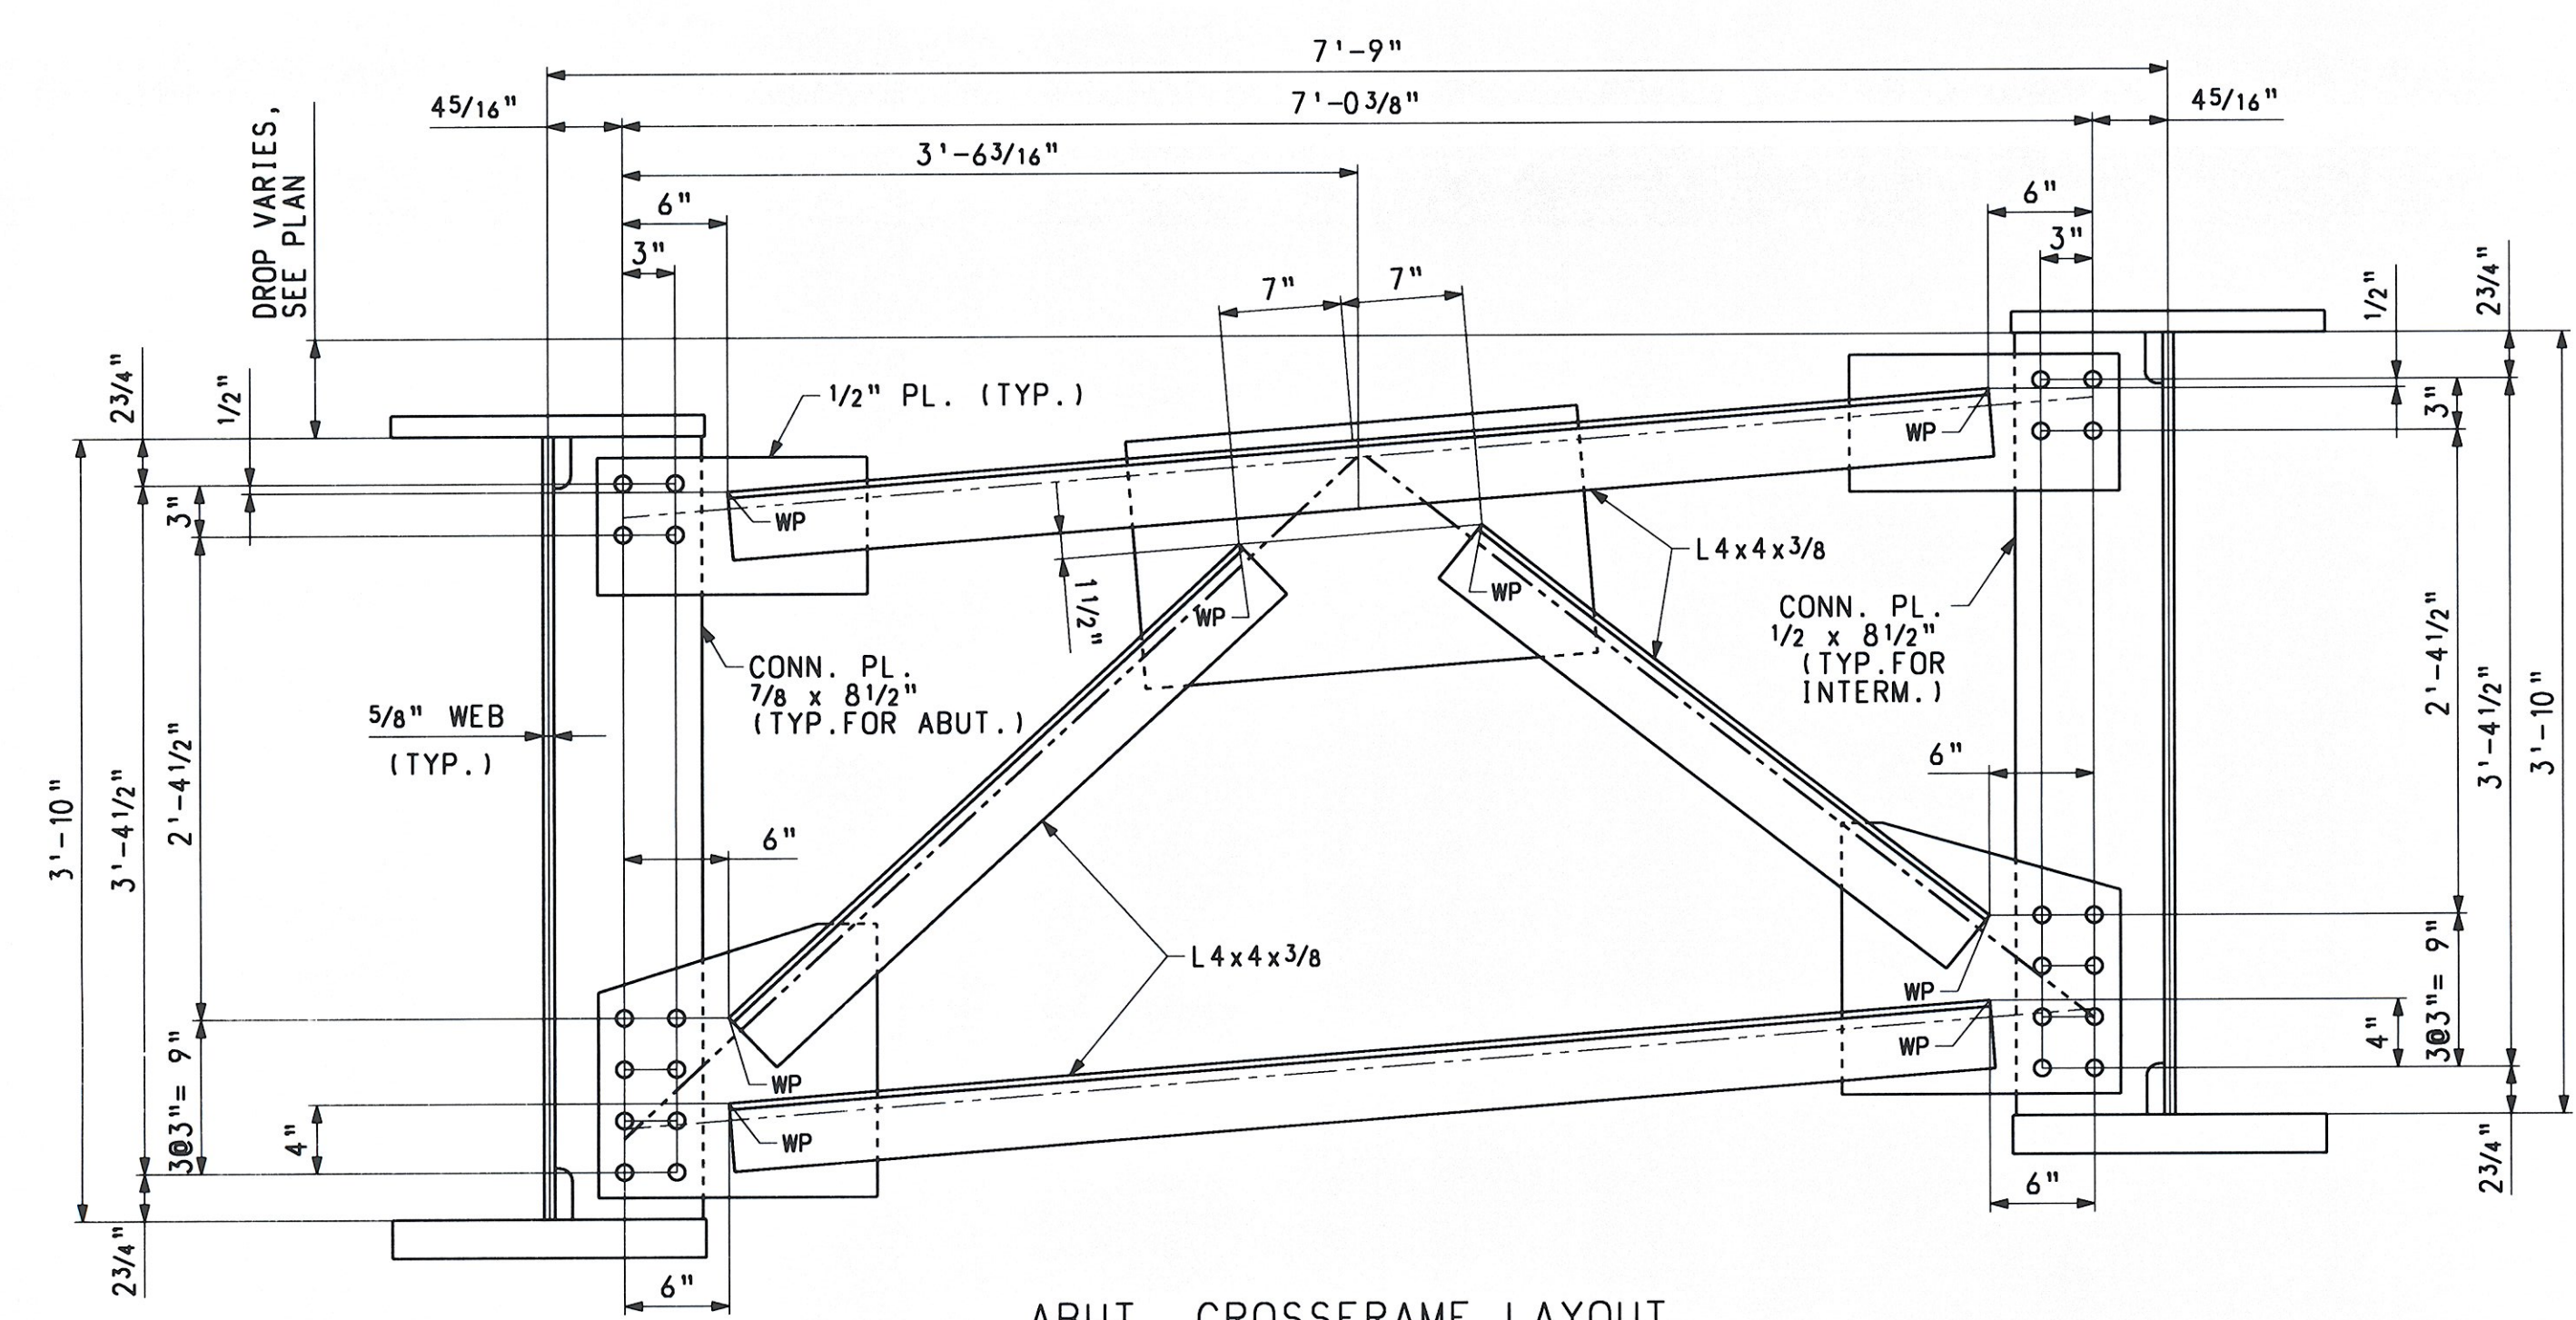

**NOTES:**  
FOR NOTES, SEE DRAWING WS1.  
WORK THIS DRAWING WITH WS1.

**\*\*NOTE\*\***  
THE PURPOSE OF THIS DRAWING IS TO COORDINATE GEOMETRIC CONTROL INFORMATION. THIS DRAWING IS SUBMITTED FOR INFORMATION ONLY AND IS NOT INTENDED FOR SHOP FABRICATION. THIS DRAWING IS FOR REFERENCE ONLY. APPROVAL IS NOT REQUIRED.

RECEIVED  
CK'D BY: JEL OK'D BY: JEL  
AUG 18 2008  
RESUBMIT APPROVED  
BY: KMH DATE: 8/19/08

NO.	REVISION	BY	CHK'D	DATE
HOLES	15/16" Ø			
BOLTS	NONE			
COATING	NONE			
CODE(S)	STATE OF VERMONT			
SCALE	N.T.S.			
STATE CONT. OR REF. NO.	PROJECT NO. (STP) BR	FED. AID PROJ. NO.		
GENERAL CONTRACTOR	WINTERSET, INC.	HESI PROJ. MGR	DEB KUPRES	
SHPMNT	1	DRAWING MANAGER	KREIDER (IH)	MADE BY
STATE	VT	HESI PROJECT NUMBER	S-1080077	HESI STRUCT. ID
		HESI PROJ. NUMBER	A	DRAWING NUMBER
			CS	DATE
				6/17/08
				TD1 OF TD3