




ENGLISH

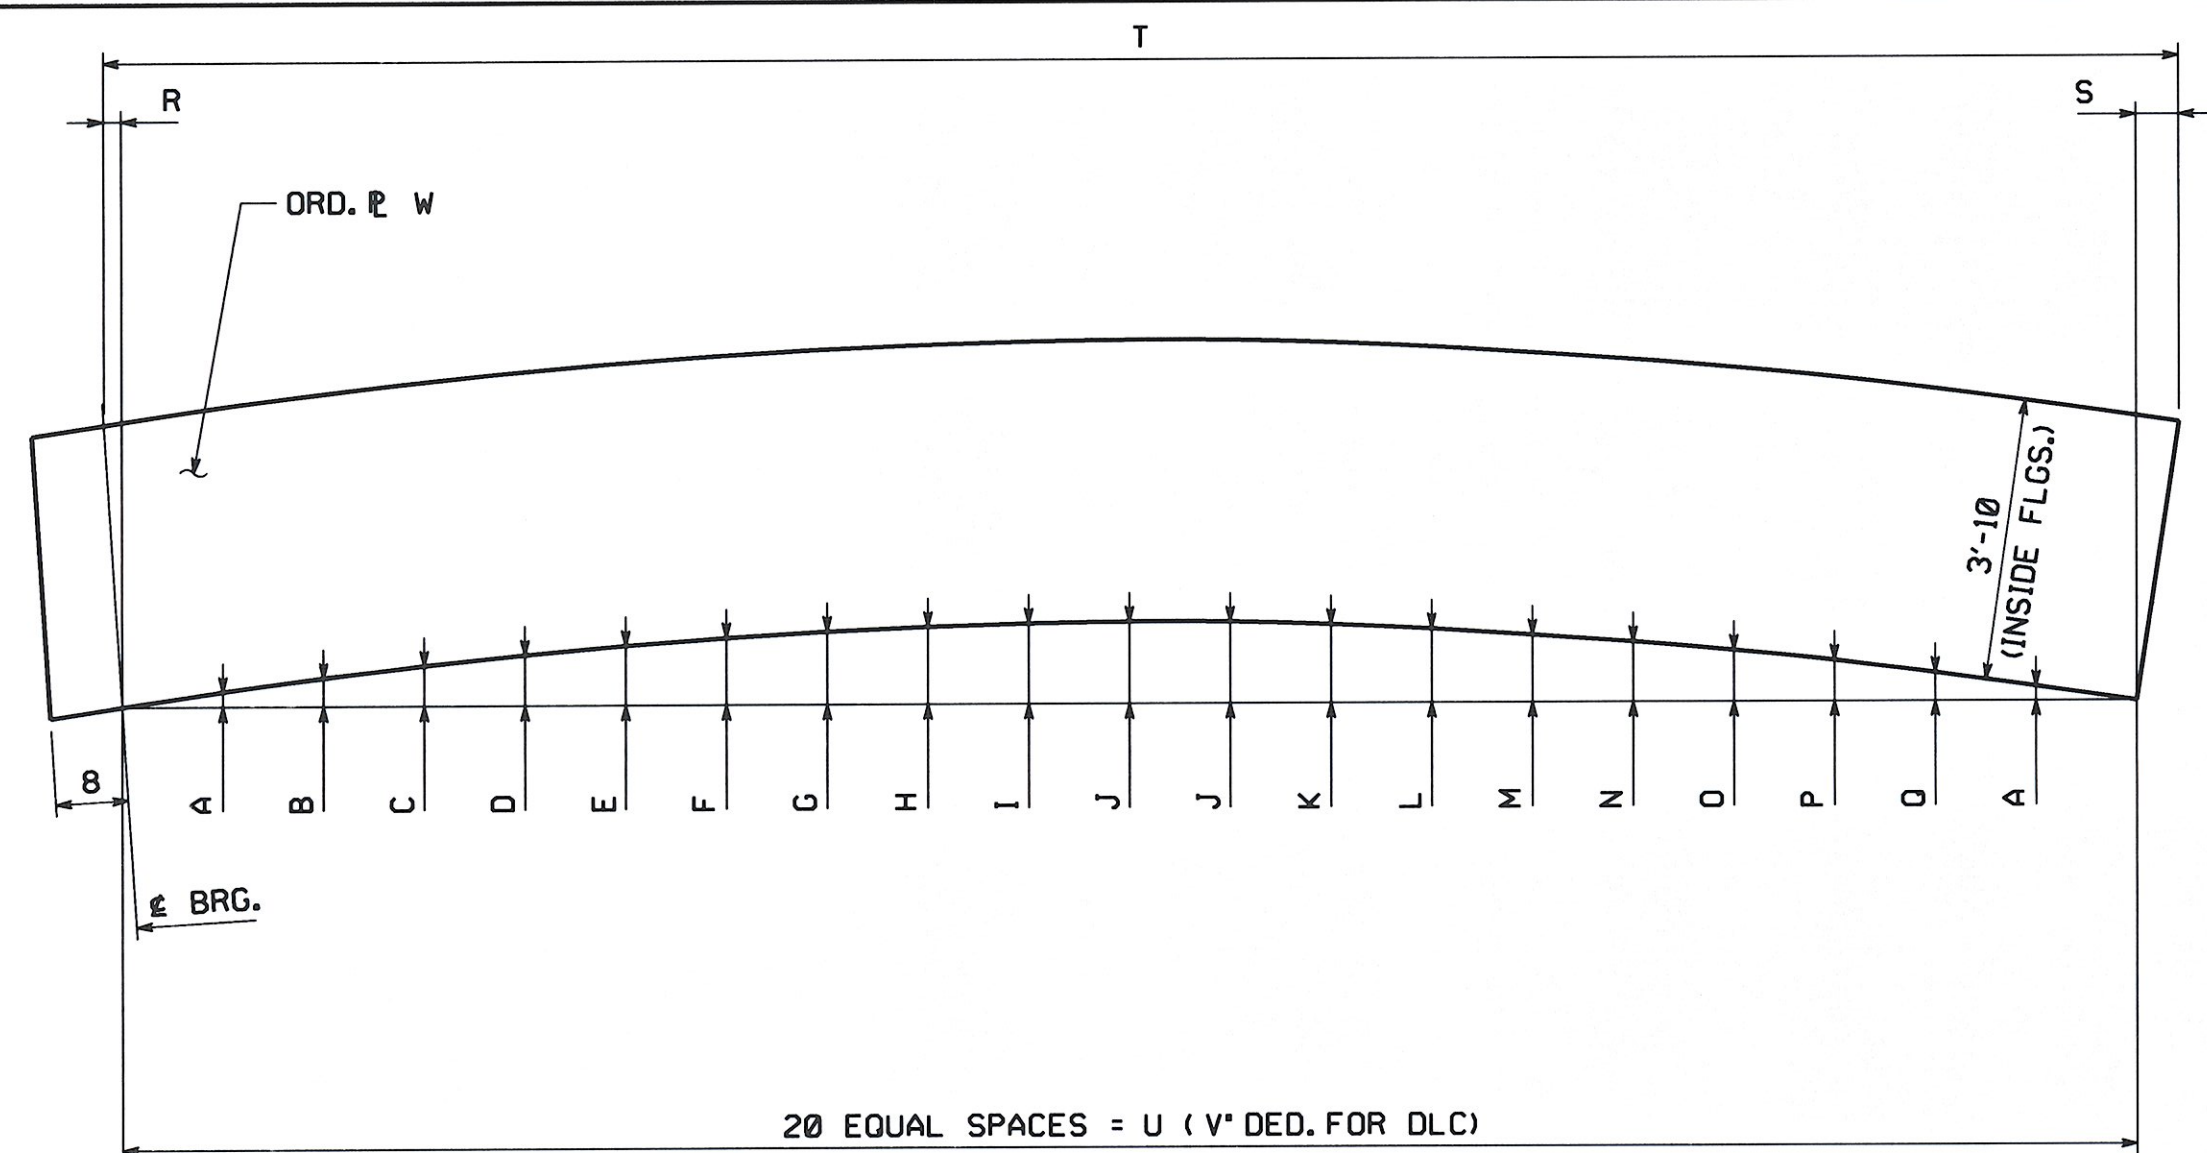

MARK	A	B	C	D	E	F	G	H	I	J	K	L	M	N	O	P	Q	R	S	T	U	V	W
G1A	5/16	1 3/16	1 1/8	2 3/16	2 5/16	2 7/16	3 1/16	3 3/16	3 5/16	3 7/16	3 9/16	3 11/16	2 1/2	2 5/16	2 7/16	1 3/4	1 3/8	3/8	3/8	82'-2 1/16	82'-1 1/16	1/4	5/8 x 50 1/2 x 83'-1 M270 GR. 50W (03001)
G2A	5/16	1 3/16	1 1/8	2 1/8	2 1/2	2 1/2	3 1/16	3 1/4	3 3/8	3 3/8	3 3/4	3 3/4	2 1/2	2 1/2	2 1/2	1 3/4	1 1/4	3/8	3/8	81'-6 7/16	81'-5 1/16	1/4	5/8 x 50 1/2 x 82'-5 M270 GR. 50W (03002)
G3A	5/16	1 3/16	1 1/8	2 1/8	2 7/16	2 3/4	3	3 3/16	3 5/16	3 3/8	3 3/4	3 3/4	2 3/4	2 7/16	2 1/2	1 1/2	1 3/8	3/8	3/8	79'-8 3/8	79'-7 1/16	1/4	5/8 x 50 1/2 x 80'-7 M270 GR. 50W (03003)
G4A	5/16	1 1/8	1 1/8	2	2 5/16	2 5/16	2 5/16	3 1/8	3 1/4	3 1/4	3 1/4	3	2 3/4	2 7/16	2 1/2	1 1/2	1 3/8	3/8	3/8	78'-3 3/8	78'-2 1/16	3/8	5/8 x 50 1/2 x 79'-2 M270 GR. 50W (03004)
G5A	5/16	1 1/8	1 1/8	1 5/16	2 5/16	2 5/16	2 1/2	2 1/2	3 1/8	3 1/8	3	2 1/2	2 5/16	2	1 3/8	1 1/8	1/2	3/8	3/8	77'-4 3/8	77'-3 1/4	3/8	5/8 x 50 x 78'-3 M270 GR. 50W (03005)

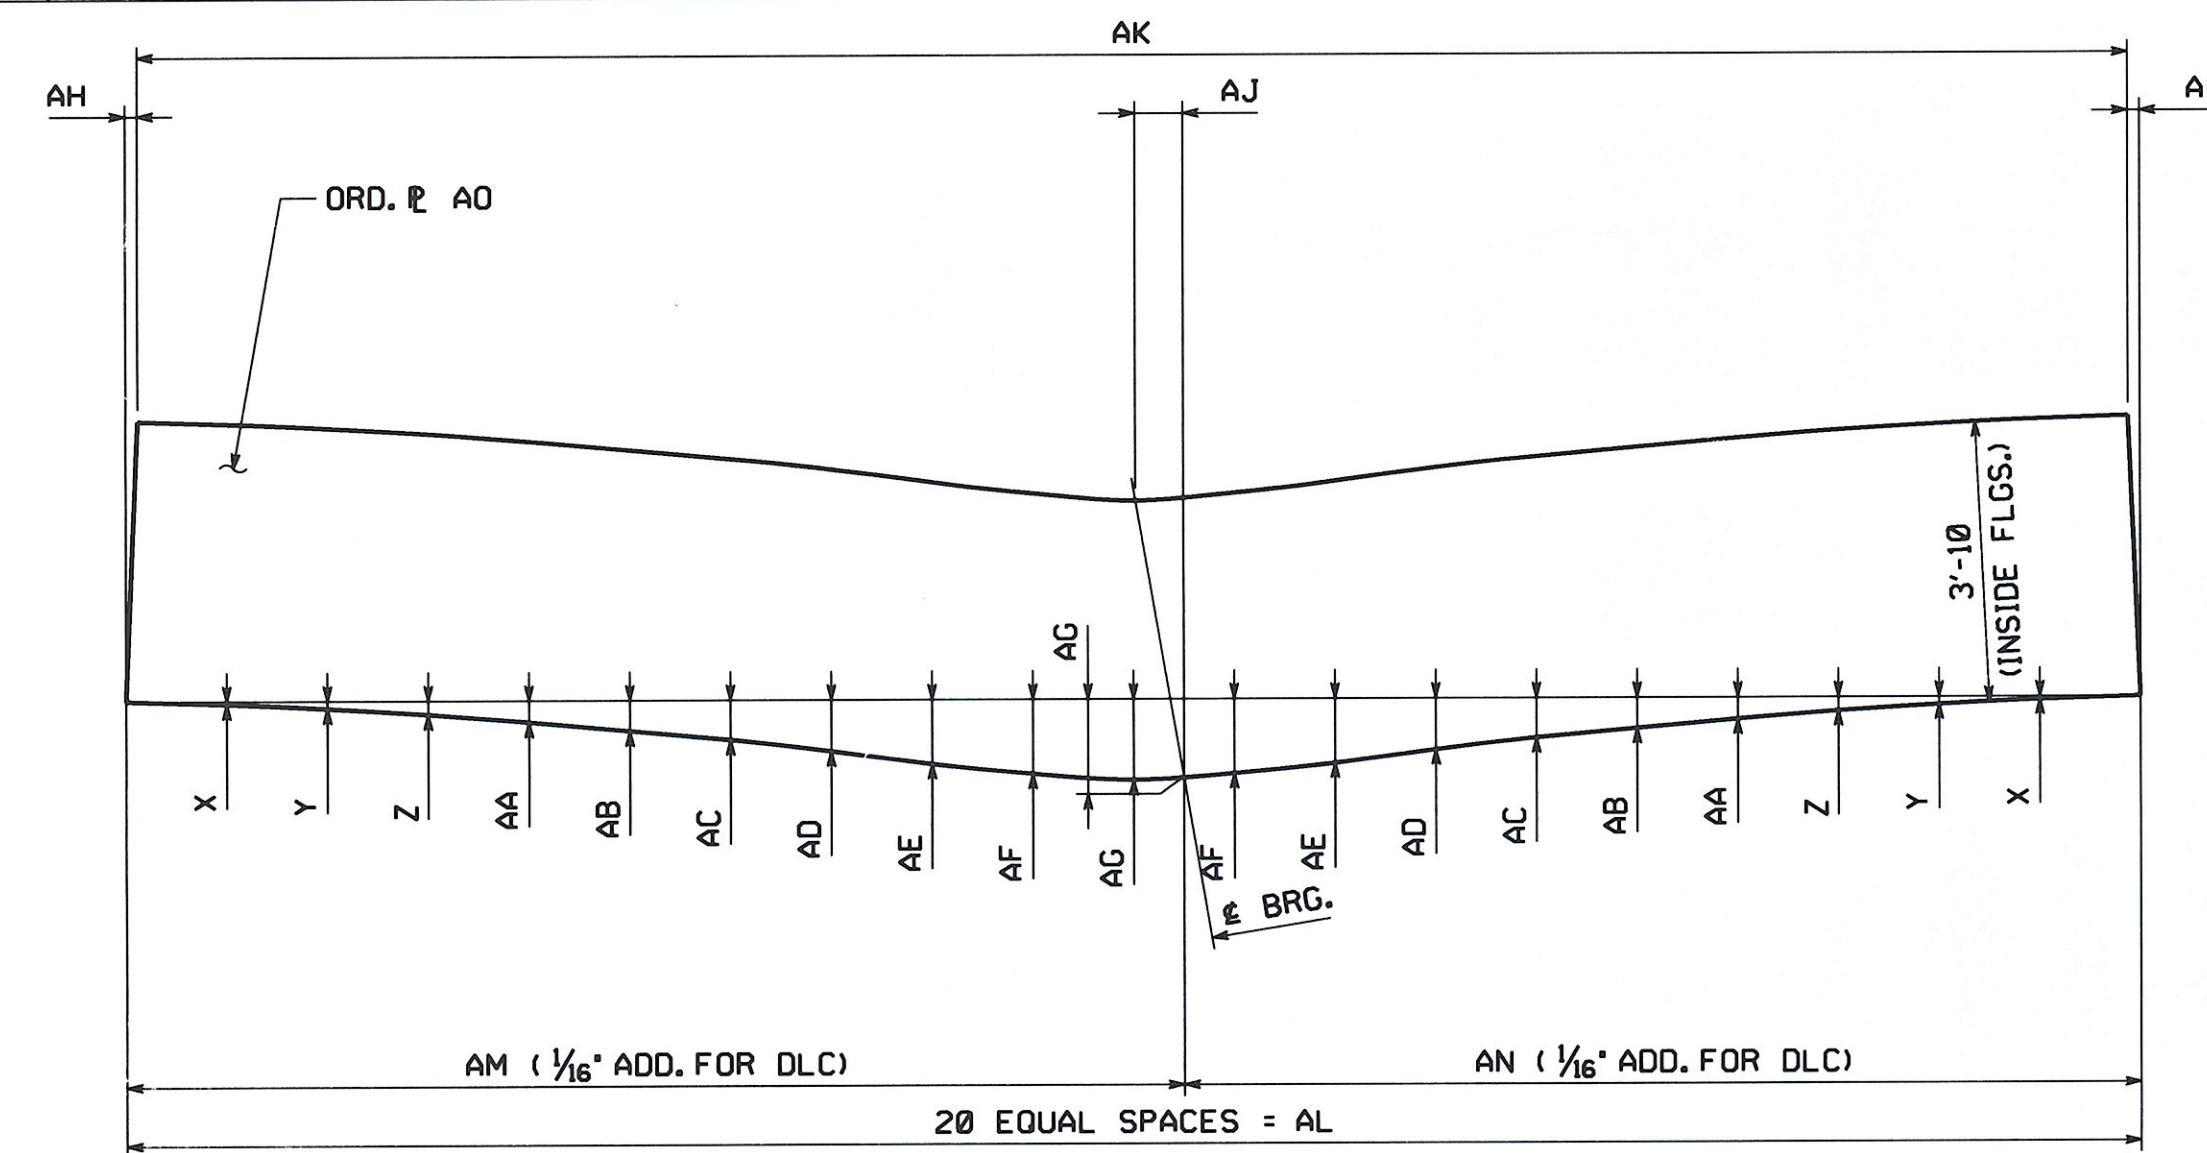

MARK	X	Y	Z	AA	AB	AC	AD	AE	AF	AG	AH	AI	AJ	AK	AL	AM	AN	AO
G1B	-0 1/16	-0 1/8	-0 3/16	-0 5/16	-0 7/16	-0 9/16	-0 11/16	-1 1/16	-1 3/16	0	1/16	1 3/16	1 5/16	64'-5 5/16	64'-5 5/16	32'-2 1/16	32'-2 1/16	5/8 x 48 1/2 x 64'-8 M270 GR. 50W (03006)
G2B	-0 1/16	-0 1/8	-0 3/16	-0 5/16	-0 7/16	-0 9/16	-0 11/16	-1 1/16	-1 3/16	1/16	1/16	1 3/16	1 5/16	62'-4 7/16	62'-4 7/16	31'-2 5/16	31'-2 5/16	5/8 x 48 x 62'-11 M270 GR. 50W (03006)
G4B	0	-0 1/16	-0 1/8	-0 3/16	-0 5/16	-0 7/16	-0 9/16	-0 11/16	-1 1/16	1/16	1/16	1 3/16	1 5/16	62'-1 3/16	62'-1 1/2	31'-0 3/4	31'-0 3/4	5/8 x 48 x 62'-11 M270 GR. 50W (03007)
G5B	0	-0 1/16	-0 1/8	-0 3/16	-0 5/16	-0 7/16	-0 9/16	-0 11/16	-1 1/16	0	0	0	1/16	60'-7 1/16	60'-7 1/16	30'-4	30'-3 1/16	5/8 x 48 x 60'-10 M270 GR. 50W (03008)

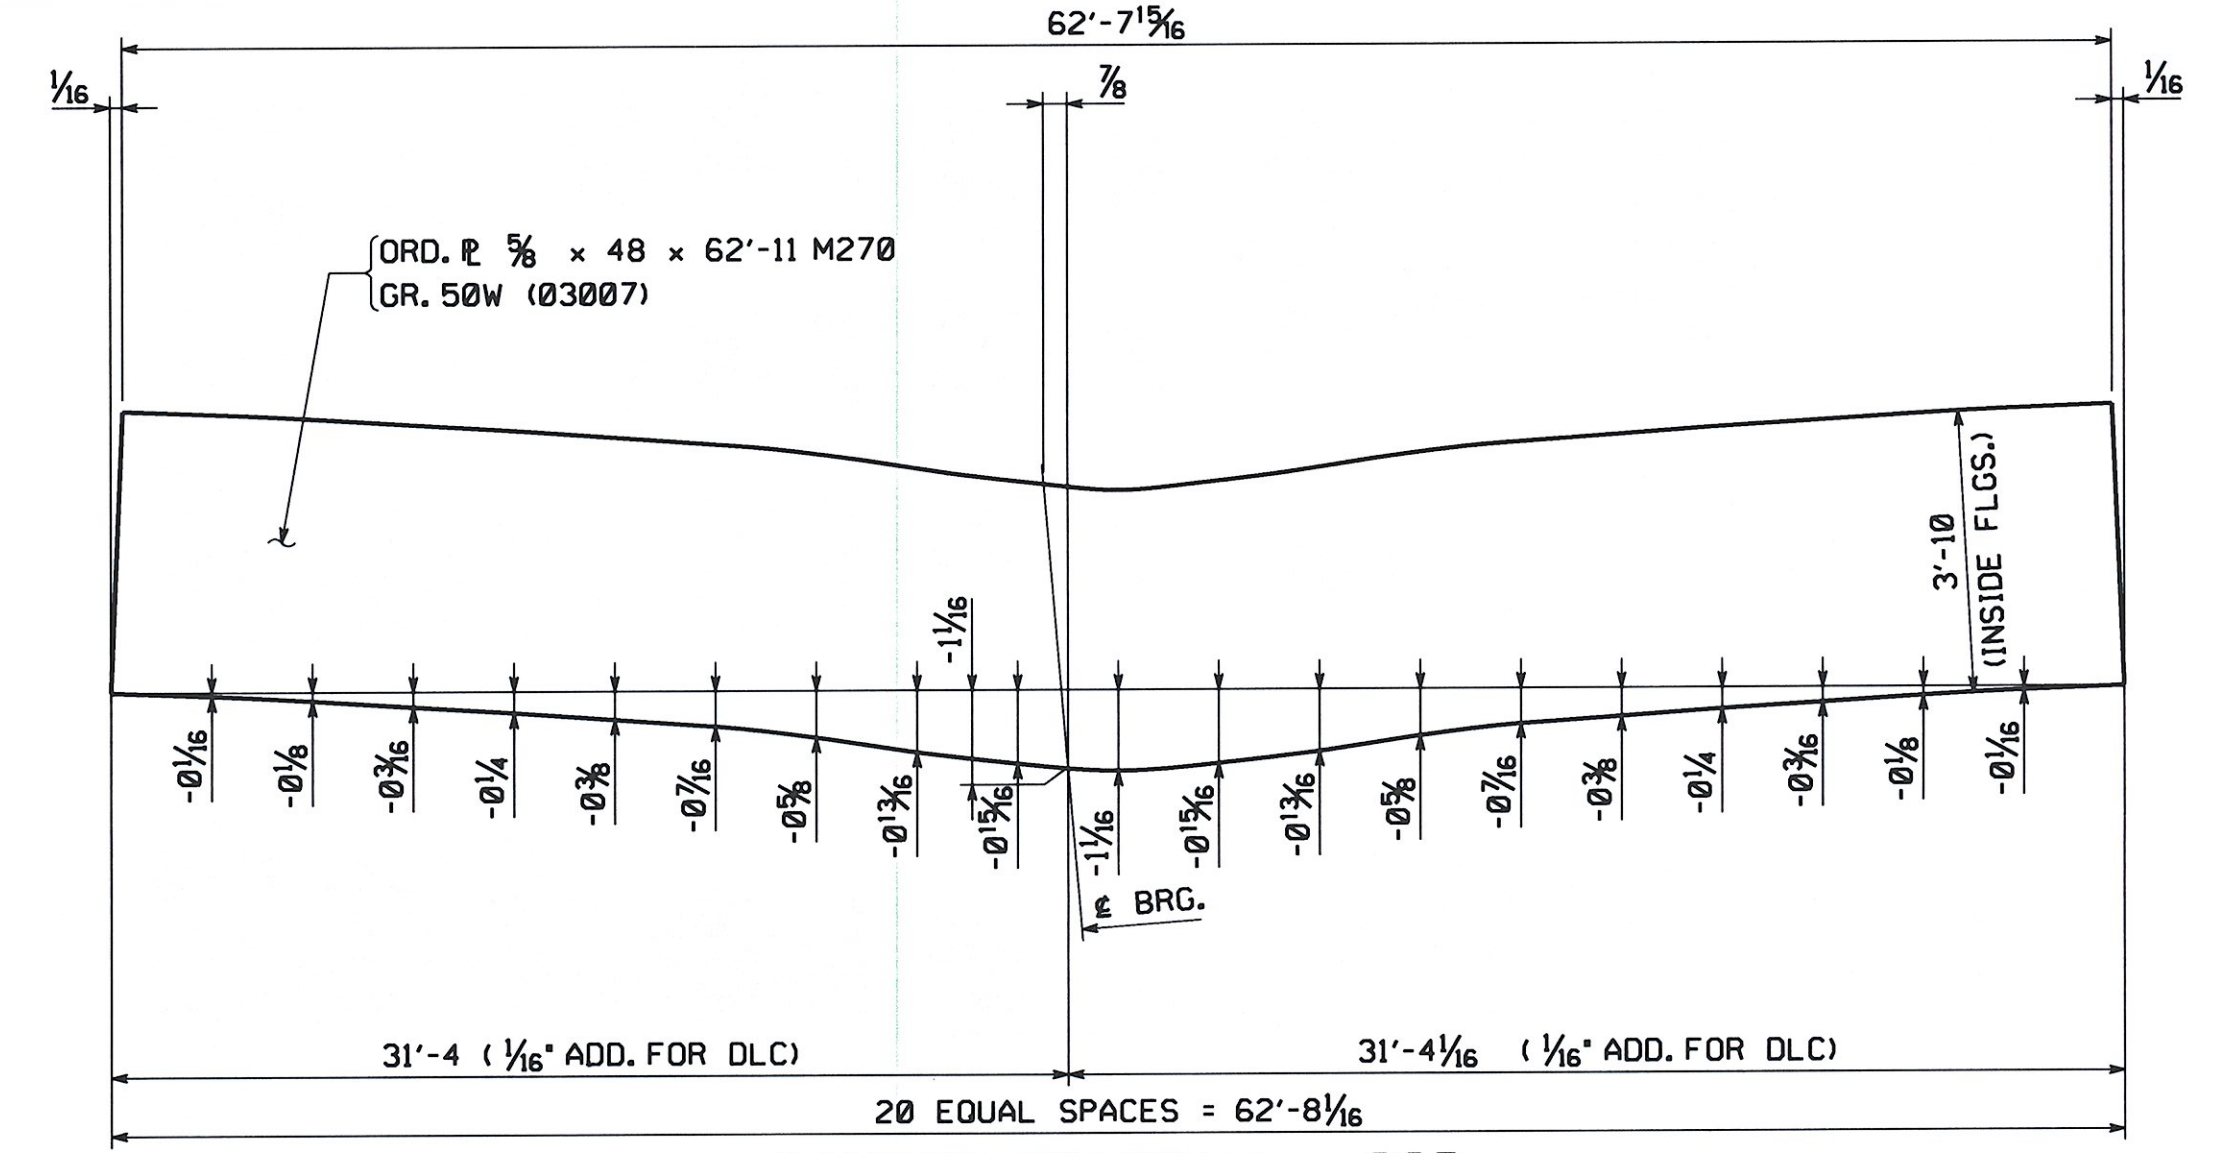

CAMBER DIAGRAM - G3B

NOTES:
 FOR GENERAL SHOP NOTES, SEE DRAWING GNI.
 ALL WEB PLATES REQUIRE CHARNY V-NOTCH TEST.
 NEGATIVE CAMBER ORDINATES INDICATE CURVE IS BELOW BASELINE.

RECEIVED
 OK'D BY JK OK'D BY SEL
 AUG 18 2008
 RESUBMIT APPROVED
 BY KMH DATE 8/19/08

NO.	REVISION	BY	CHK'D	DATE

HOLES			Lancaster Facility 850 Old Philadelphia Pike Lancaster, PA 17605-0008 Phone 1717-299-5221 Williamsport Facility 3501 W. 4th Street Williamsport, PA 17701 Phone 1570-326-9051 www.HighSteel.com		
BOLTS	An ISO 9001:2000 Certified Company				
COATING	VT ROUTE 100 (MINOR ARTERIAL) OVER WHITE RIVER VT ROUTE 100 STA. 141+39.00 TO STA. 143+61.00 TOWN OF STOCKBRIDGE, COUNTY OF WINDSOR, VERMONT				
CODES	STATE OF VERMONT AGENCY OF TRANSPORTATION				
SCALE	STATE CONT. PROJECT NO. (STP) BR OR REF. NO. 013-4(21)	FED. AID PROJ. NO.			
N.T.S.	GENERAL CONTRACTOR WINTERSET, INC. HSSI PROJ. MGR	HSSI PROJ. MGR	DEB KUPRES		
SHPM	1	DRAWING MANAGER KREIDER (IH)	MADE BY KMA	CHK'D BY SJA	DATE 5/22/08
STATE	VT	HSSI PROJECT NUMBER S-1080077	HSSI STRUCT. ID A	DRAWING NUMBER WC1	OF WC2

SHIPMENT 01
 PKENGR: 5004327 PRD: 5004329 SHIPARECT: 5004329

PLOTTED: 6/25/2008 3:40:14 PM
 BY: Mckendel