




ENGLISH

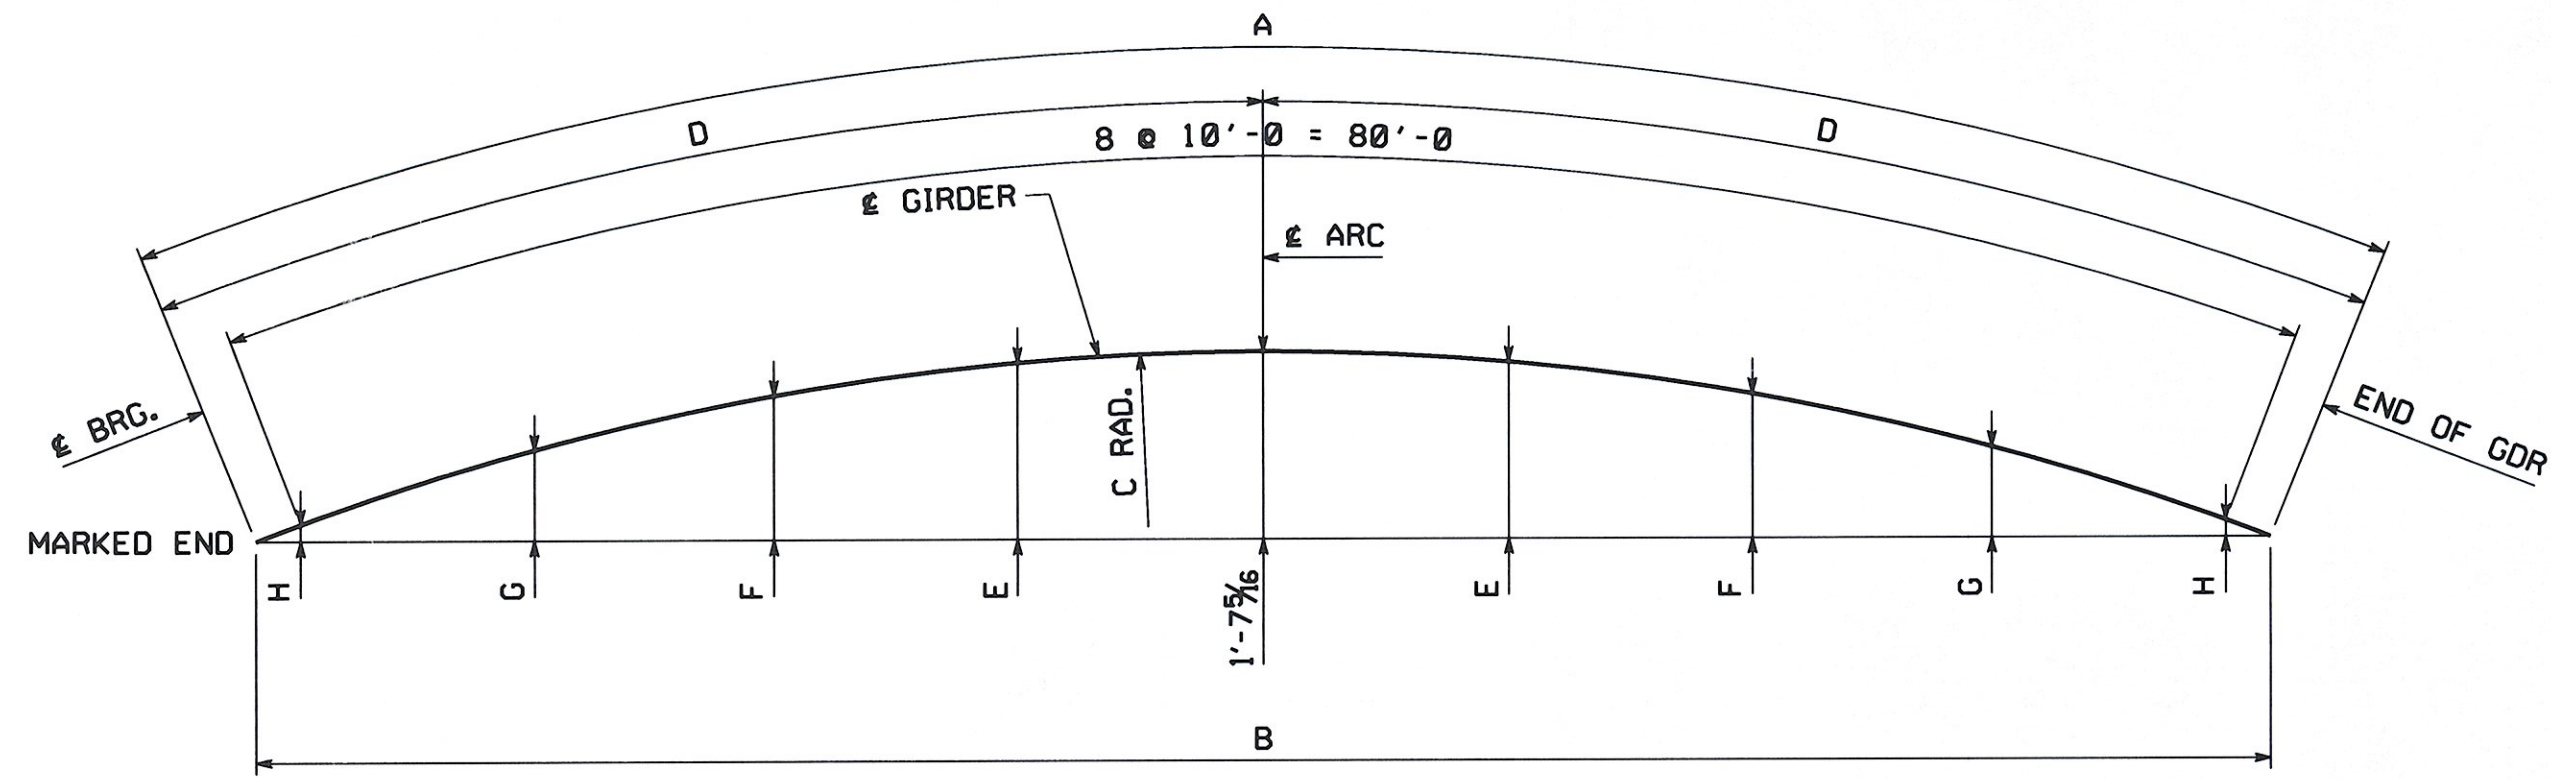


MARK	A	B	C	D	E	F	G	H
G1A	82'-2 ¹ / ₁₆	82'-1 ¹ / ₁₆	524'-9 ⁹ / ₁₆	41'-1 ¹ / ₃₂	1'-6 ³ / ₁₆	1'-2 ³ / ₁₆	9	1
G2A	81'-6 ⁶ / ₁₆	81'-5 ⁵ / ₁₆	517'-0 ⁰ / ₁₆	40'-9 ⁹ / ₁₆	1'-6 ⁶ / ₁₆	1'-2 ² / ₁₆	8 ⁸ / ₁₆	3 ³ / ₁₆

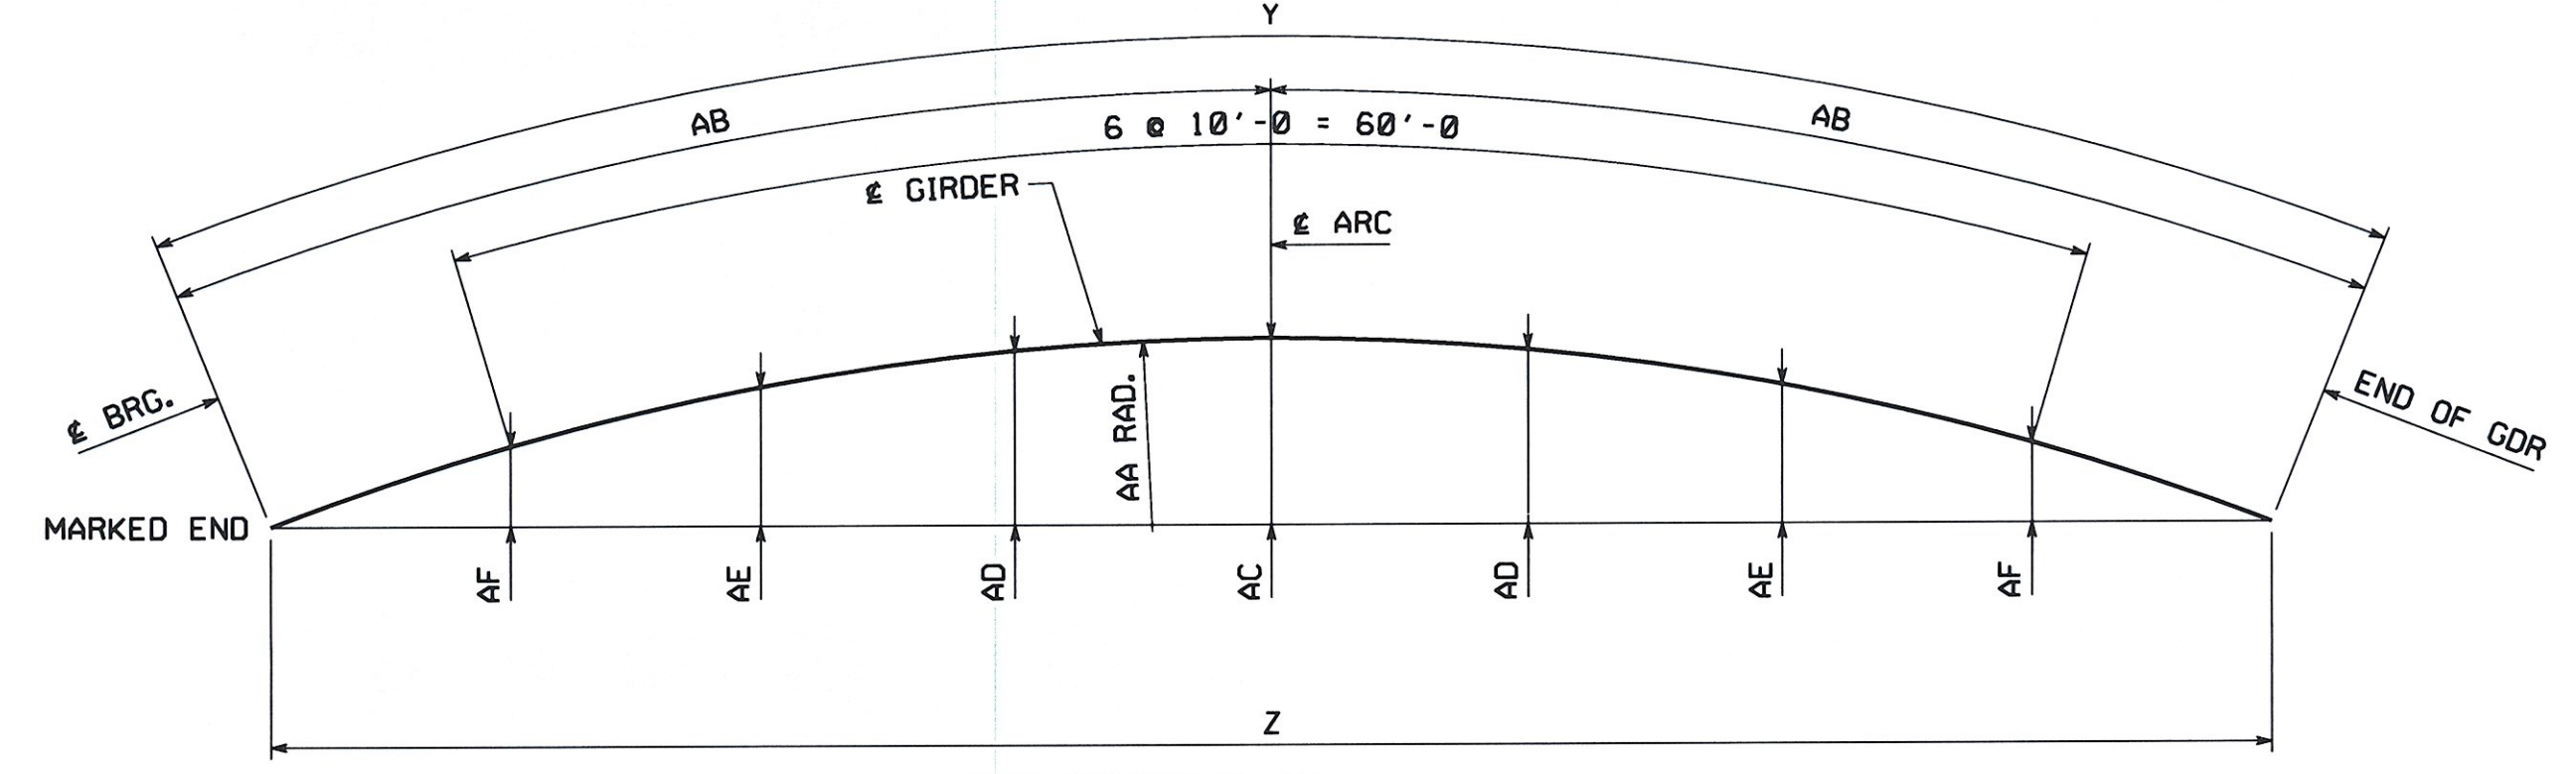


MARK	Y	Z	AA	AB	AC	AD	AE	AF
G3A	79'-8 ⁸ / ₁₆	79'-7 ⁷ / ₁₆	509'-3 ³ / ₁₆	39'-10 ¹⁰ / ₁₆	1'-6 ⁶ / ₁₆	1'-5 ⁵ / ₁₆	1'-2	8 ⁸ / ₁₆
G4A	78'-3 ³ / ₁₆	78'-2 ² / ₁₆	501'-6 ⁶ / ₁₆	39'-1 ¹ / ₁₆	1'-6 ⁶ / ₁₆	1'-5 ⁵ / ₁₆	1'-1 ¹ / ₁₆	7 ⁷ / ₁₆
G5A	77'-4 ⁴ / ₁₆	77'-3 ³ / ₁₆	493'-9 ⁹ / ₁₆	38'-8 ⁸ / ₃₂	1'-6 ⁶ / ₁₆	1'-4 ⁴ / ₁₆	1'-1 ¹ / ₁₆	7 ⁷ / ₁₆

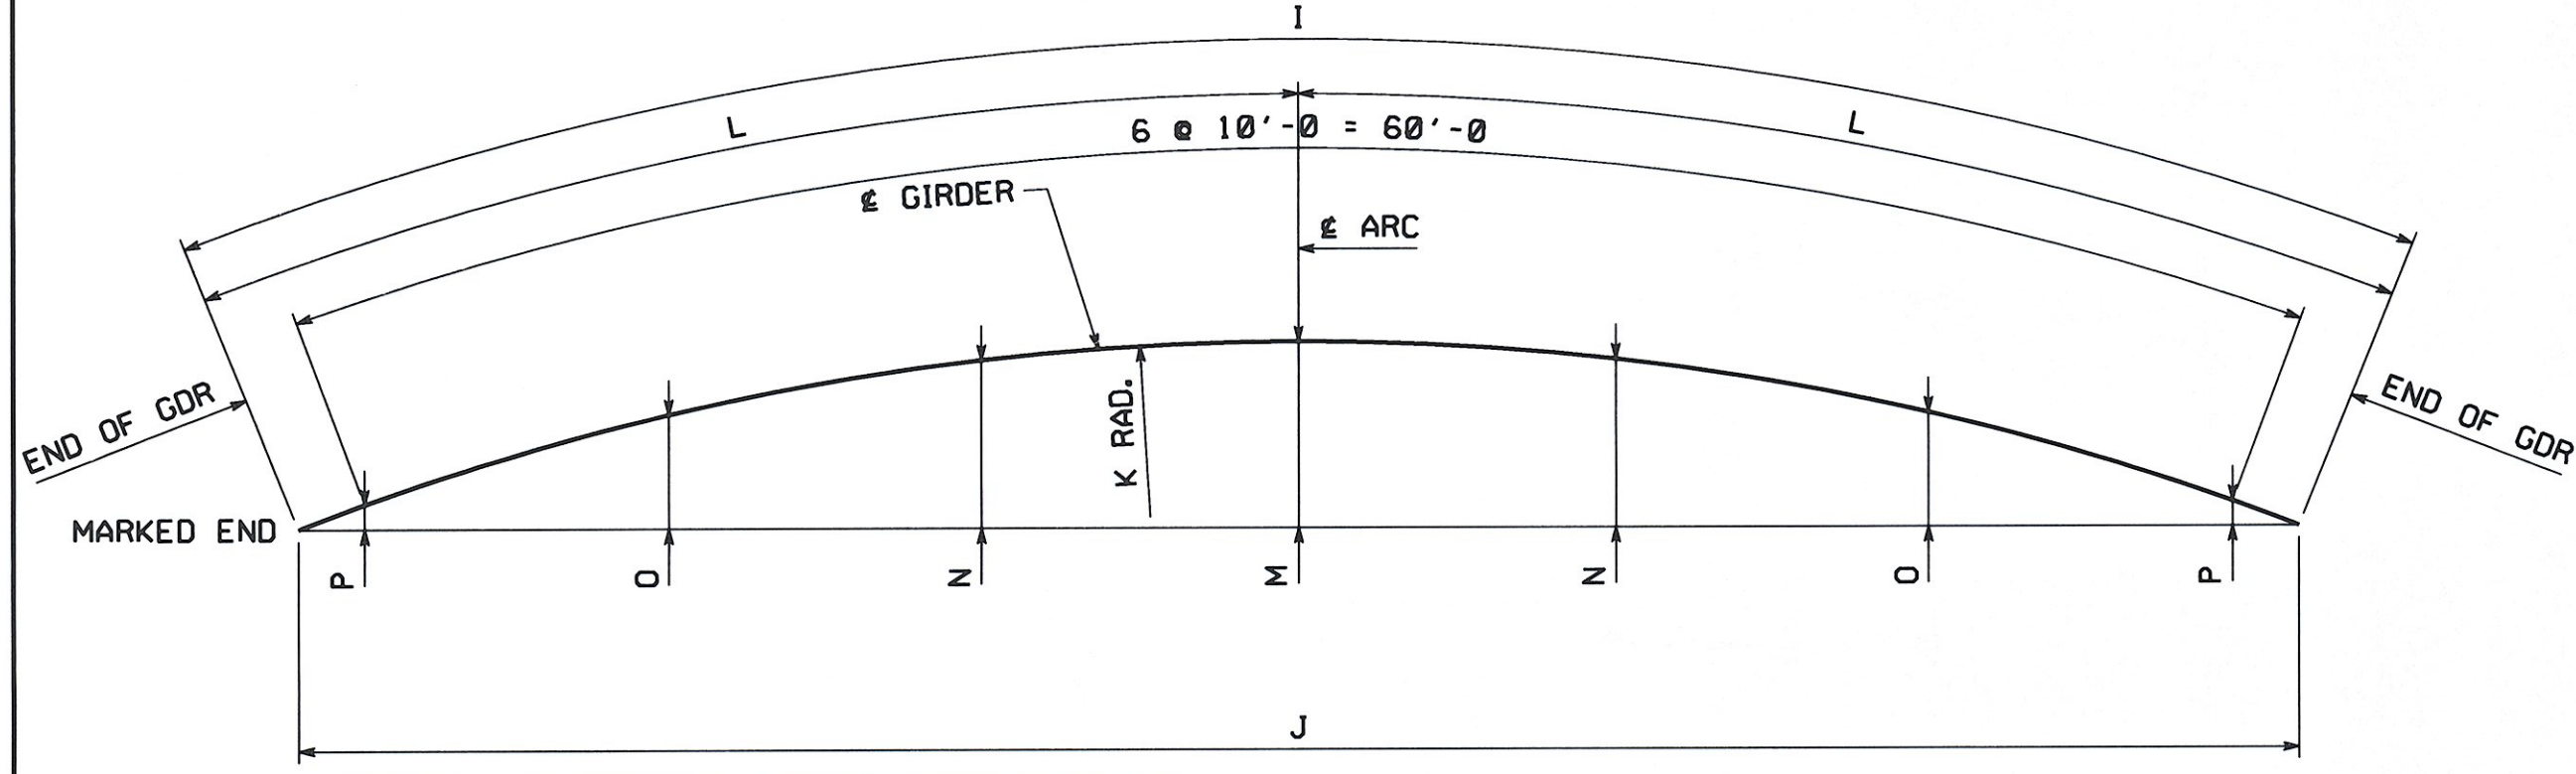

MARK	I	J	K	L	M	N	O	P
G1B	64'-5 ⁵ / ₁₆	64'-5 ⁵ / ₁₆	524'-9 ⁹ / ₁₆	32'-2 ² / ₃₂	11 ¹¹ / ₁₆	10 ¹⁰ / ₁₆	7 ⁷ / ₁₆	1 ¹ / ₁₆
G2B	62'-4 ⁴ / ₁₆	62'-4	517'-0 ⁰ / ₁₆	31'-2 ² / ₃₂	11 ¹¹ / ₁₆	10 ¹⁰ / ₁₆	6 ⁶ / ₁₆	1 ¹ / ₁₆
G3B	62'-7 ⁷ / ₁₆	62'-7 ⁷ / ₁₆	509'-3 ³ / ₁₆	31'-3 ³ / ₃₂	11 ¹¹ / ₁₆	10 ¹⁰ / ₁₆	6 ⁶ / ₁₆	1 ¹ / ₁₆
G4B	62'-1 ¹ / ₁₆	62'-0 ⁰ / ₁₆	501'-6 ⁶ / ₁₆	31'-0 ⁰ / ₁₆	11 ¹¹ / ₁₆	10 ¹⁰ / ₁₆	6 ⁶ / ₁₆	3 ³ / ₁₆
G5B	60'-7 ⁷ / ₁₆	60'-7 ⁷ / ₁₆	493'-9 ⁹ / ₁₆	30'-3 ³ / ₃₂	11 ¹¹ / ₁₆	9 ⁹ / ₁₆	6 ⁶ / ₁₆	1 ¹ / ₁₆

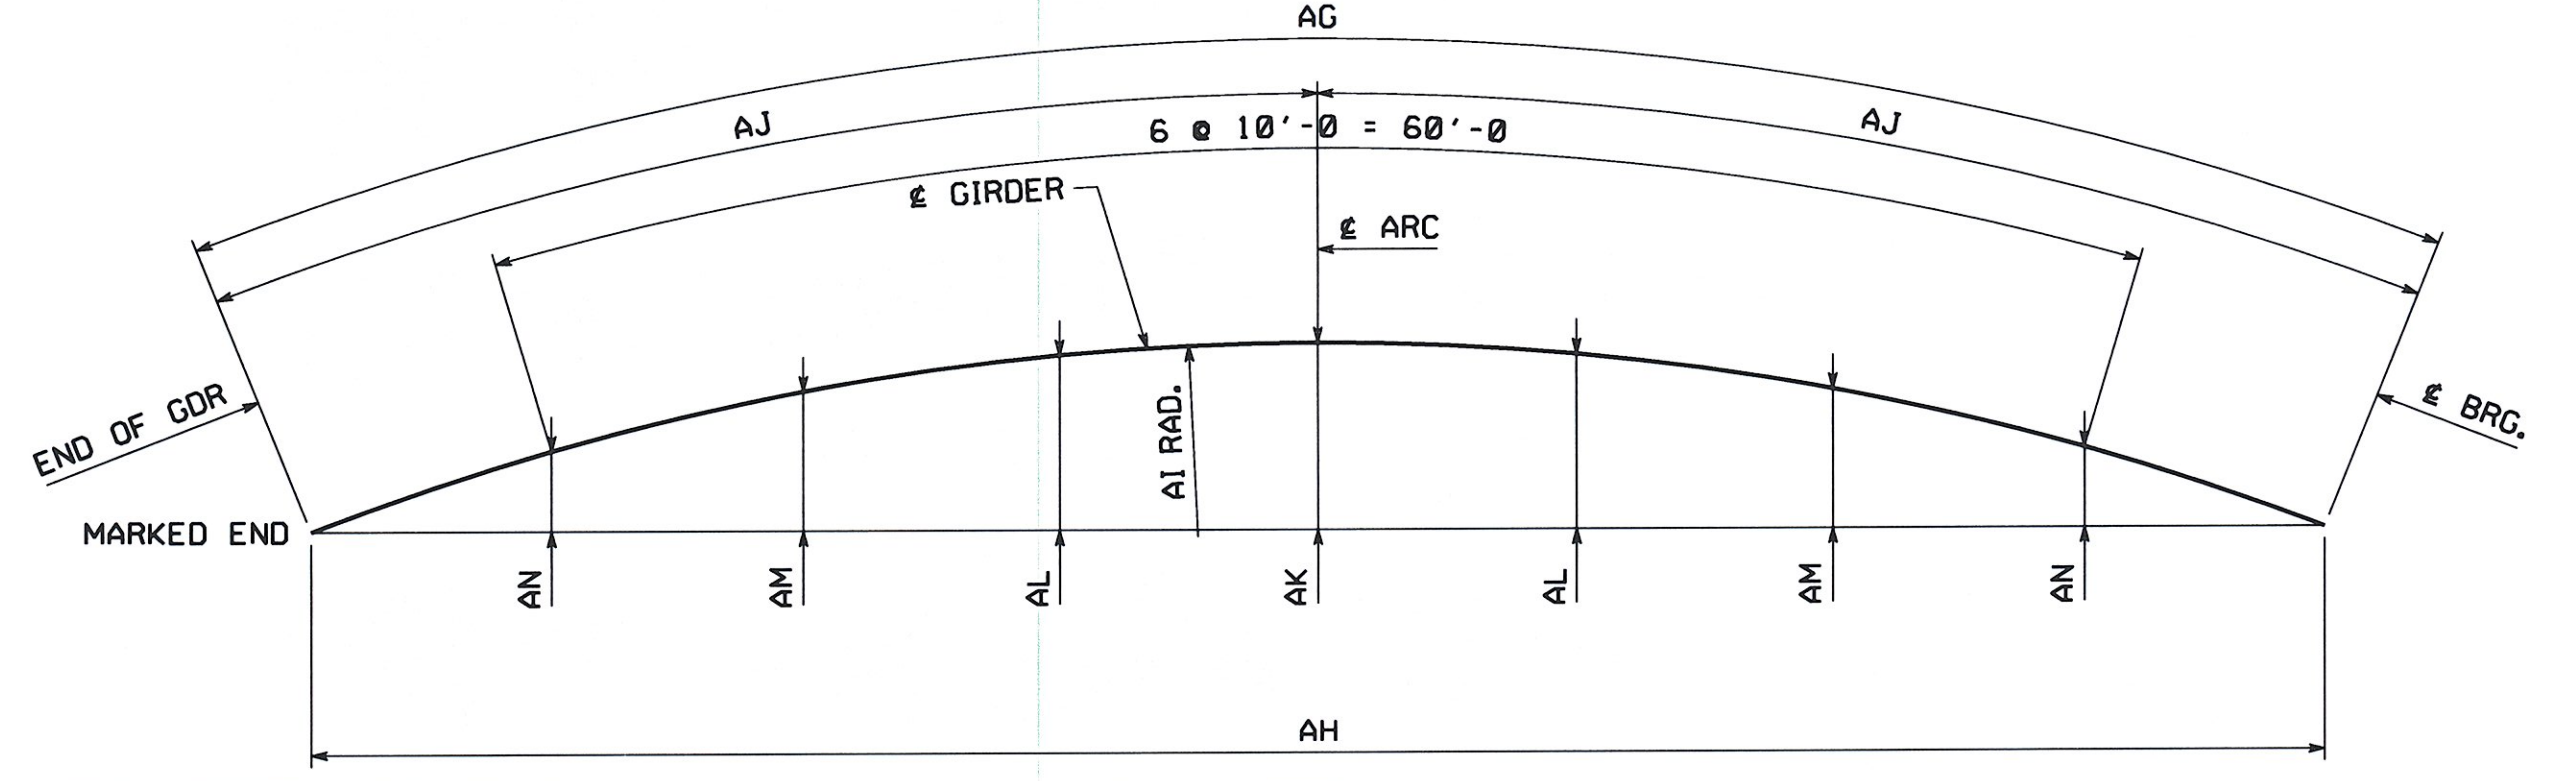

MARK	AG	AH	AI	AJ	AK	AL	AM	AN
G3C	79'-7 ⁷ / ₁₆	79'-6 ⁶ / ₁₆	509'-3 ³ / ₁₆	39'-9 ⁹ / ₃₂	1'-6 ⁶ / ₁₆	1'-5 ⁵ / ₁₆	1'-1 ¹ / ₁₆	8 ⁸ / ₁₆
G4C	78'-2 ² / ₁₆	78'-1 ¹ / ₁₆	501'-6 ⁶ / ₁₆	39'-1 ¹ / ₃₂	1'-6 ⁶ / ₁₆	1'-5 ⁵ / ₁₆	1'-1 ¹ / ₂	7 ⁷ / ₁₆
G5C	77'-2 ² / ₁₆	77'-2	493'-9 ⁹ / ₁₆	38'-7 ⁷ / ₃₂	1'-6 ⁶ / ₁₆	1'-4 ⁴ / ₁₆	1'-1 ¹ / ₄	7 ⁷ / ₁₆

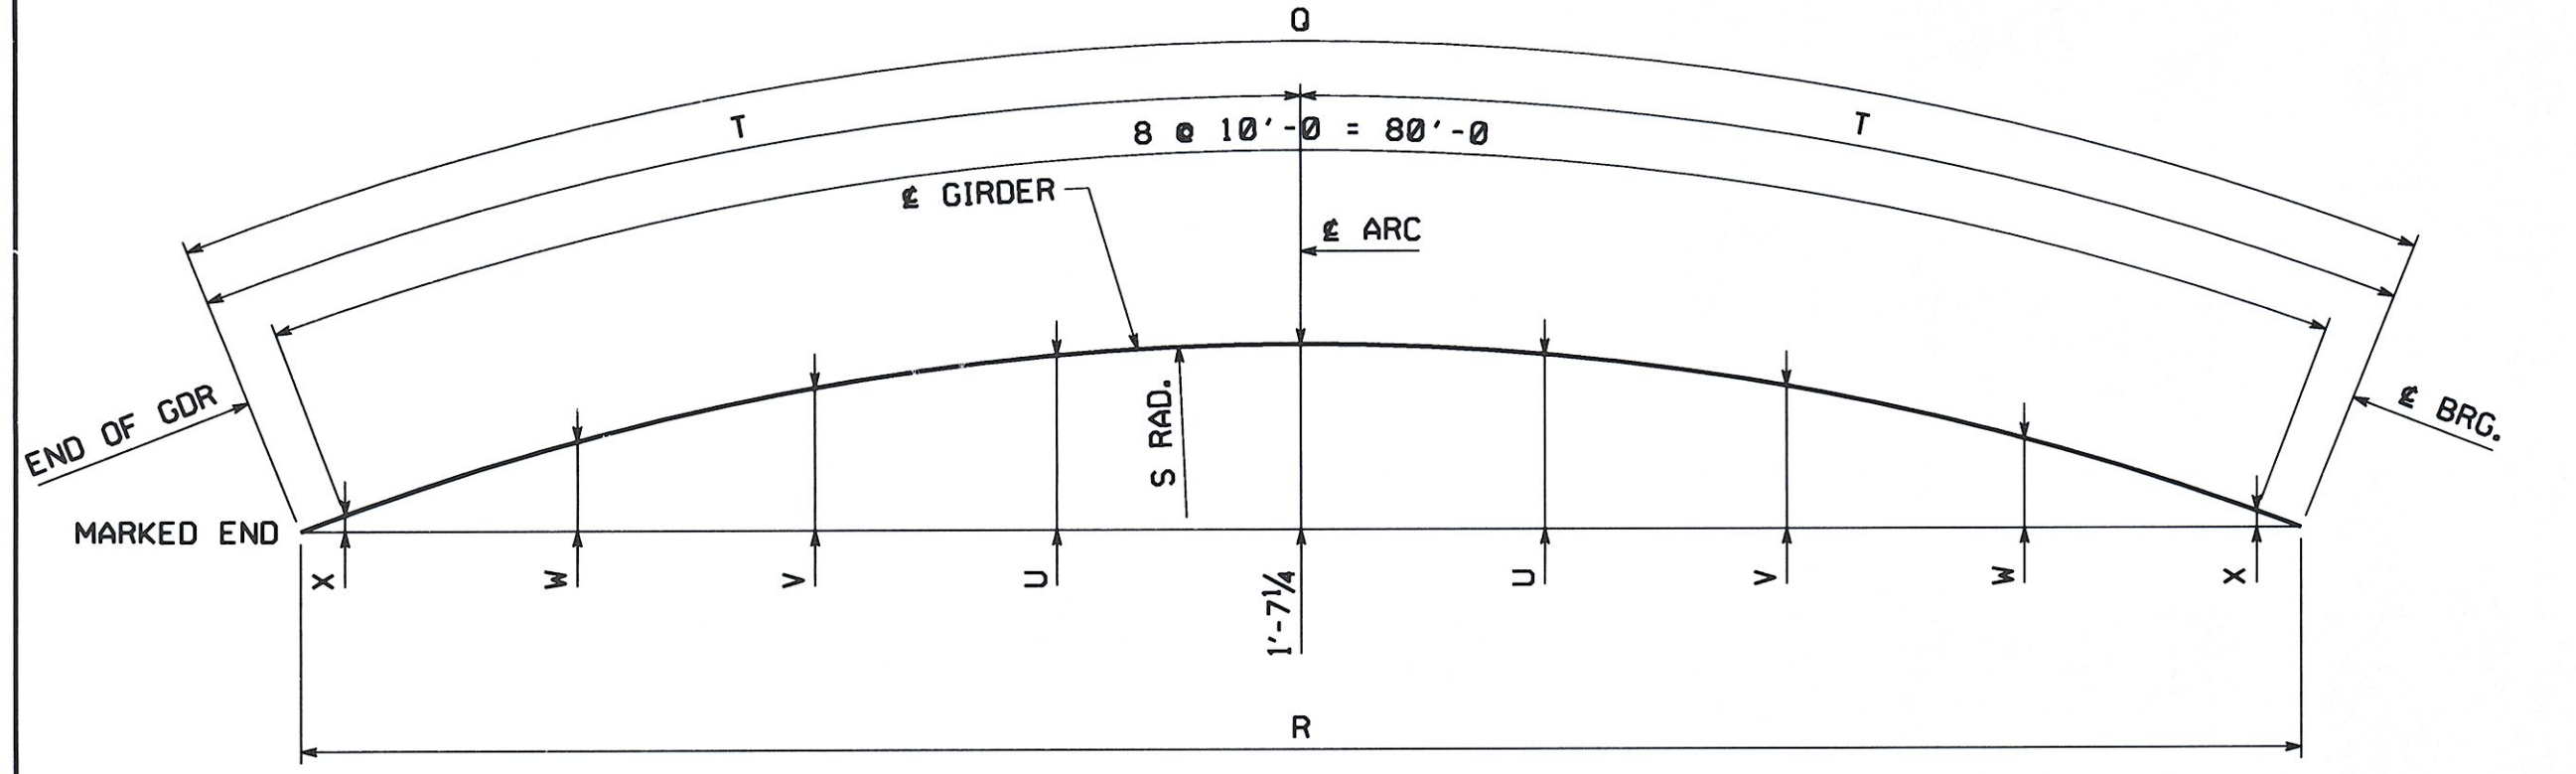

MARK	Q	R	S	T	U	V	W	X
G1C	82'-1 ¹ / ₁₆	82'-0 ⁰ / ₁₆	524'-9 ⁹ / ₁₆	41'-0 ⁰ / ₁₆	1'-6 ⁶ / ₁₆	1'-2 ² / ₁₆	9	1
G2C	81'-5 ⁵ / ₁₆	81'-4 ⁴ / ₁₆	517'-0 ⁰ / ₁₆	40'-8 ⁸ / ₃₂	1'-6 ⁶ / ₁₆	1'-2 ² / ₁₆	8 ⁸ / ₁₆	1 ¹ / ₁₆

NOTES:
ALL DIMENSIONS APPLY AT THE TOP OF WEB PLATE OF THE GIRDERS.

RECEIVED
OK'D BY: JCL
AUG 18 2008
RESUBMIT APPROVED
BY: kmh DATE 8/19/08

NO.	REVISION	BY	CHK'D	DATE
HORIZONTAL CURVE DIAGRAMS VT ROUTE 100 (MINOR ARTERIAL) OVER WHITE RIVER VT ROUTE 100 STA. 141+39.00 TO STA. 143+61.00 TOWN OF STOCKBRIDGE, COUNTY OF WINDSOR, VERMONT STATE OF VERMONT AGENCY OF TRANSPORTATION				
STATE CONT. PROJECT NO. (STP) BR/		FED. AID PROJ. NO.		
OR REF. NO. 013-4(21)				
GENERAL CONTRACTOR WINTERSET, INC.		HSSI PROJ. MGR		DEB KUPRES
SCALE N.T.S.	DRAWING MANAGER KREIDER (IH)		MADE BY KMA	CHK'D BY SJA
DATE 5/22/08	PROJECT NUMBER S-1080077		HSSI STRUCT. ID A	DRAWING NUMBER HC1 OF HC1

SHIPMENT 01 PMAENGL: 50804327 PRD: 50804328 SHIP&RECT: 50804329

BY: Mkrwada

PLOTTED: 6/25/2008 3:48:03 PM