


SHIPMENT 1
 PMENGG: XXXXXXXX
 PROJ: XXXXXXXX
 SHIPPERECT: XXXXXXXX

PLOTTED: 06/25/08 15:45:38
 BY: MKreide1

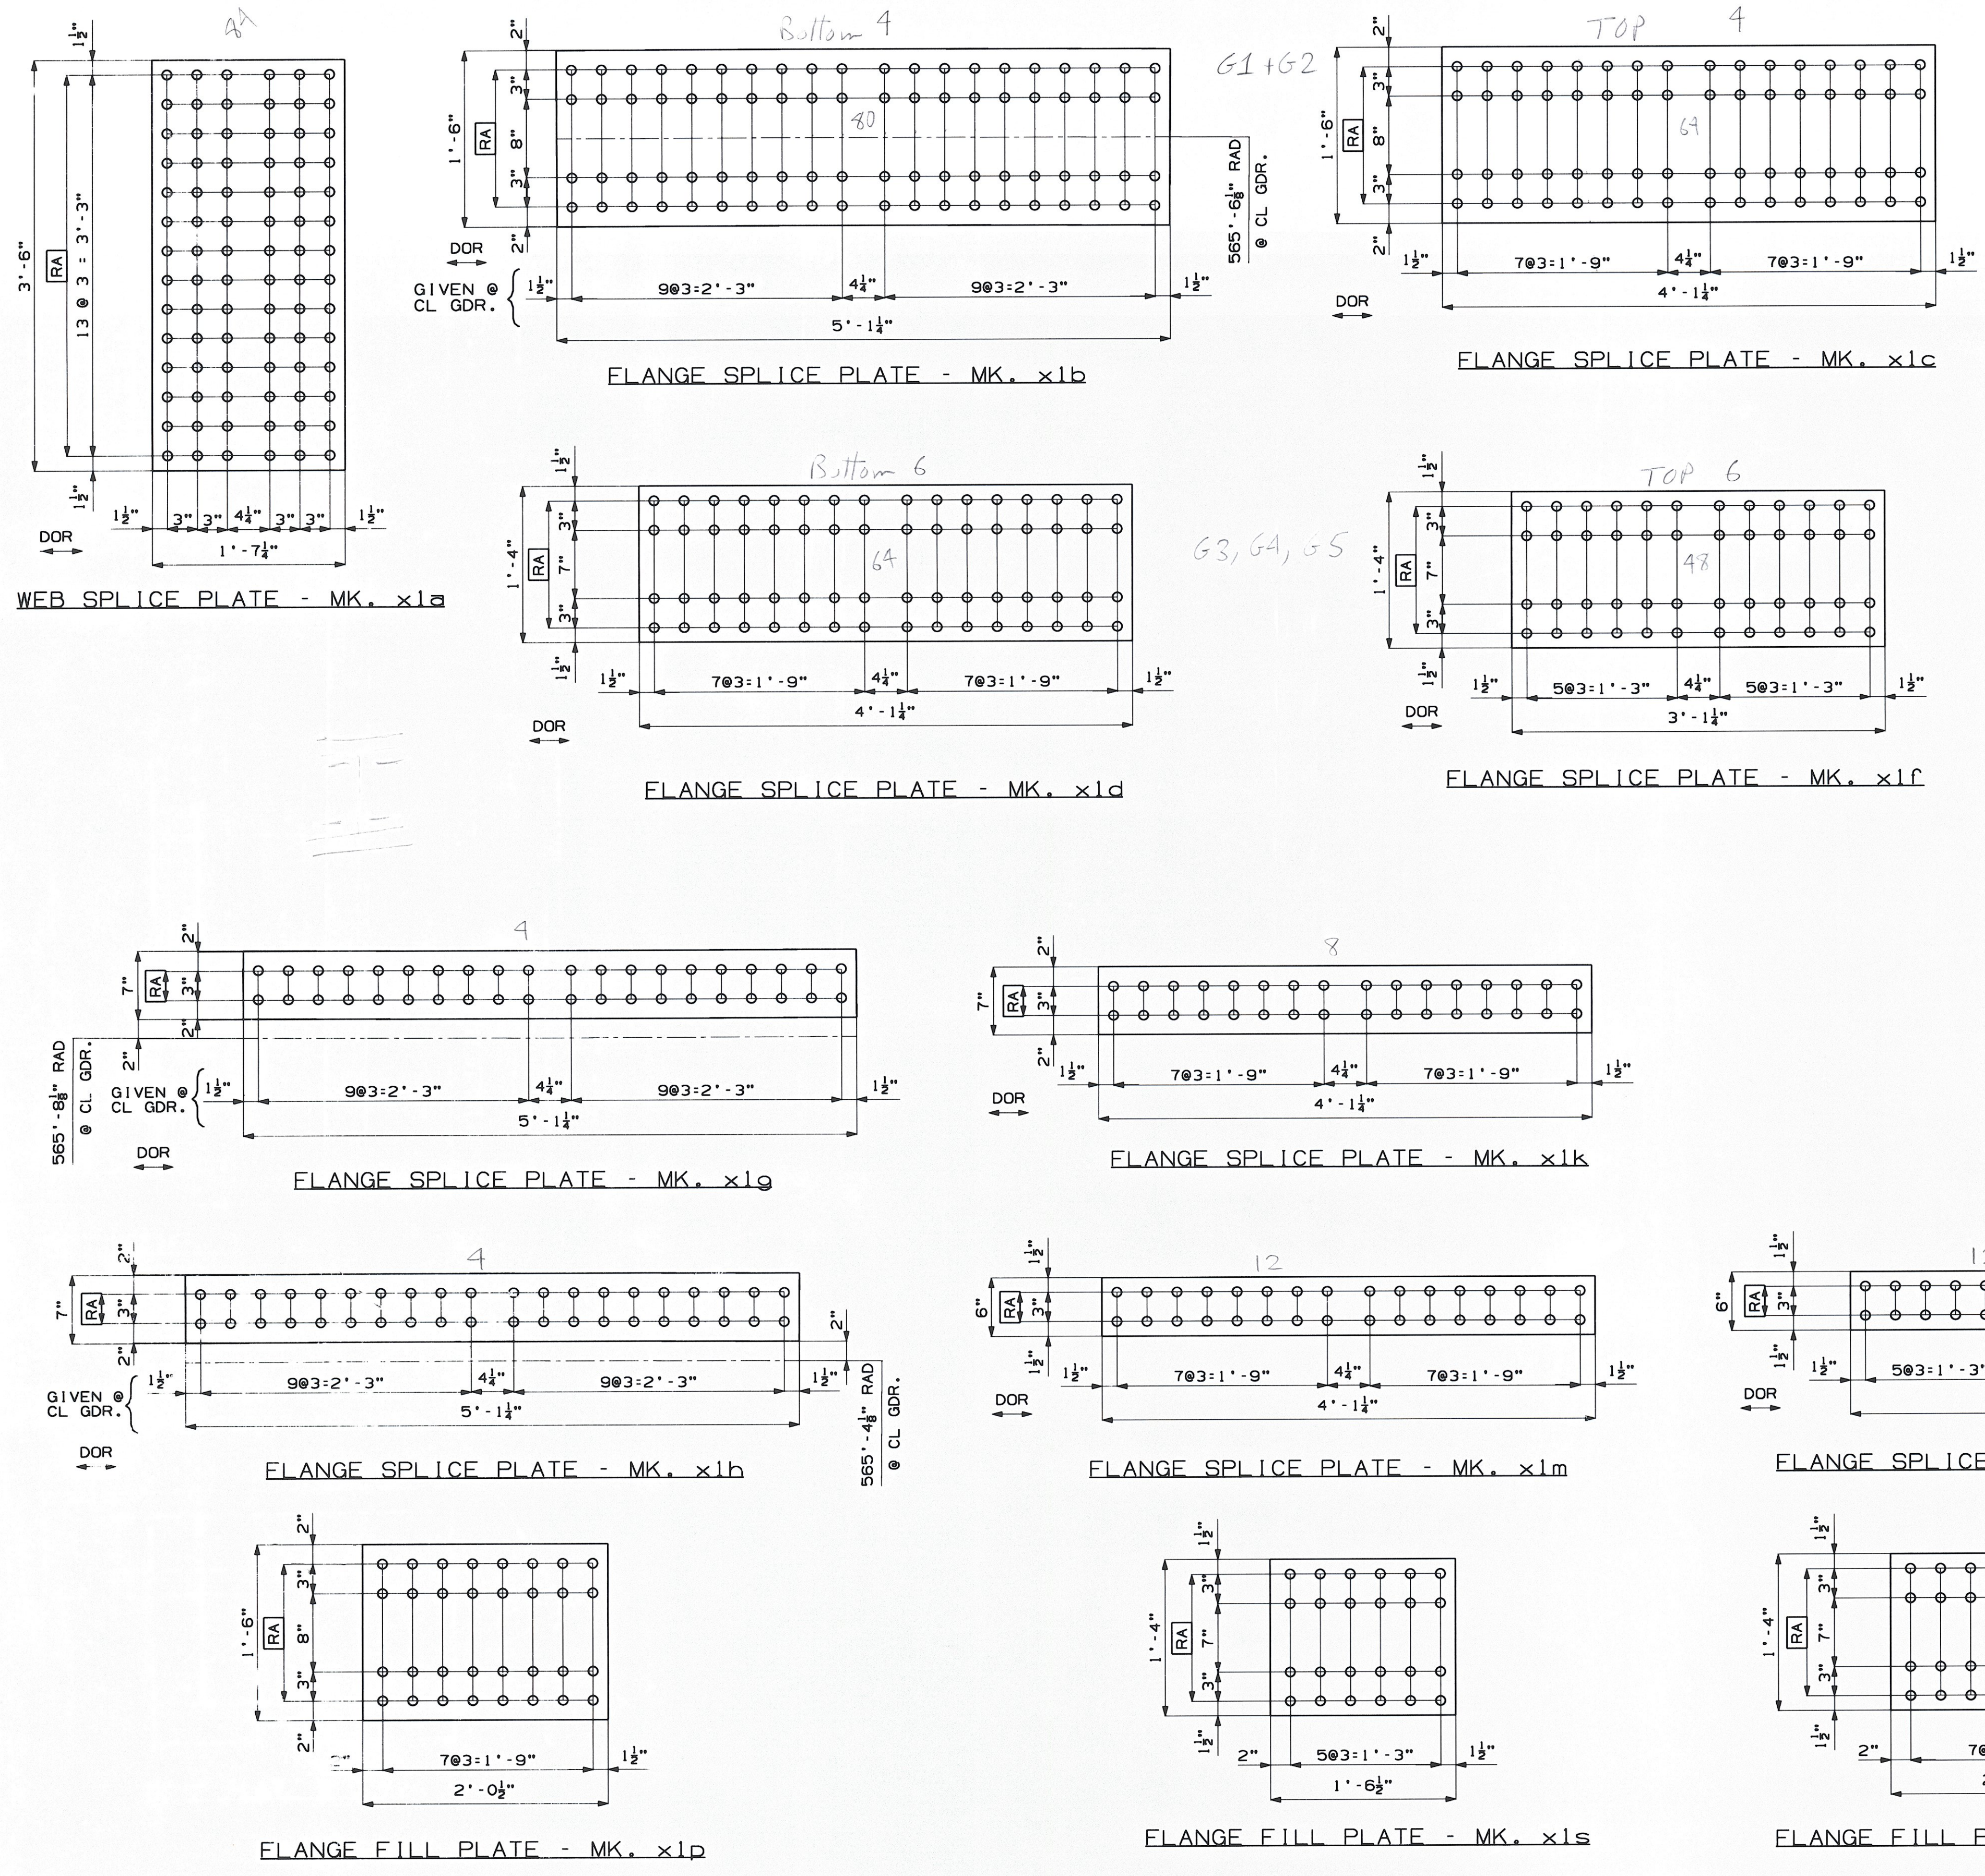

BILL OF MATERIAL														
QTY	MARK	COMMO DITY	DESCRIPTION			LENGTH	SPEC	GRADE	TEST	REMARKS	ITEM	GROSS WEIGHT EA.	DEDUCTED WEIGHT EA.	NET WEIGHT EA.
20	x1o	PL	1/2	42		1 7 1/4	M270	50W	T		06001	114.63	0.00	114.63
4	x1b	PL	1/2	18		5 1 1/4	M270	50W	T	WIDTH & LENGTH AROUND CURVE	06002	156.32	0.00	156.32
4	x1c	PL	1/2	18		4 1 1/4	M270	50W	T		06003	125.69	0.00	125.69
6	x1d	PL	1/2	16		4 1 1/4	M270	50W	T		06004	111.72	0.00	111.72
6	x1e	PL	1/2	16		3 1 1/4	M270	50W	T		06004	84.50	0.00	84.50
4	x1g	PL	5/8	7		5 1 1/4	M270	50W	T	WIDTH & LENGTH AROUND CURVE	06005	75.99	0.00	75.99
4	x1h	PL	5/8	7		5 1 1/4	M270	50W	T	WIDTH & LENGTH AROUND CURVE	06005	75.99	0.00	75.99
8	x1k	PL	5/8	7		4 1 1/4	M270	50W	T		06006	61.10	0.00	61.10
12	x1m	PL	5/8	6		4 1 1/4	M270	50W	T		06007	52.37	0.00	52.37
4	x1n	PL	5/8	6		3 1 1/4	M270	50W	T		06007	39.61	0.00	39.61
4	x1p	PL	1	18		2 0 1/2	M270	50W	T	FILL PL	06008	125.05	0.00	125.05
6	x1s	PL	1	16		1 6 1/2	M270	50W	T	FILL PL	06009	83.94	0.00	83.94
6	x1t	PL	1/2	16		2 0 1/2	M270	50W	T	FILL PL	06010	55.58	0.00	55.58

2292.6
 625.28
 502.76
 670.32
 507.00
 303.96
 303.96
 488.80
 628.44
 475.32
 500.20
 503.64
 233.48
 813.76
 765

RECEIVED
 OK'D BY: [Signature] OK'D BY: [Signature]
 AUG 18 2008
 RESUBMIT APPROVED [Checkmark]
 BY: KMH DATE: 8/19/08

NO.	REVISION	BY	CHK'D	DATE
GIRDER JOB STANDARDS VT ROUTE 100 (MINOR ARTERIAL) OVER WHITE RIVER VT ROUTE 100 STA. 141+39.00 TO STA. 143+61.00 TOWN OF STOCKBRIDGE, COUNTY OF WINDSOR, VERMONT STATE OF VERMONT AGENCY OF TRANSPORTATION				
SCALE	N.T.S.	STATE CONT. OR REF. NO.	PROJ. NO. (STP)BRF 013-4(211)	FED. AID PROJ. NO.
GENERAL CONTRACTOR	WINTERSET, INC.	HSSI PROJ. MGR	DEB KUPRES	
SHPMNT	1	DRAWING MANAGER	KREIDER (IH)	MADE BY
STATE	VT	HSSI PROJECT NUMBER	S-1080077	HSSI STRUCT. ID
		SSL	CHK'D BY	CS
			DATE	6-18-08
			DRAWING NUMBER	X1 OF X2

FOR SHOP NOTES, SEE DWG. GN1.